
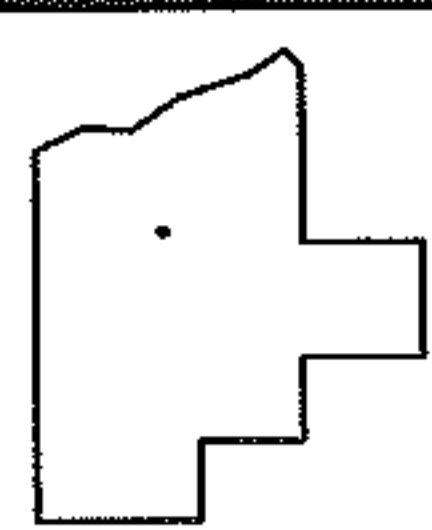
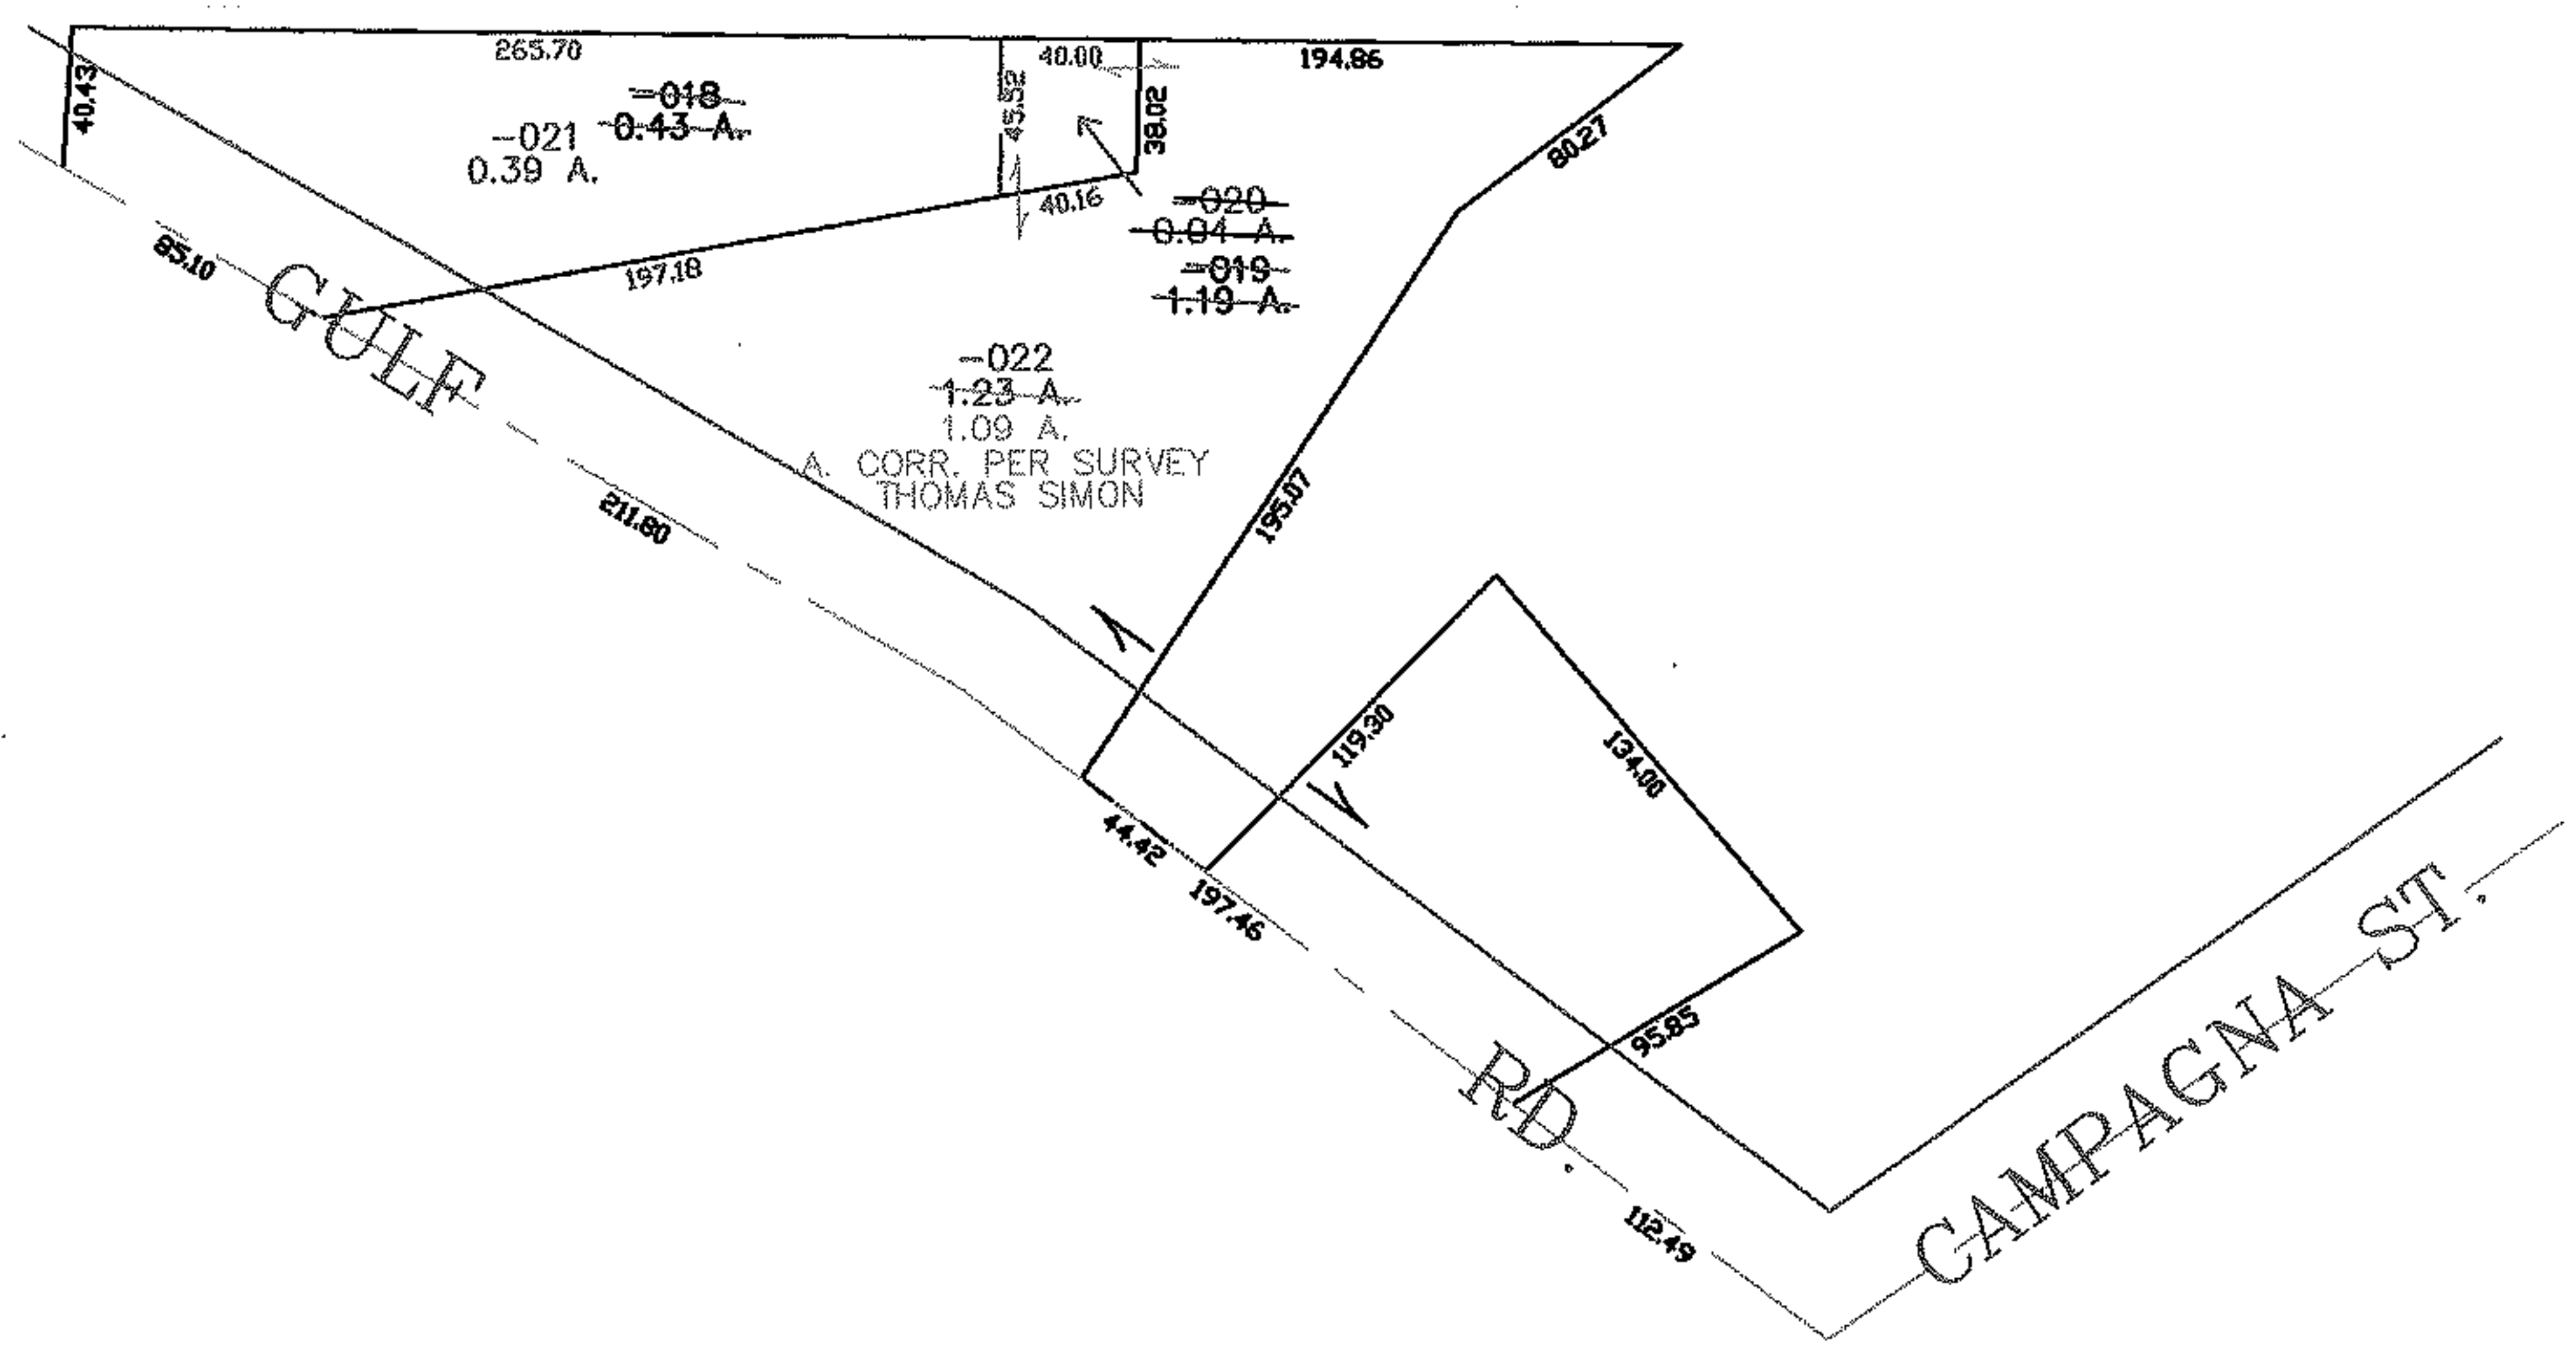


RASTER

PARENT PARCEL: 06-22-008-102-018, -019
CHILD PARCEL: 06-22-008-102-020 THRU -022
STARTING POINT: CENTERLINE OF GULF RD. & CAMPAGNA ST.

05-02016

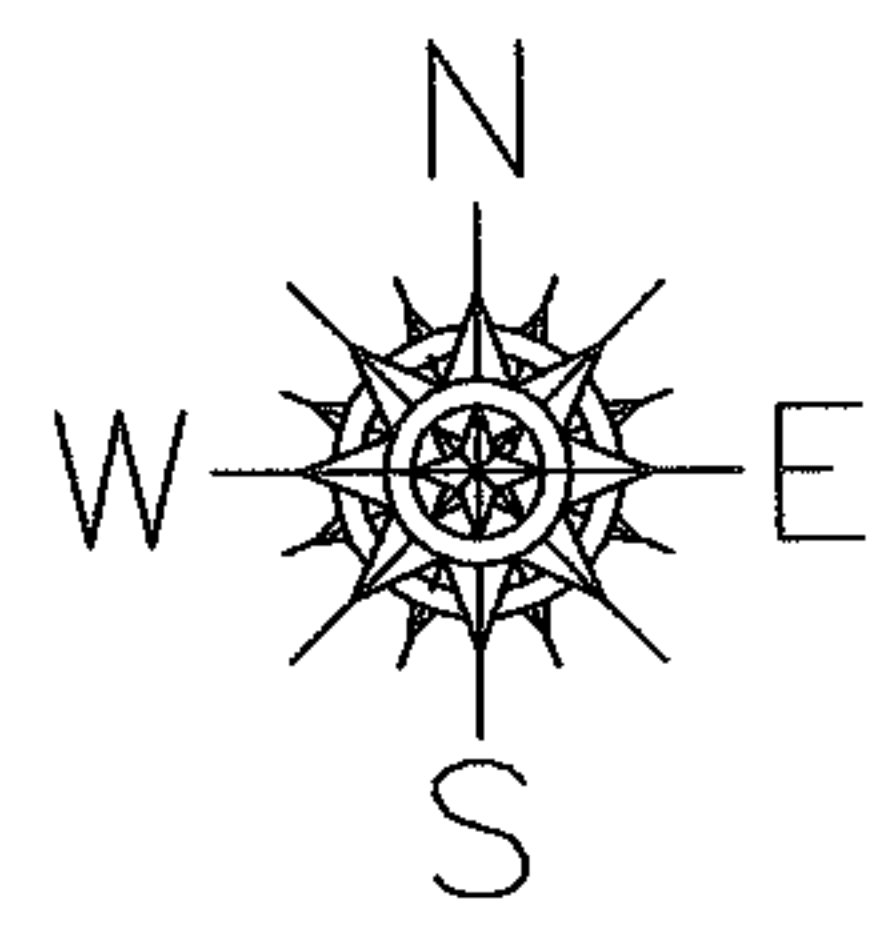

SPLITS/DEEDS PROCESSED

LORAIN COUNTY TAX MAP DEPARTMENT
226 MIDDLE AVE. ELYRIA, OHIO

SURVEYED BY: THOMAS SIMON
CLOSURE: 0.00 : 10.000
MAP PAGE(S): 6-15
APPROVED BY: JAH DATE: 10-4-05
SCALE: 1" = 100 PRIOR INSTRUMENT: 20000706243