
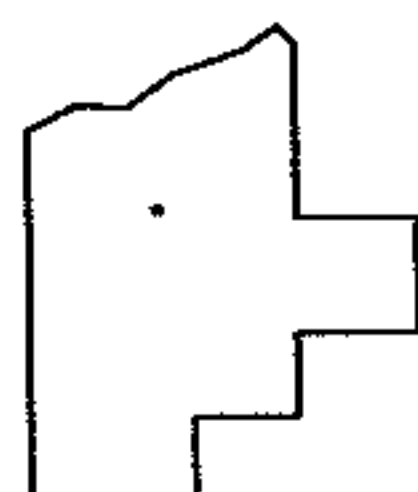
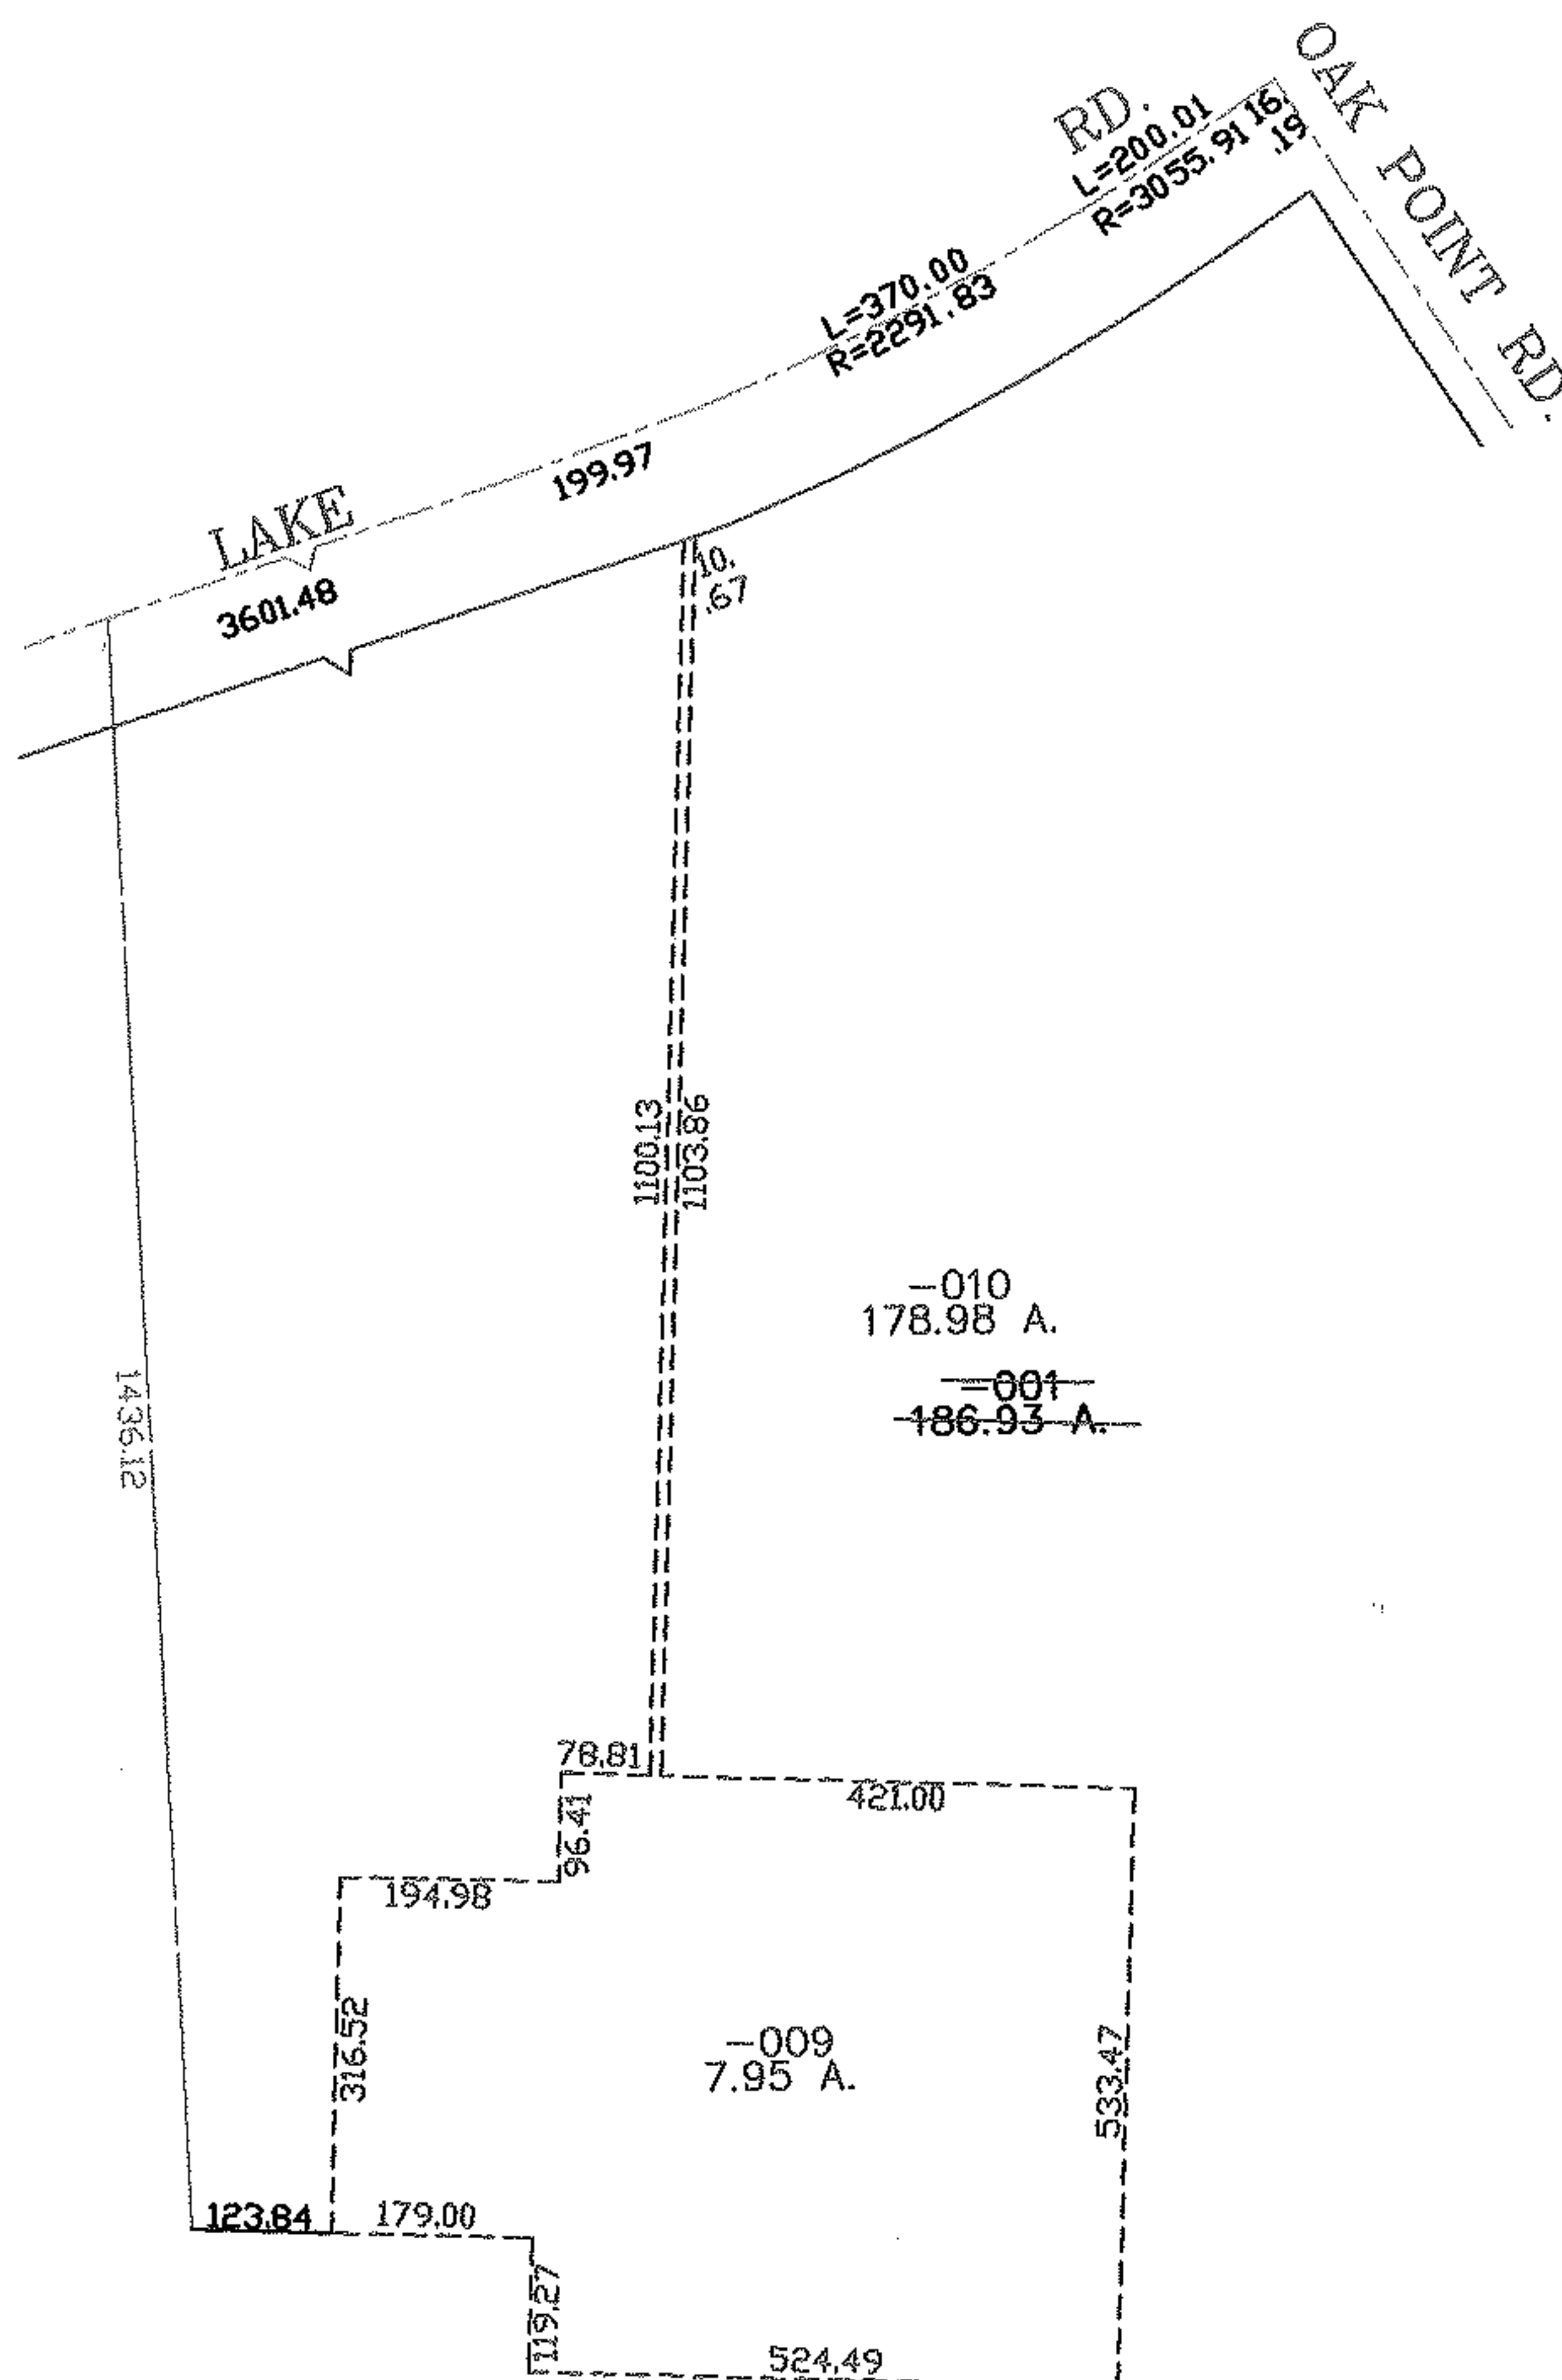


PARENT PARCEL: 02-03-003-000-001

CHILD PARCEL: 02-03-003-000-009, -010

STARTING POINT: CENTERLINE OF LAKE RD. & OAK POIN RD.

05-02017

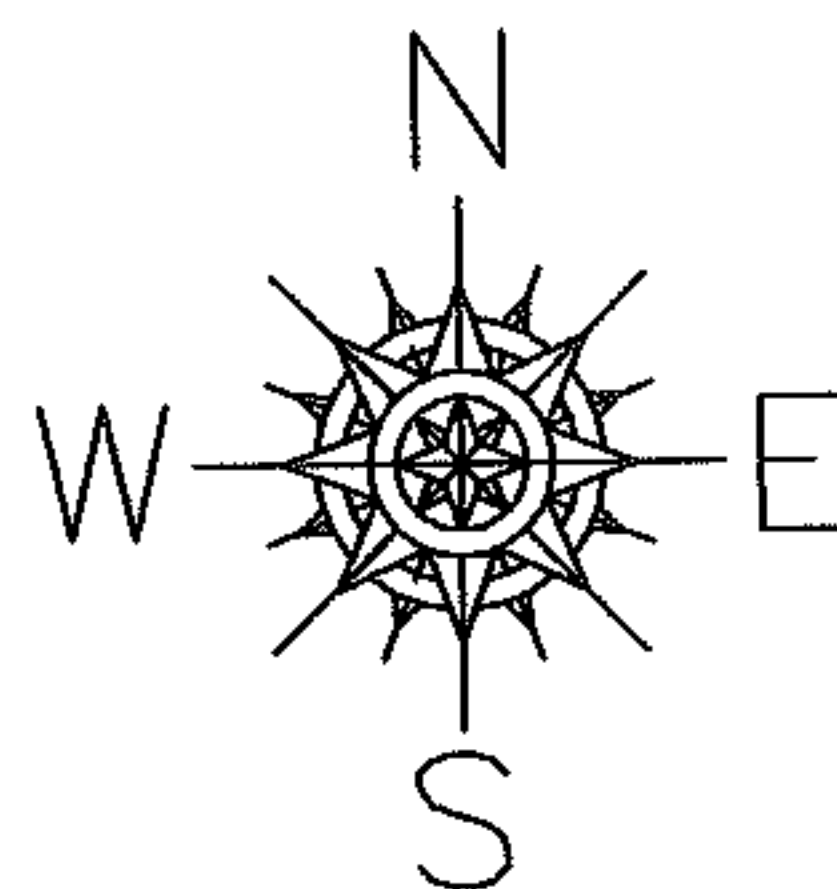

SPLITS/DEEDS PROCESSED
 LORAIN COUNTY TAX MAP DEPARTMENT
 226 MIDDLE AVE. ELYRIA, OHIO

SURVEYED BY: CHRISTOPHER HIRZEL
 CLOSURE: 0.00 : 10.000
 MAP PAGE(S): 2-E
 APPROVED BY: JAH DATE: 10-5-05
 SCALE: 1" = 300 PRIOR INSTRUMENT: DV 637/76