
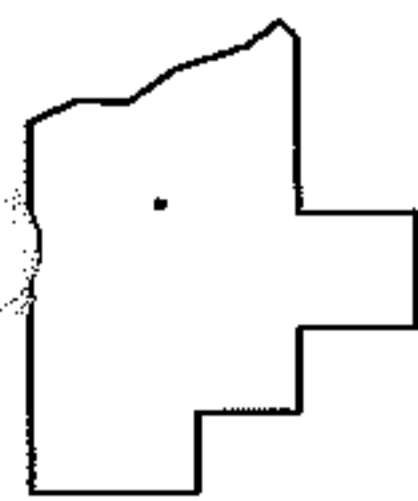
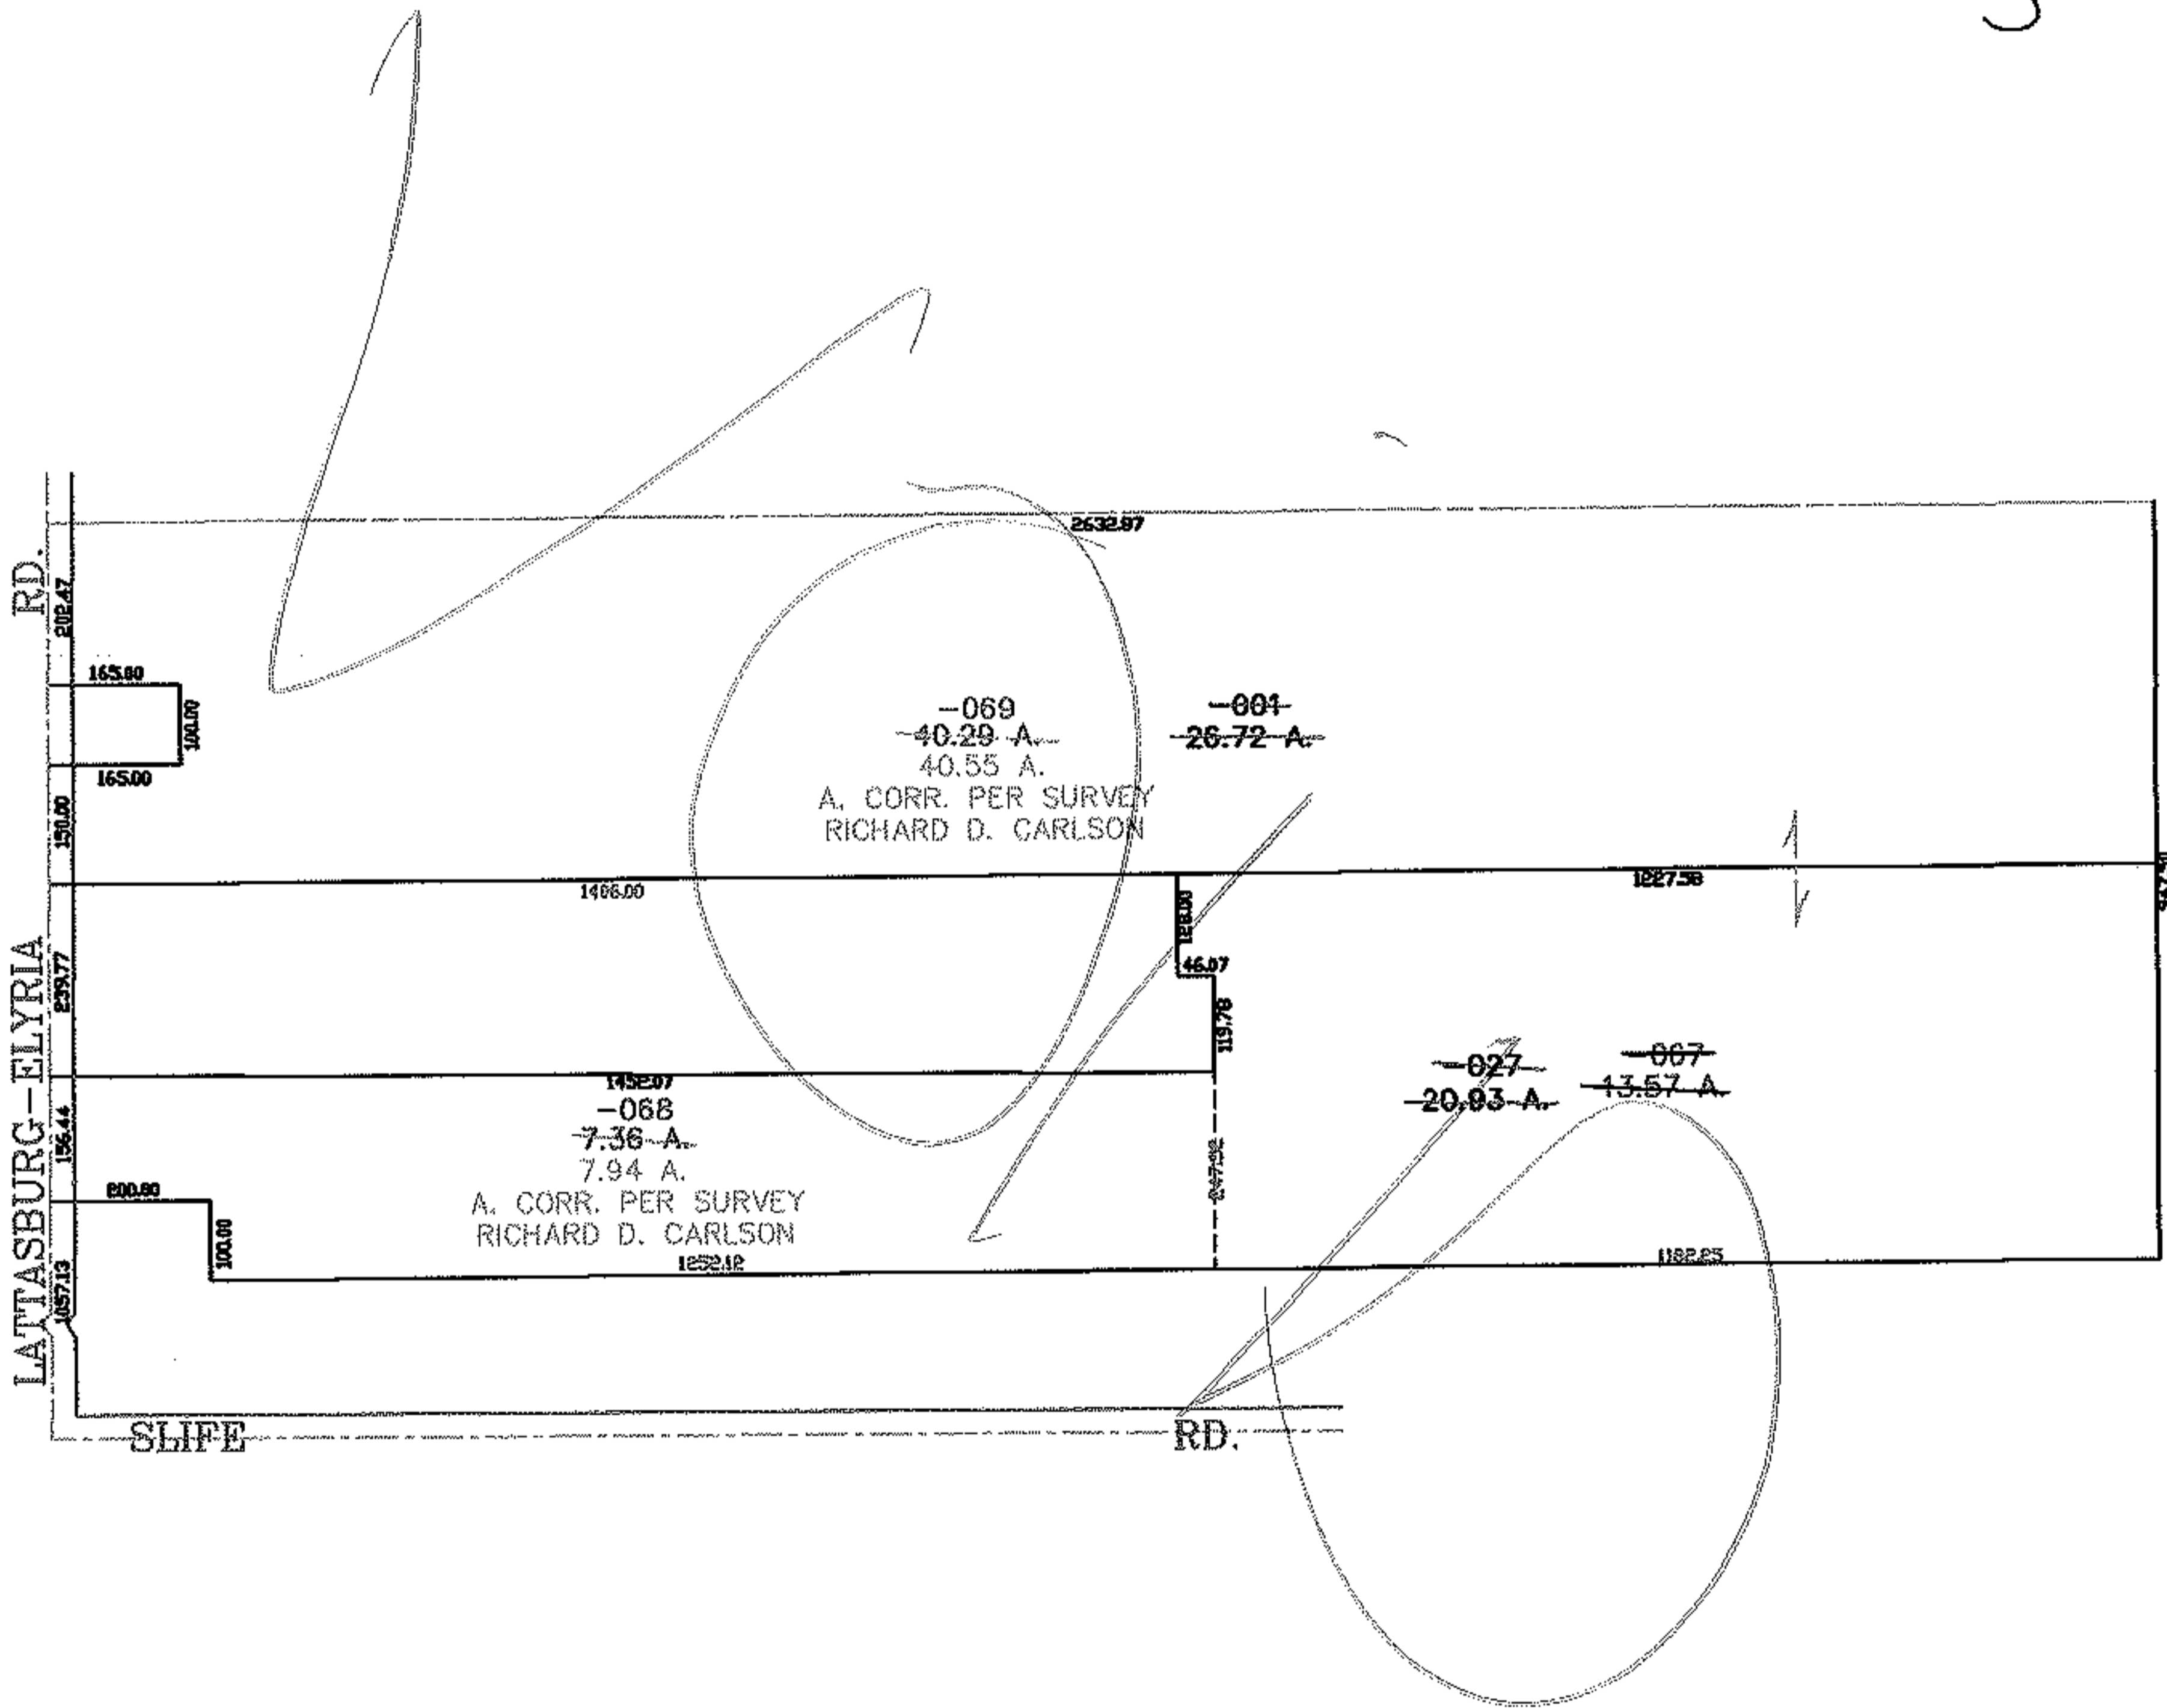


PARENT PARCEL: 10-00-018-102-027, -001

CHILD PARCEL: 10-00-018-102-067 THRU -069

STARTING POINT: CENTERLINE OF SLIFE RD. & LATTASBURG-ELYRIA RD

05-02020

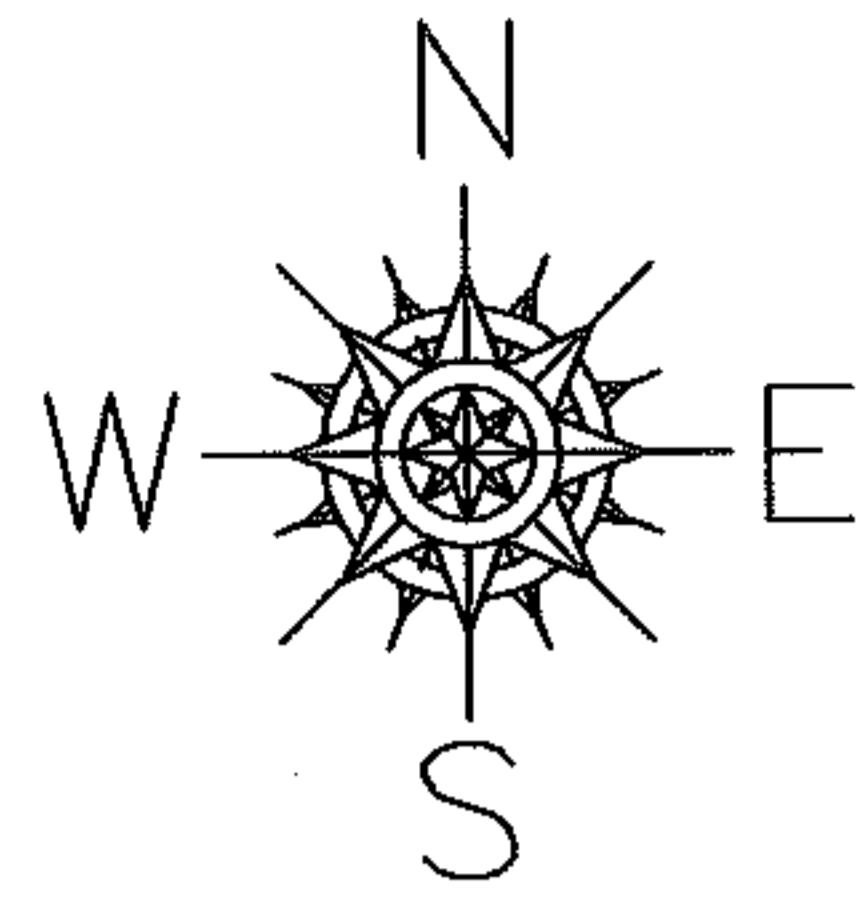

SPLITS/DEEDS PROCESSED

LORAIN COUNTY TAX MAP DEPARTMENT
226 MIDDLE AVE. ELYRIA, OHIO

SURVEYED BY: RICHARD CARLSON

CLOSURE: 0.00 : 10,000

MAP PAGE(S): 10-G

APPROVED BY: JAH DATE: 10-13-05

SCALE: 1" = 400 PRIOR INSTRUMENT: 20020873318