


PARENT PARCEL: 03-00-067-000-014

CHILD PARCEL: XX-XX-XXX-XXX-XXX

STARTING POINT: XXXXXX

10-02024-C

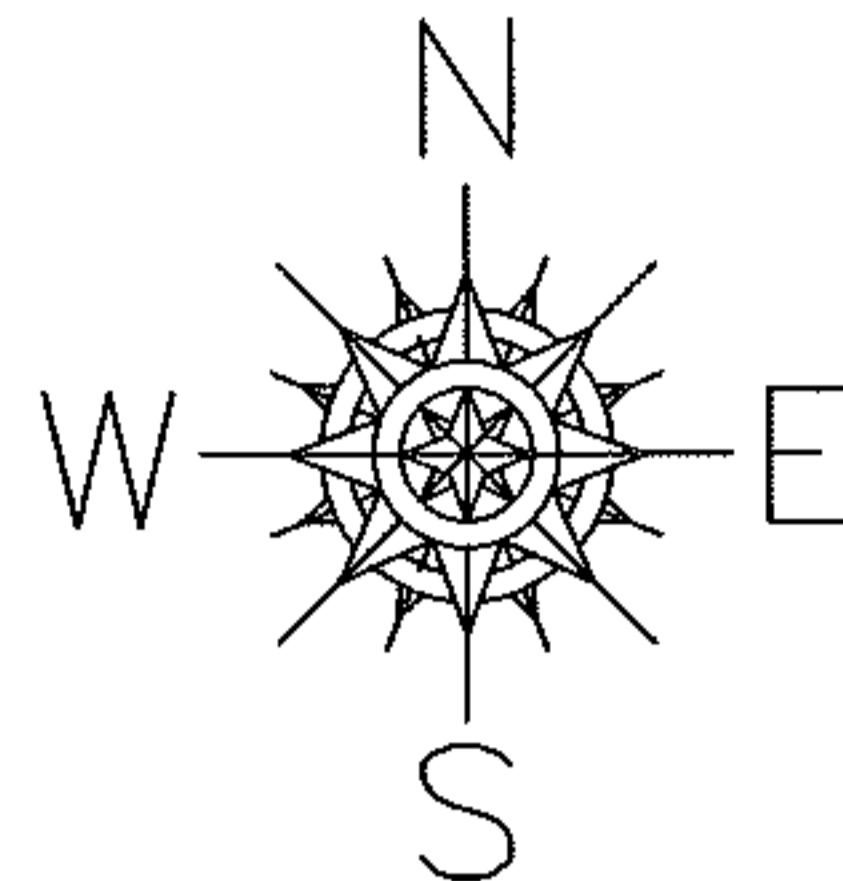

## ACREAGE CORRECTION


03-00-067-000-014

~~2.61~~ A.

5.00 A.

CORR. PER DEED

OR 572/583

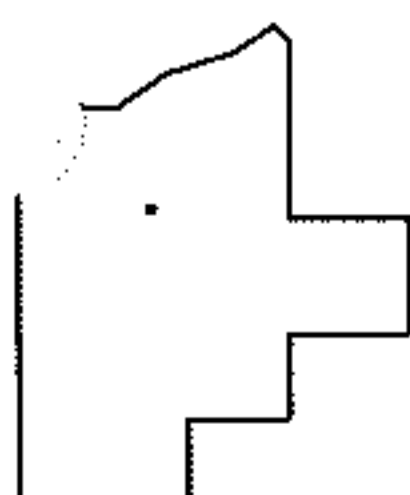

### SPLITS/DEEDS PROCESSED

LORAIN COUNTY TAX MAP DEPARTMENT  
226 MIDDLE AVE. ELYRIA, OHIO

SURVEYED BY: XXXXXXXXXXXX

CLOSURE: XXXXXX

MAP PAGE(S): 3-K & 3-00-068-A

APPROVED BY: TJS DATE: 4/28/10

SCALE: 1" = 100' PRIOR INSTRUMENT: OR 572/583