


RASTER

PARENT PARCEL: 04-00-025-000-354


CHILD PARCEL: 04-00-025-000-444 THRU -447

STARTING POINT: SOUTHEASTERLY CORNER OF S/L 11 OF AUGUSTA WOODS SUBD.

05-02024

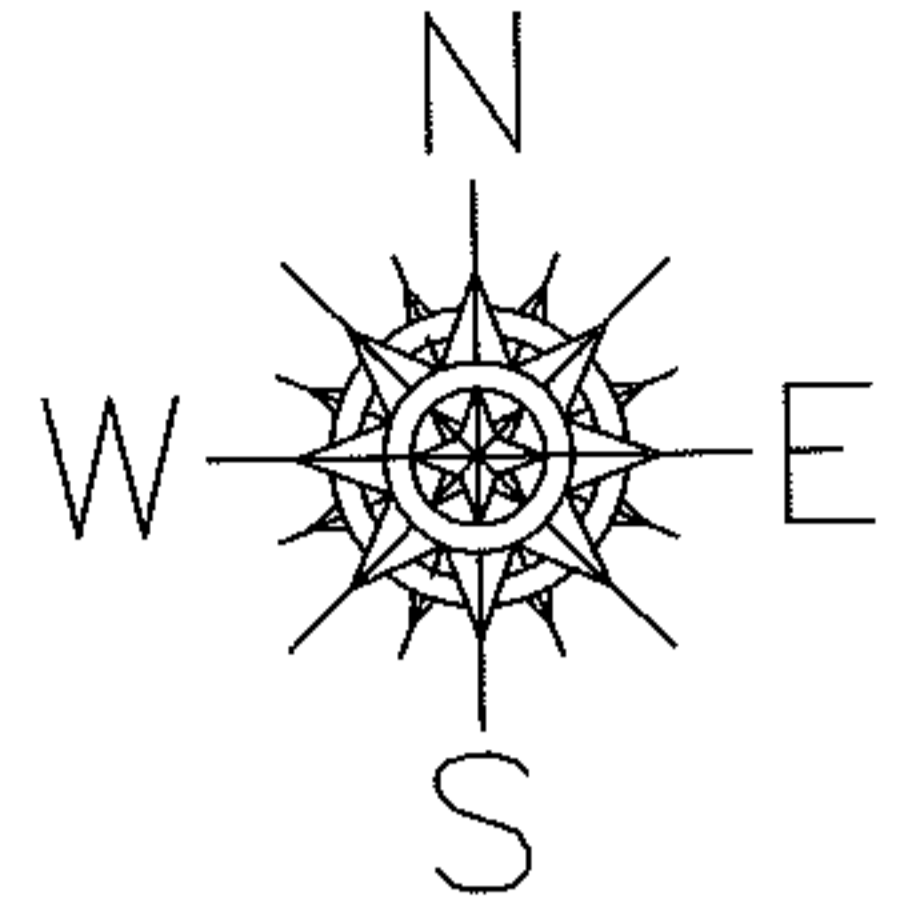

AUGUSTA WOODS SUBD.
VOL 77 PG 45-47

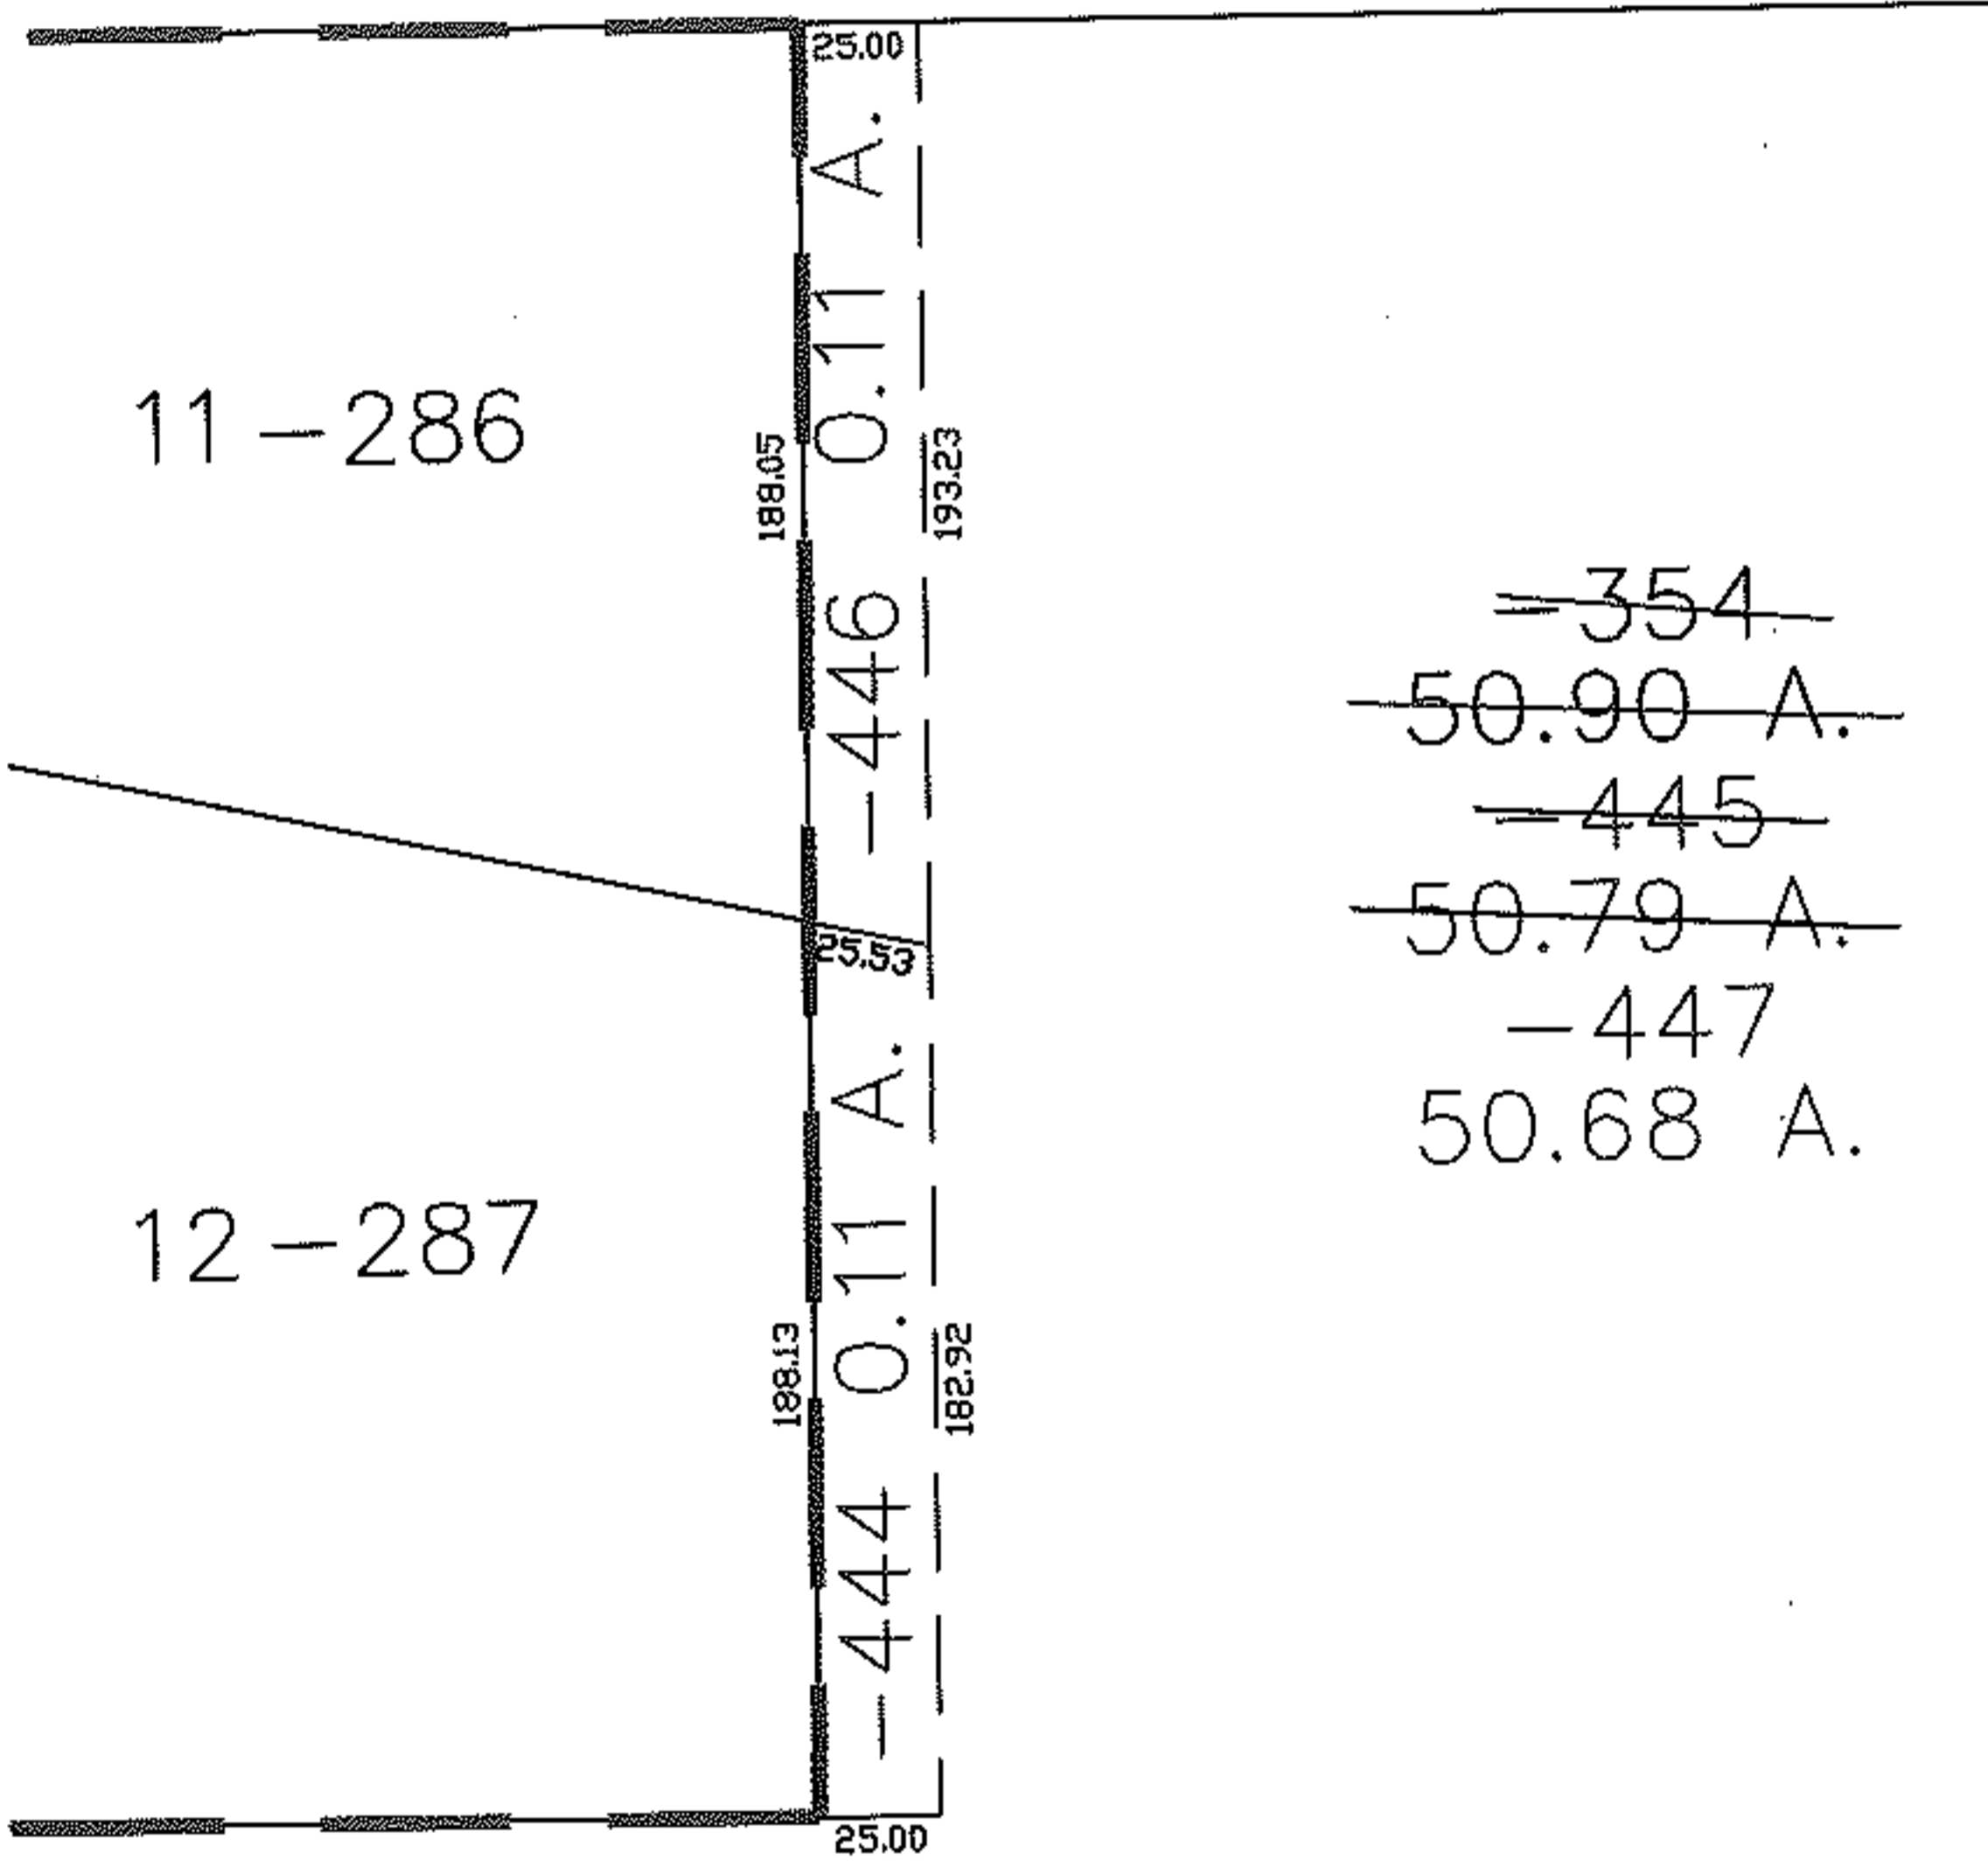

~~354~~
~~50.90 A.~~
~~445~~
~~50.79 A.~~
~~447~~
50.68 A.

SPLITS/DEEDS PROCESSED

LORAIN COUNTY TAX MAP DEPARTMENT
226 MIDDLE AVE. ELYRIA, OHIO

SURVEYED BY: MICHAEL P. SPELLACY

CLOSURE: 0.00 : 10.000

MAP PAGE(S): 04-00-025-B

APPROVED BY: JAH DATE: 10-18-05

SCALE: 1" = 100 PRIOR INSTRUMENT: 20050091161