


PARENT PARCEL: 03-00-106-114-063

CHILD PARCEL: _____

STARTING POINT: S/L 29 IN BLOCK 18 OF CENTRAL DIVISION (VOL.9 PG.5)

10-02025-C

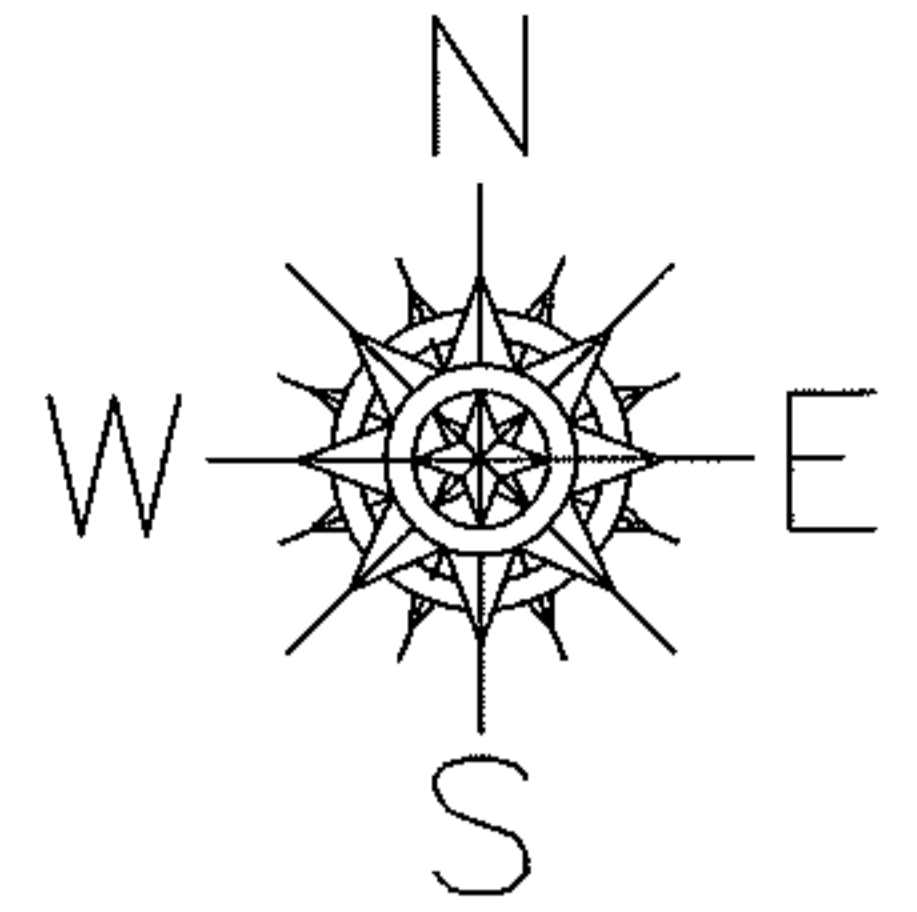



DEPTH CORRECTION

03-00-106-114-063

30 X 107.50

~~30 X 100~~

PER COURT CASE 10TX006179

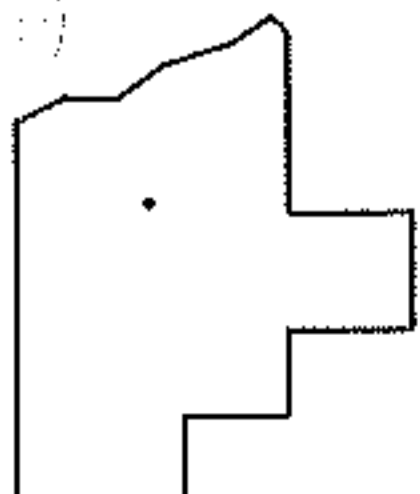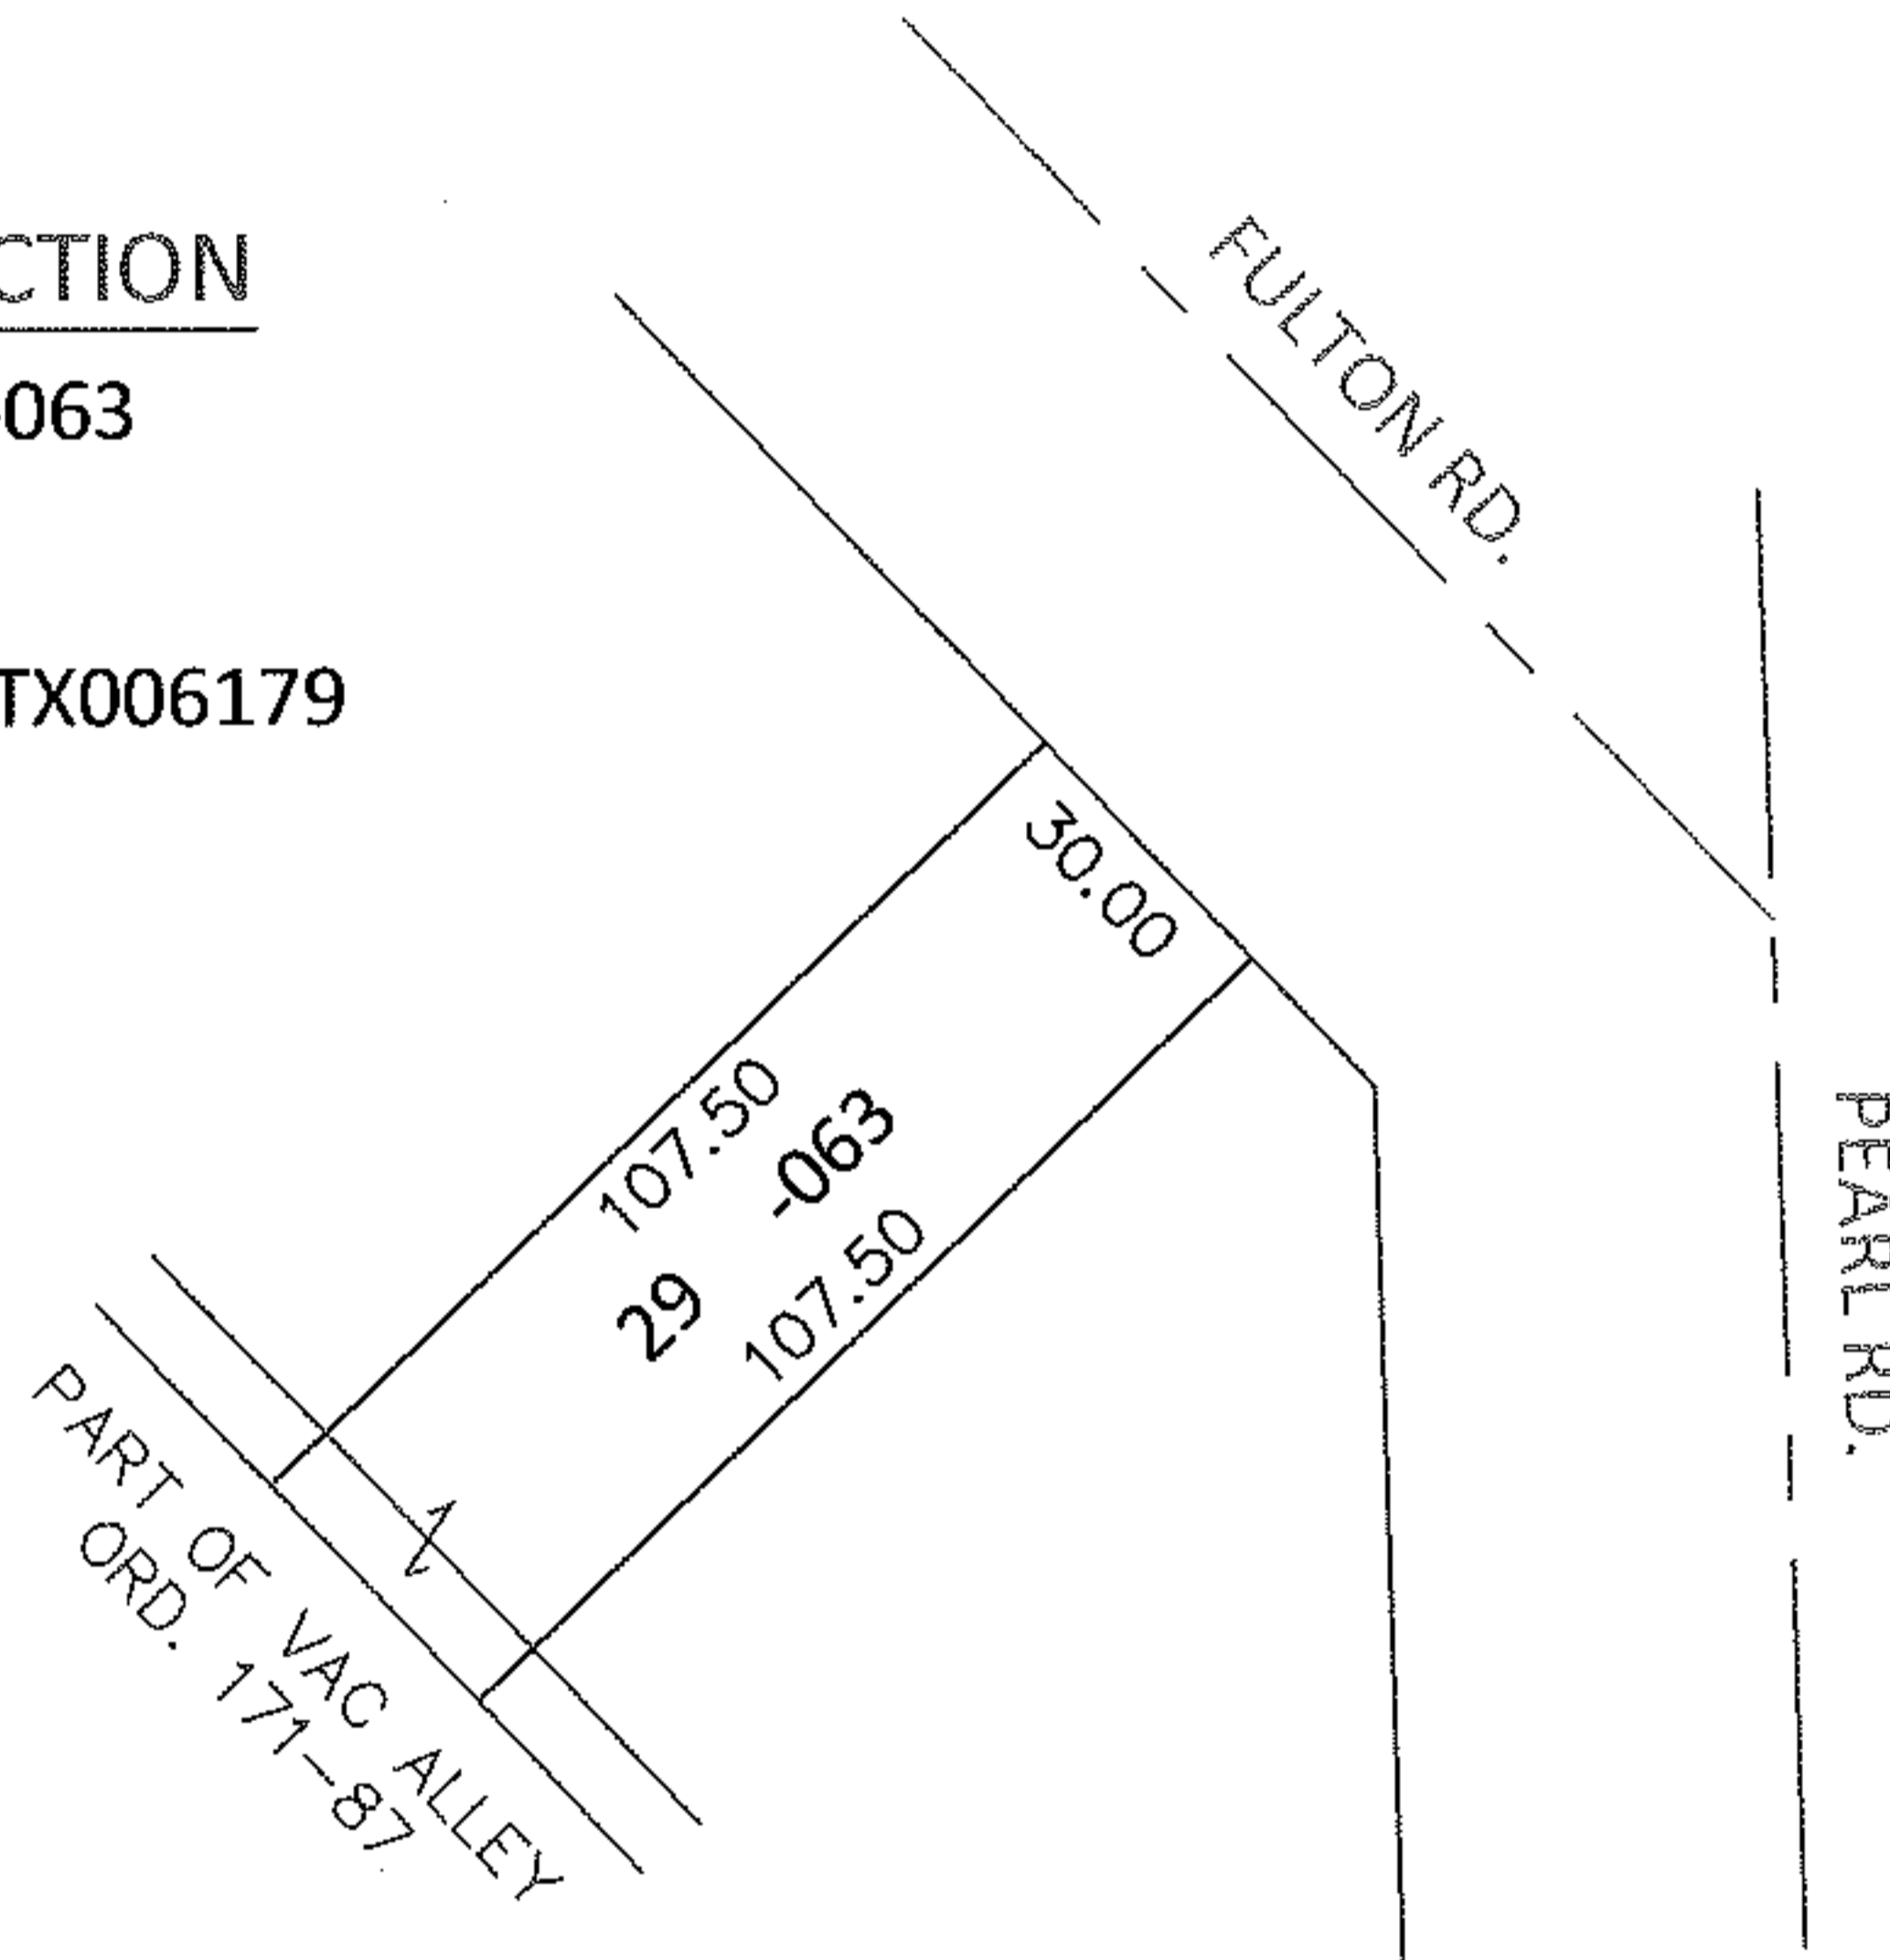

SPLITS/DEEDS PROCESSED

LORAIN COUNTY TAX MAP DEPARTMENT
226 MIDDLE AVE. ELYRIA, OHIO

SURVEYED BY: N/A

CLOSURE: N/A

MAP PAGE(S): 3-00-106-B

APPROVED BY: RRM DATE: 5/4/10

SCALE: 1" = 50' PRIOR INST.: ES439685