
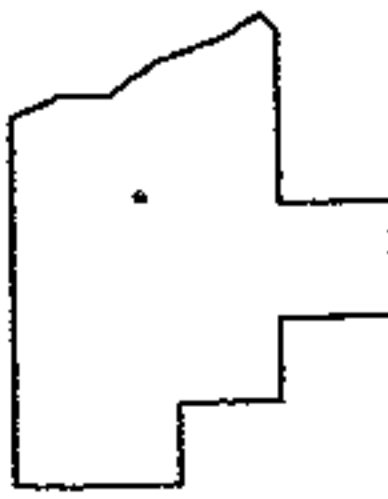
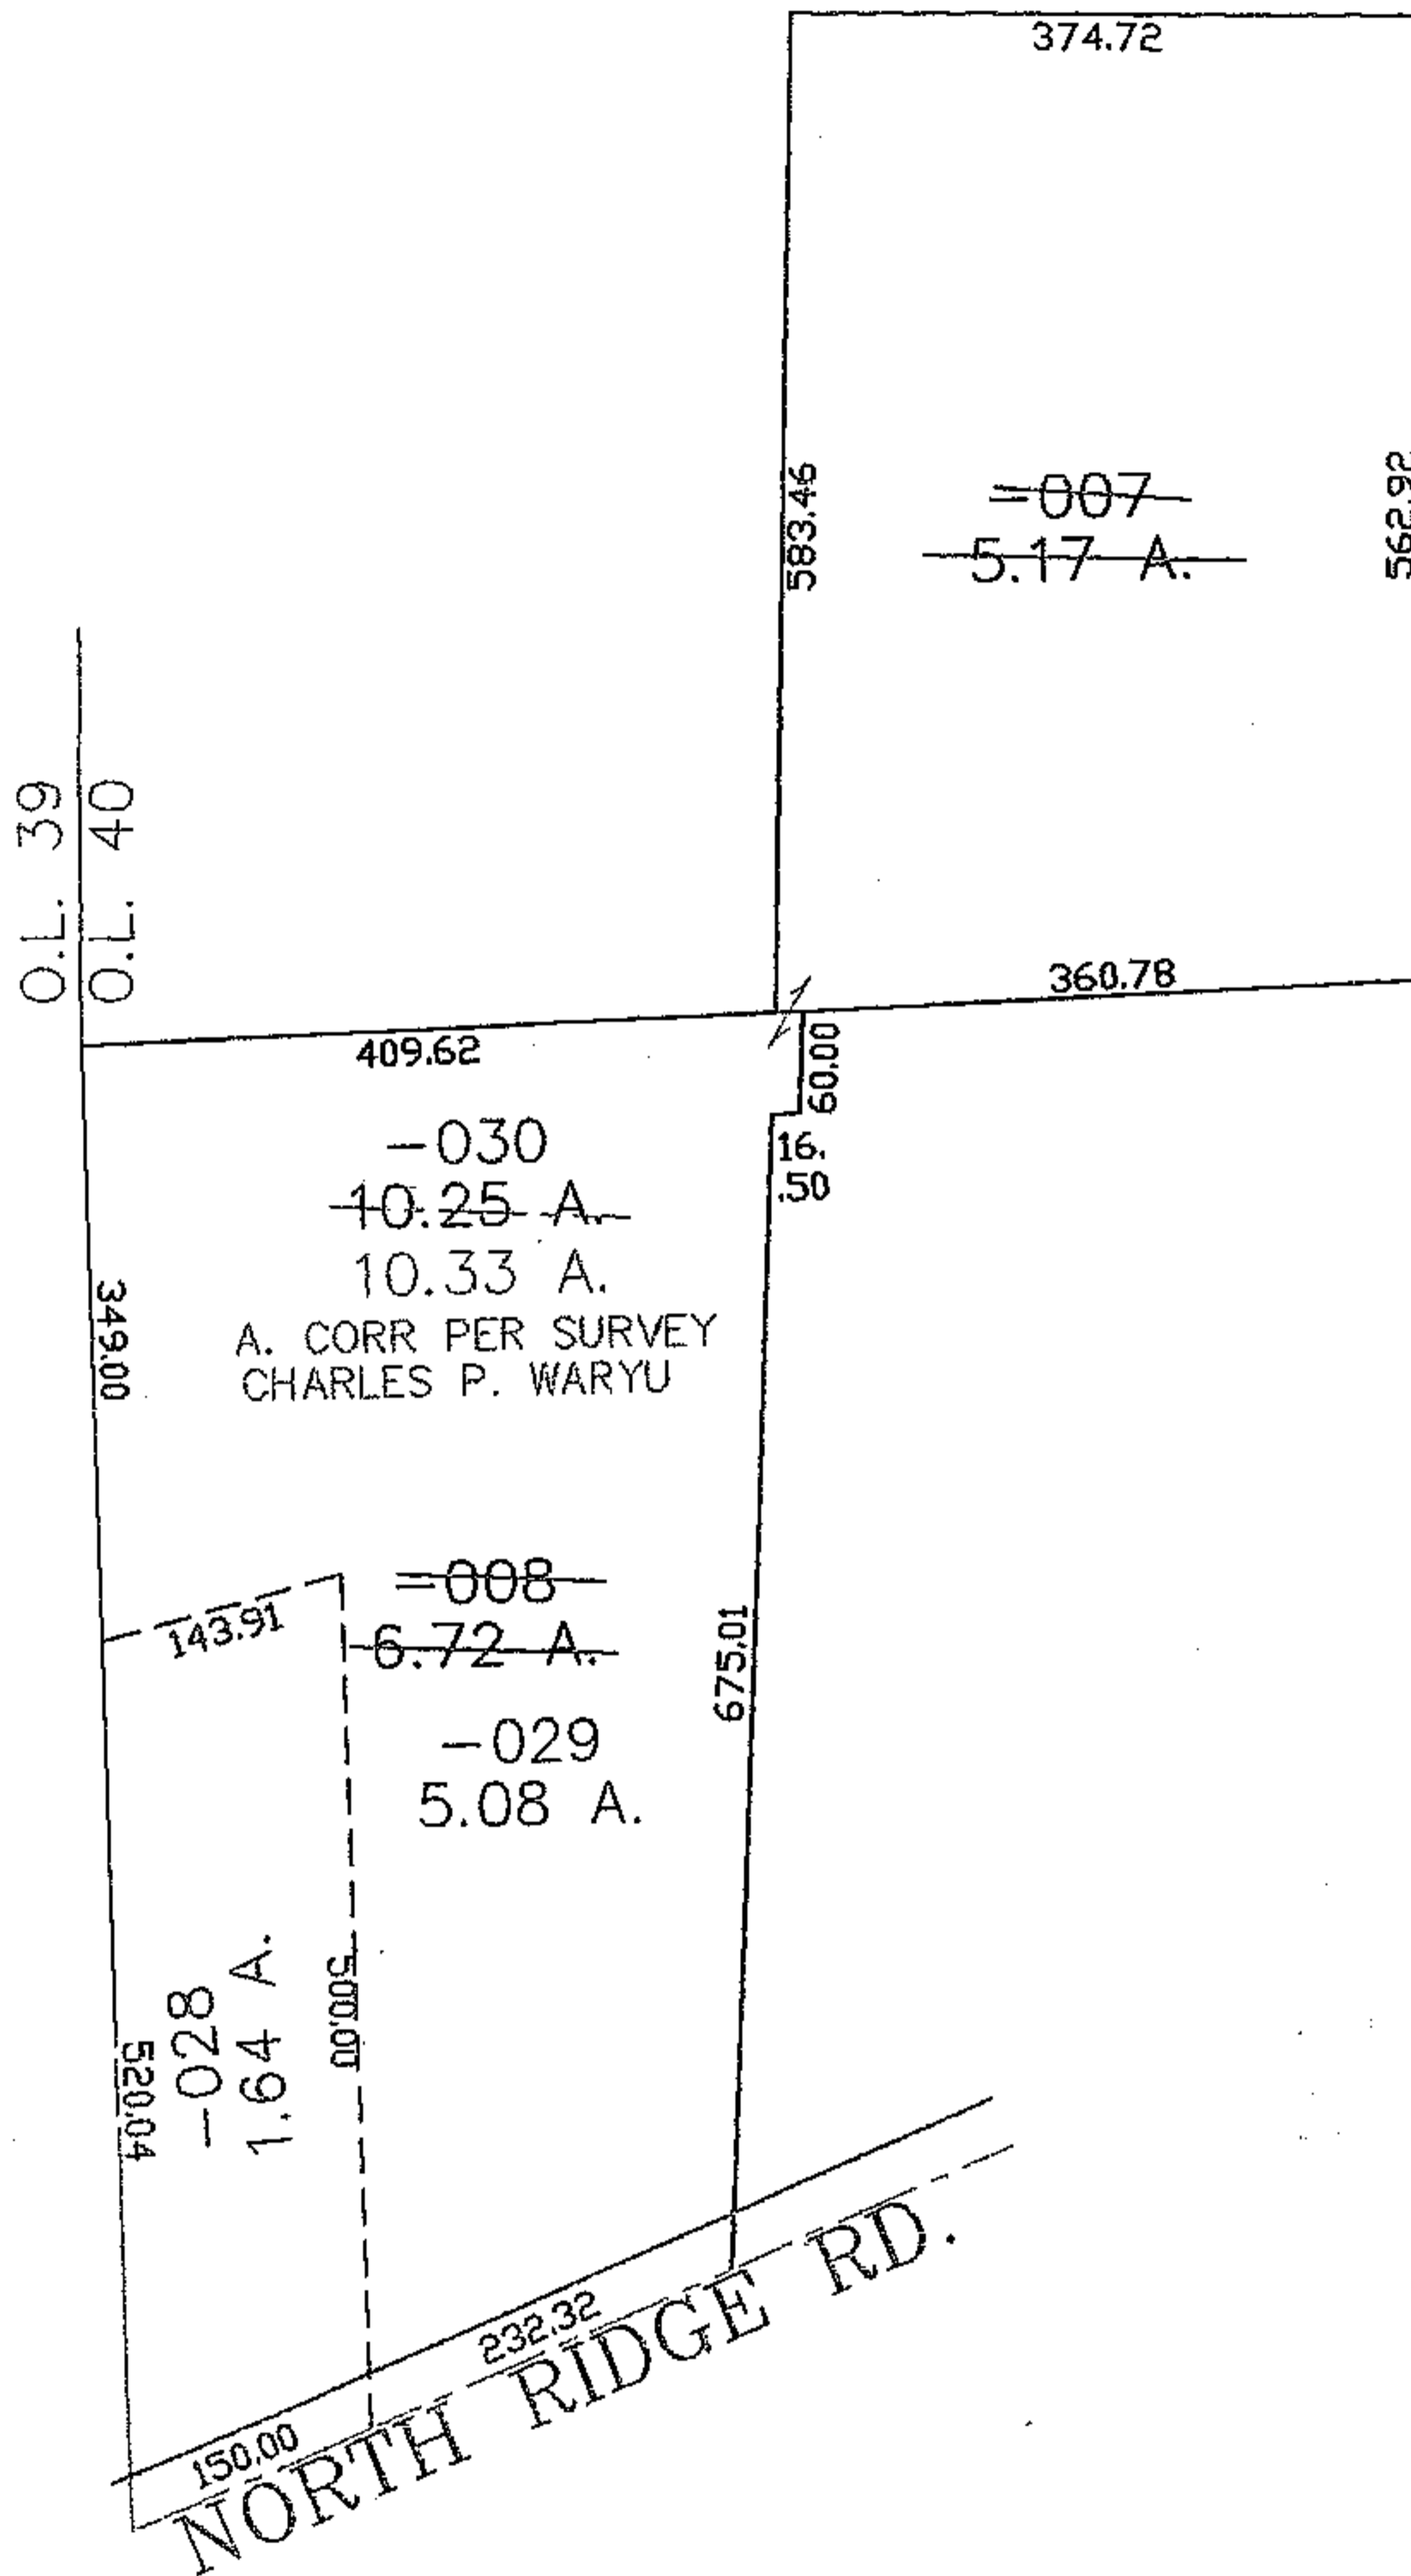


RASTER

05-02025

PARENT PARCEL: 01-00-040-000-007, -008  
CHILD PARCEL: 01-00-040-000-028 THRU -030  
STARTING POINT: CENTERLINE OF NORTH RIDGE RD. & O.L. 40

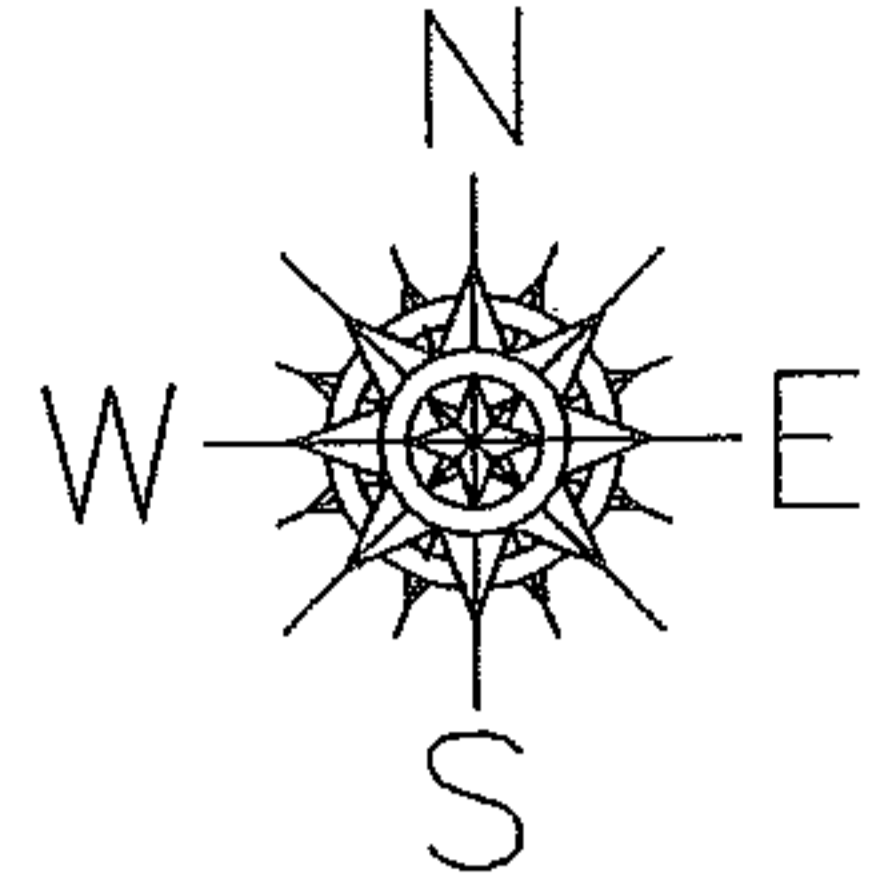

**SPLITS/DEEDS PROCESSED**  
LORAIN COUNTY TAX MAP DEPARTMENT  
226 MIDDLE AVE. ELYRIA, OHIO

SURVEYED BY: CHARLES WARYU  
CLOSURE: 0.00 : 10,000  
MAP PAGE(S): 1-H  
APPROVED BY: JAH DATE: 10-18-05  
SCALE: 1" = 200' PRIOR INSTRUMENT: 20000691951

R