
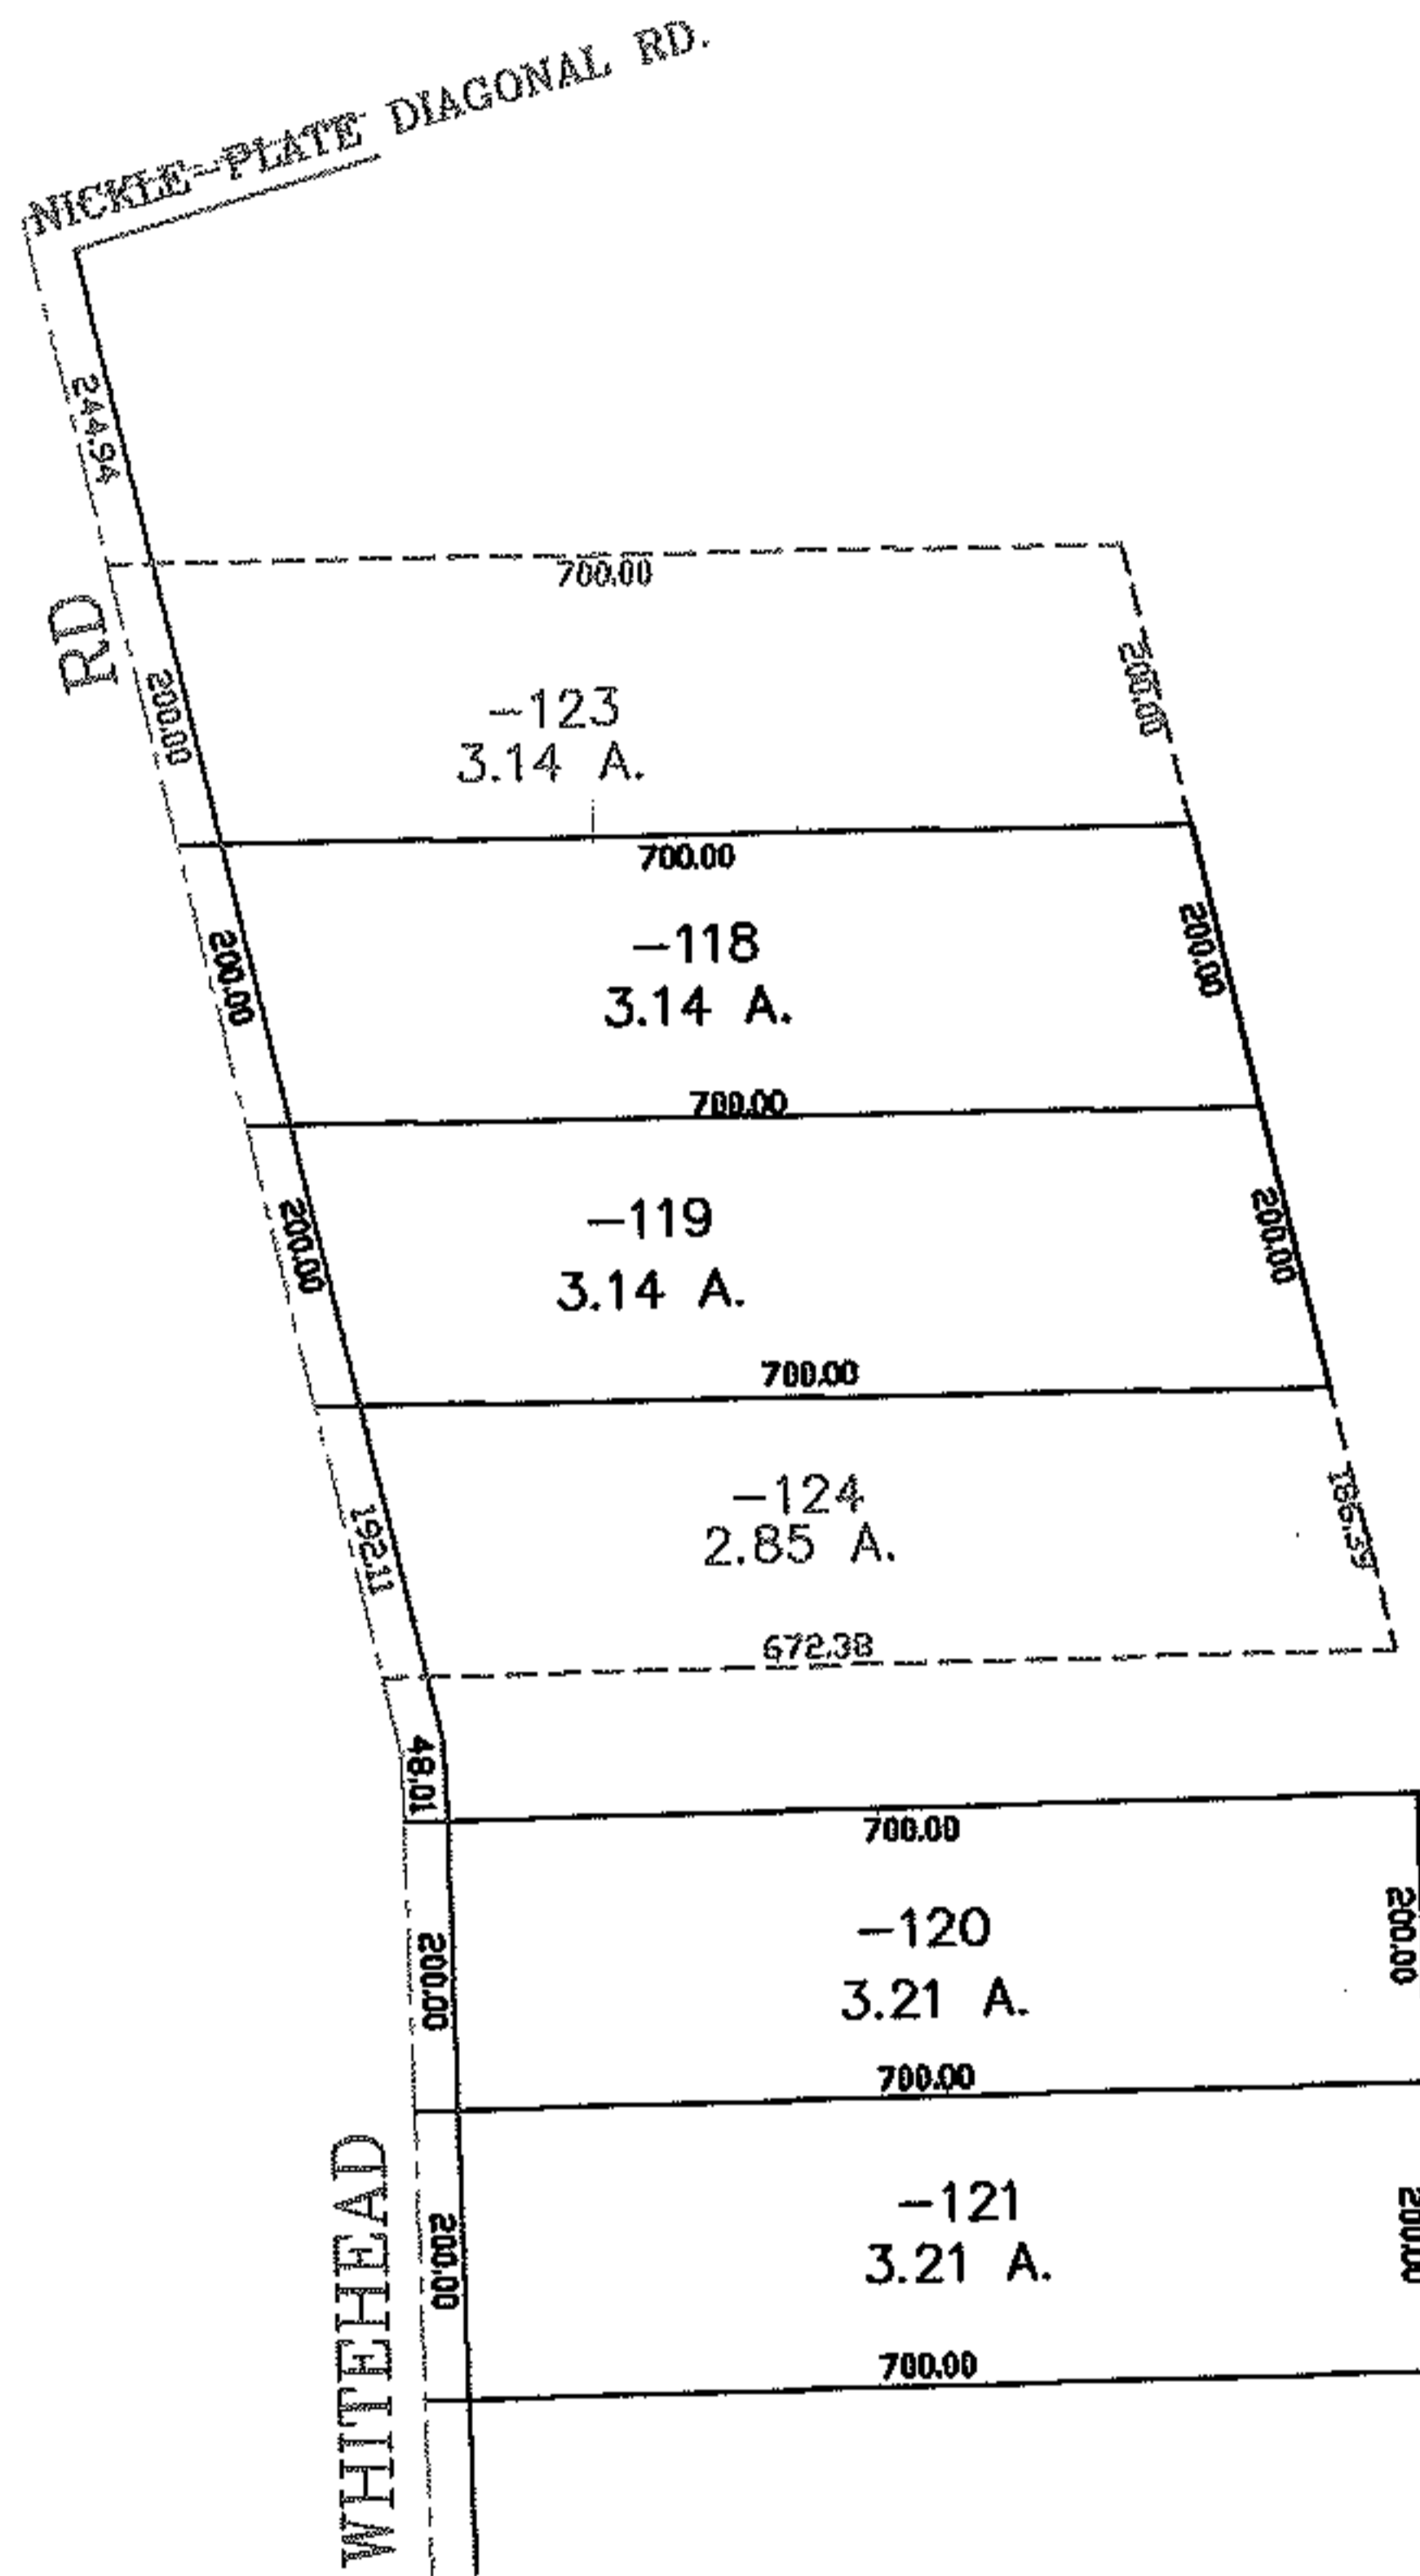


PARENT PARCEL: 10-00-019-000-122


CHILD PARCEL: 10-00-019-000-123 THRU -125

STARTING POINT: CENTERLINE OF WHITEHEAD RD. & NICKLE-PLATE DIAGONAL RD.

05-02027

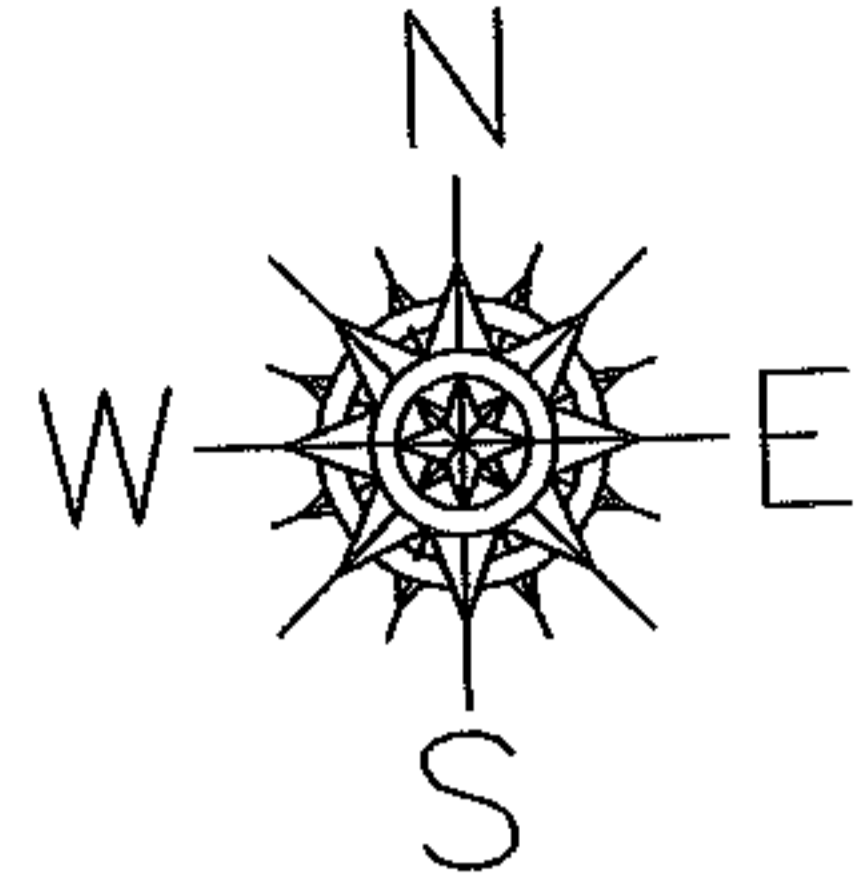

~~-122~~  
~~58.28 A.~~  
~~-125~~  
 52.29 A.

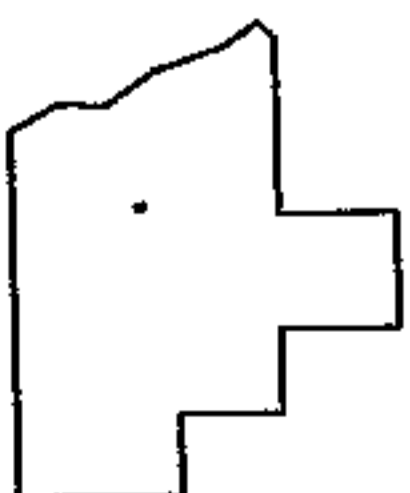

**SPLITS/DEEDS PROCESSED**  
 LORAIN COUNTY TAX MAP DEPARTMENT  
 226 MIDDLE AVE. ELYRIA, OHIO

SURVEYED BY: RICHARD CARLSON

CLOSURE: 0.00 : 10.000

MAP PAGE(S): 10-00-019-H

APPROVED BY: JAH DATE: 10-20-05

SCALE: 1" = 300 PRIOR INSTRUMENT: OR 244/235