
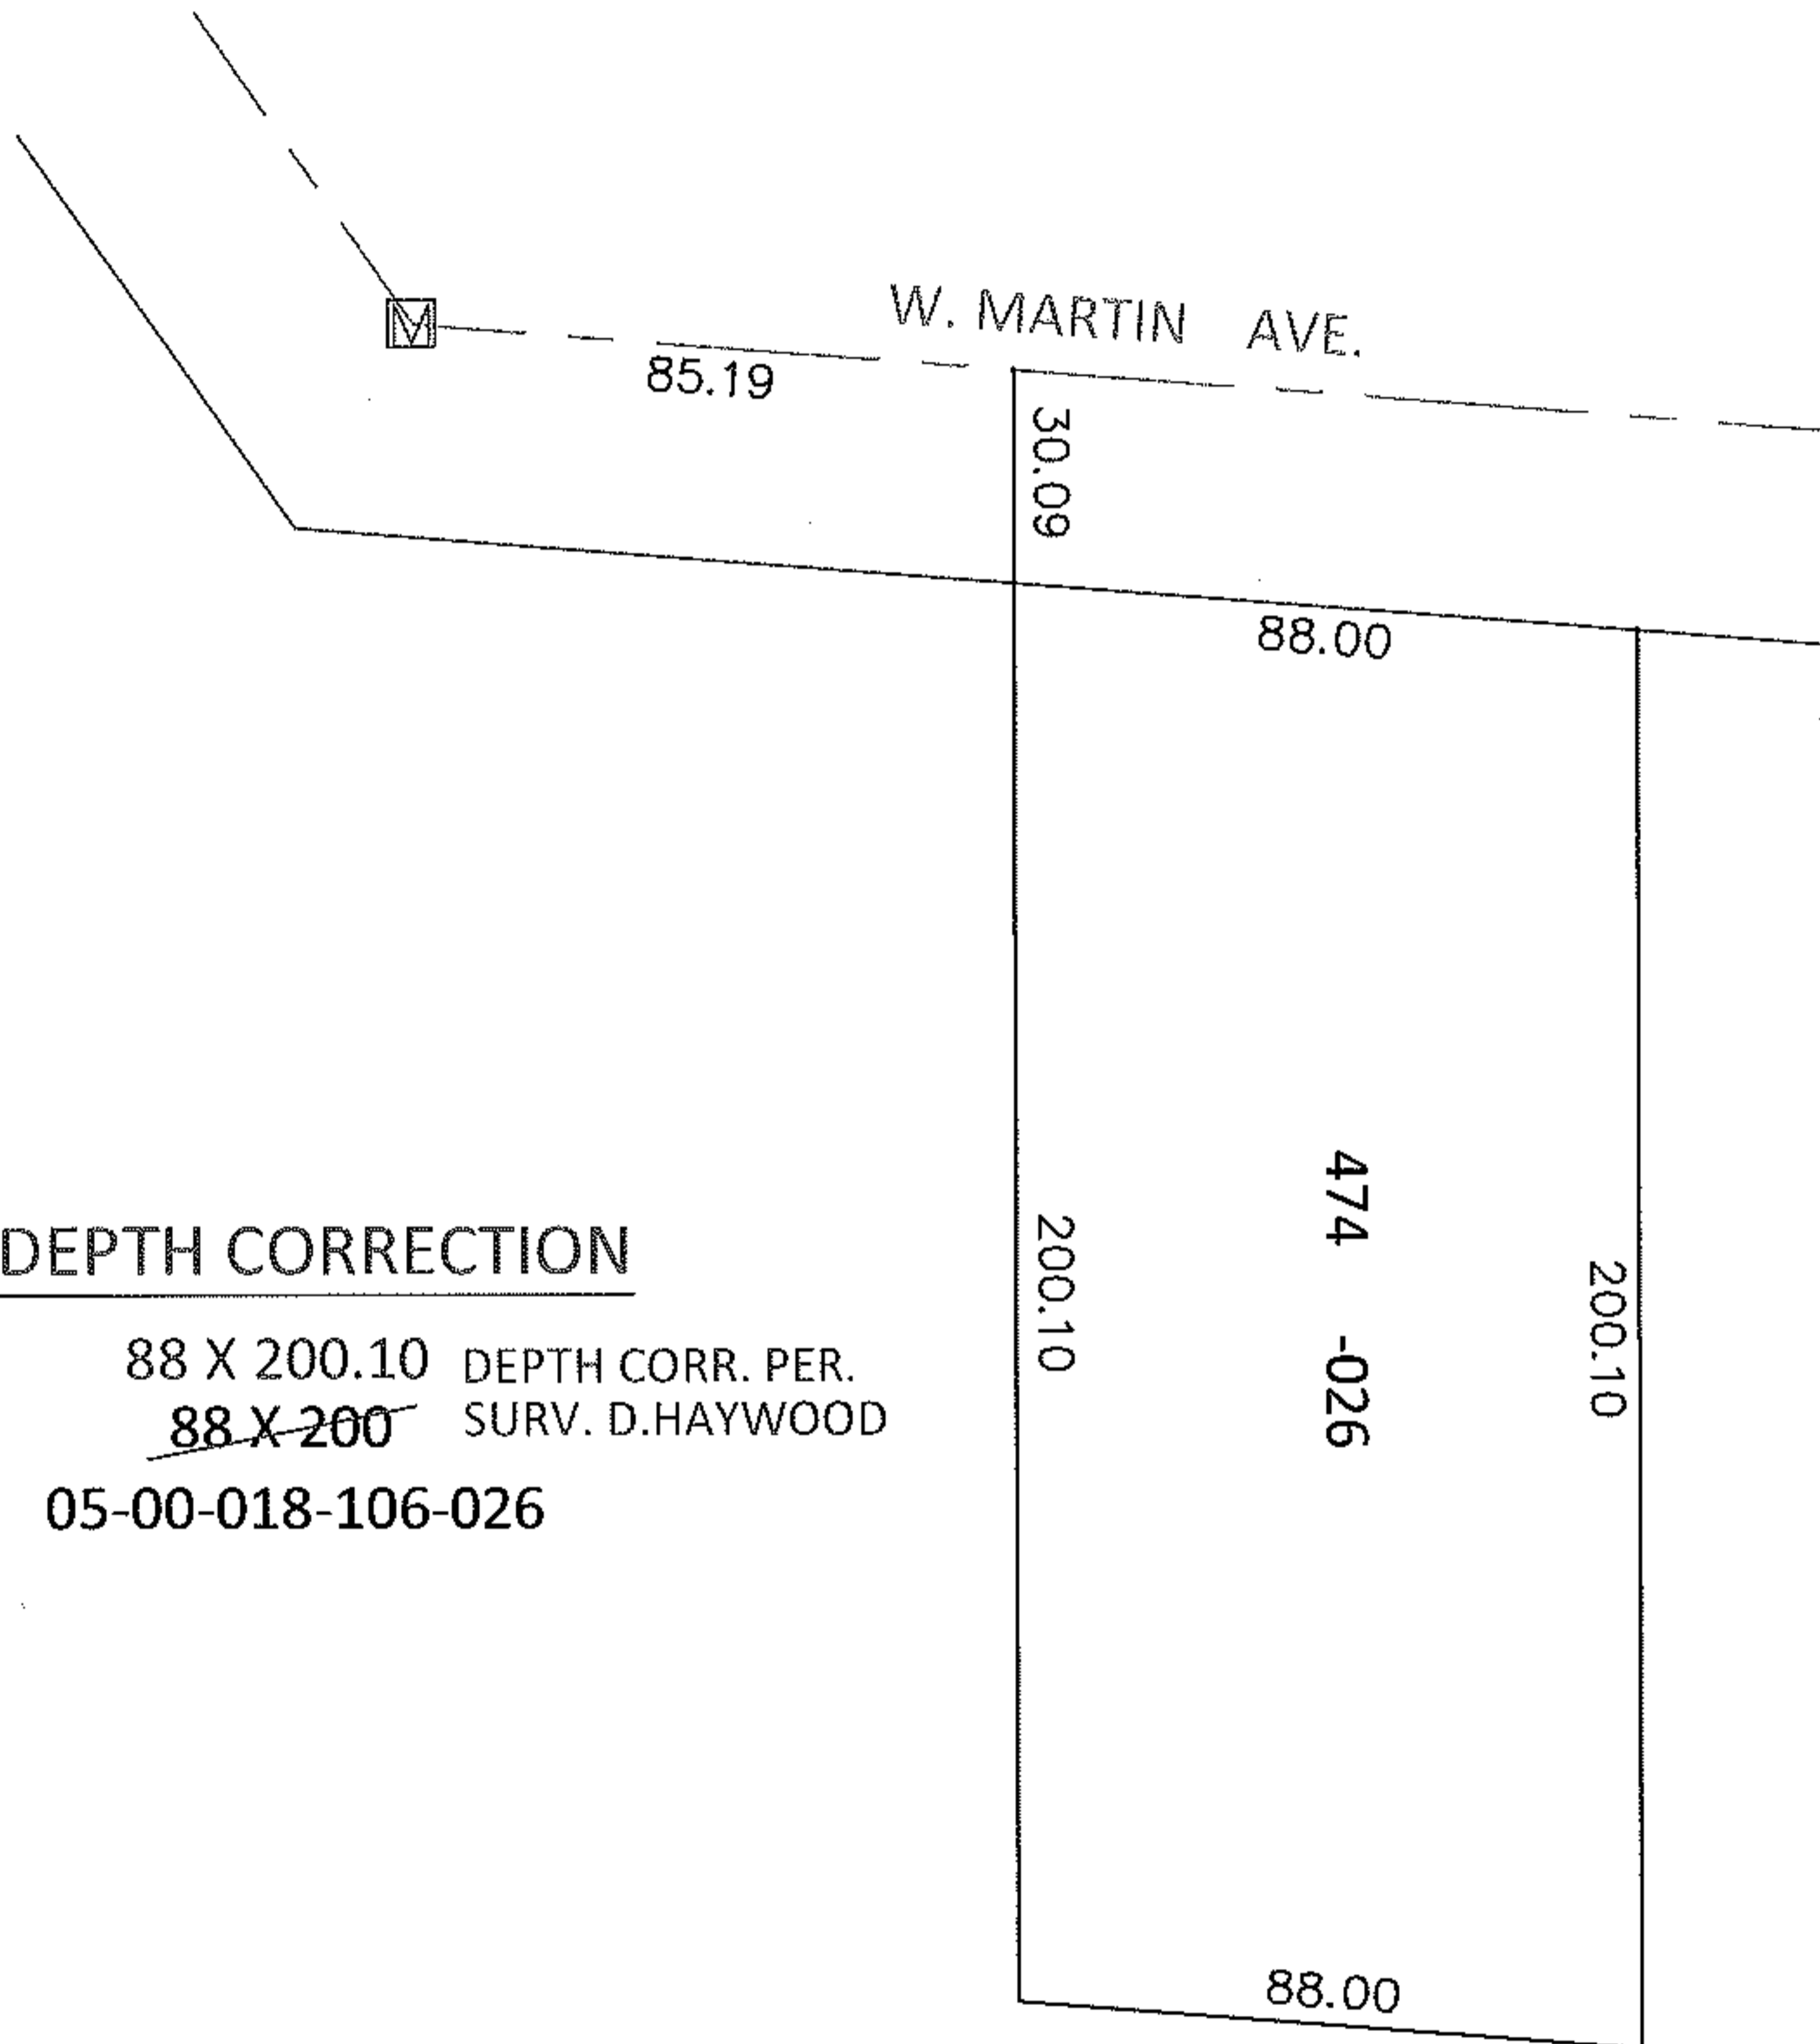


PARENT PARCEL: 05-00-018-106-026

CHILD PARCEL: \_\_\_\_\_


10-02027-C

STARTING POINT: AT MON BOX IN THE C/L OF W. MARTIN AVE.

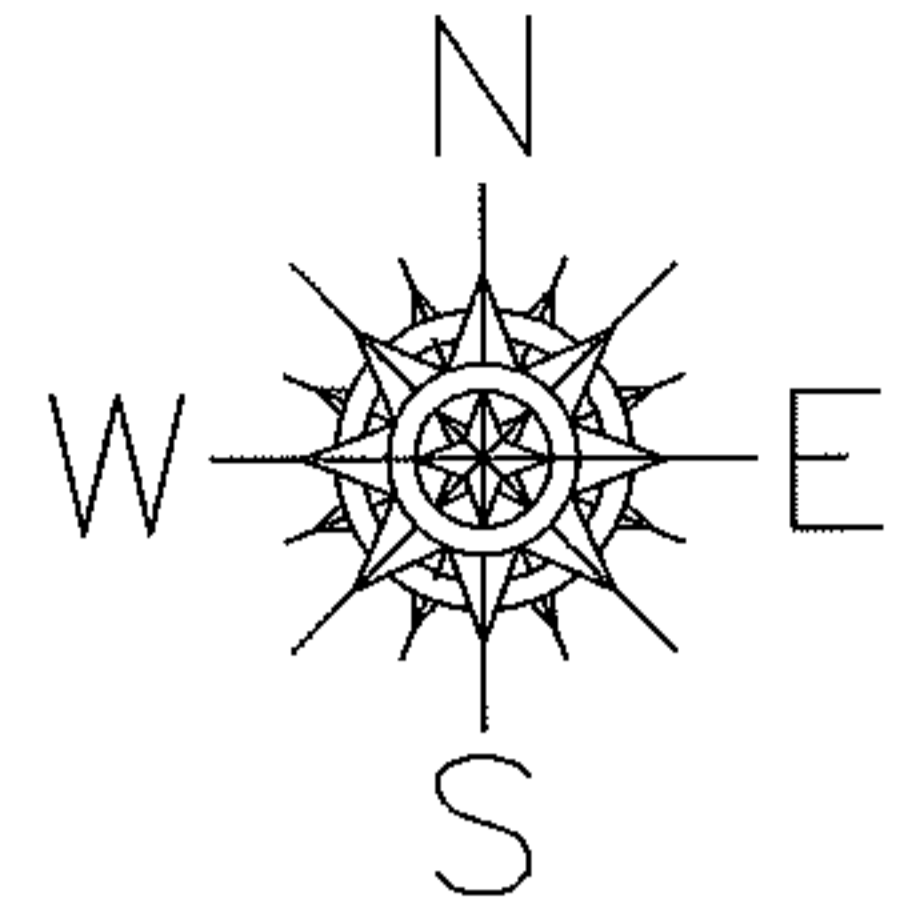

DEPTH CORRECTION

88 X 200.10 DEPTH CORR. PER.  
~~88 X 200~~ SURV. D.HAYWOOD  
 05-00-018-106-026

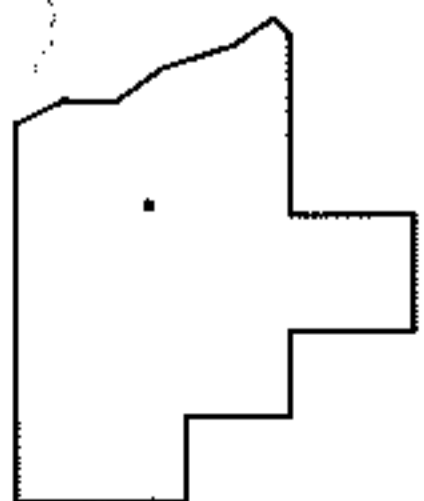

SPLITS/DEEDS PROCESSED

LORAIN COUNTY TAX MAP DEPARTMENT  
 226 MIDDLE AVE. ELYRIA, OHIO

SURVEYED BY: DALE R. HAYWOOD

CLOSURE: .00:10,000

MAP PAGE(S): 5-00-018-B

APPROVED BY: RRM DATE: 5-6-10

SCALE: 1" = 50' PRIOR INST.: 20040009930