
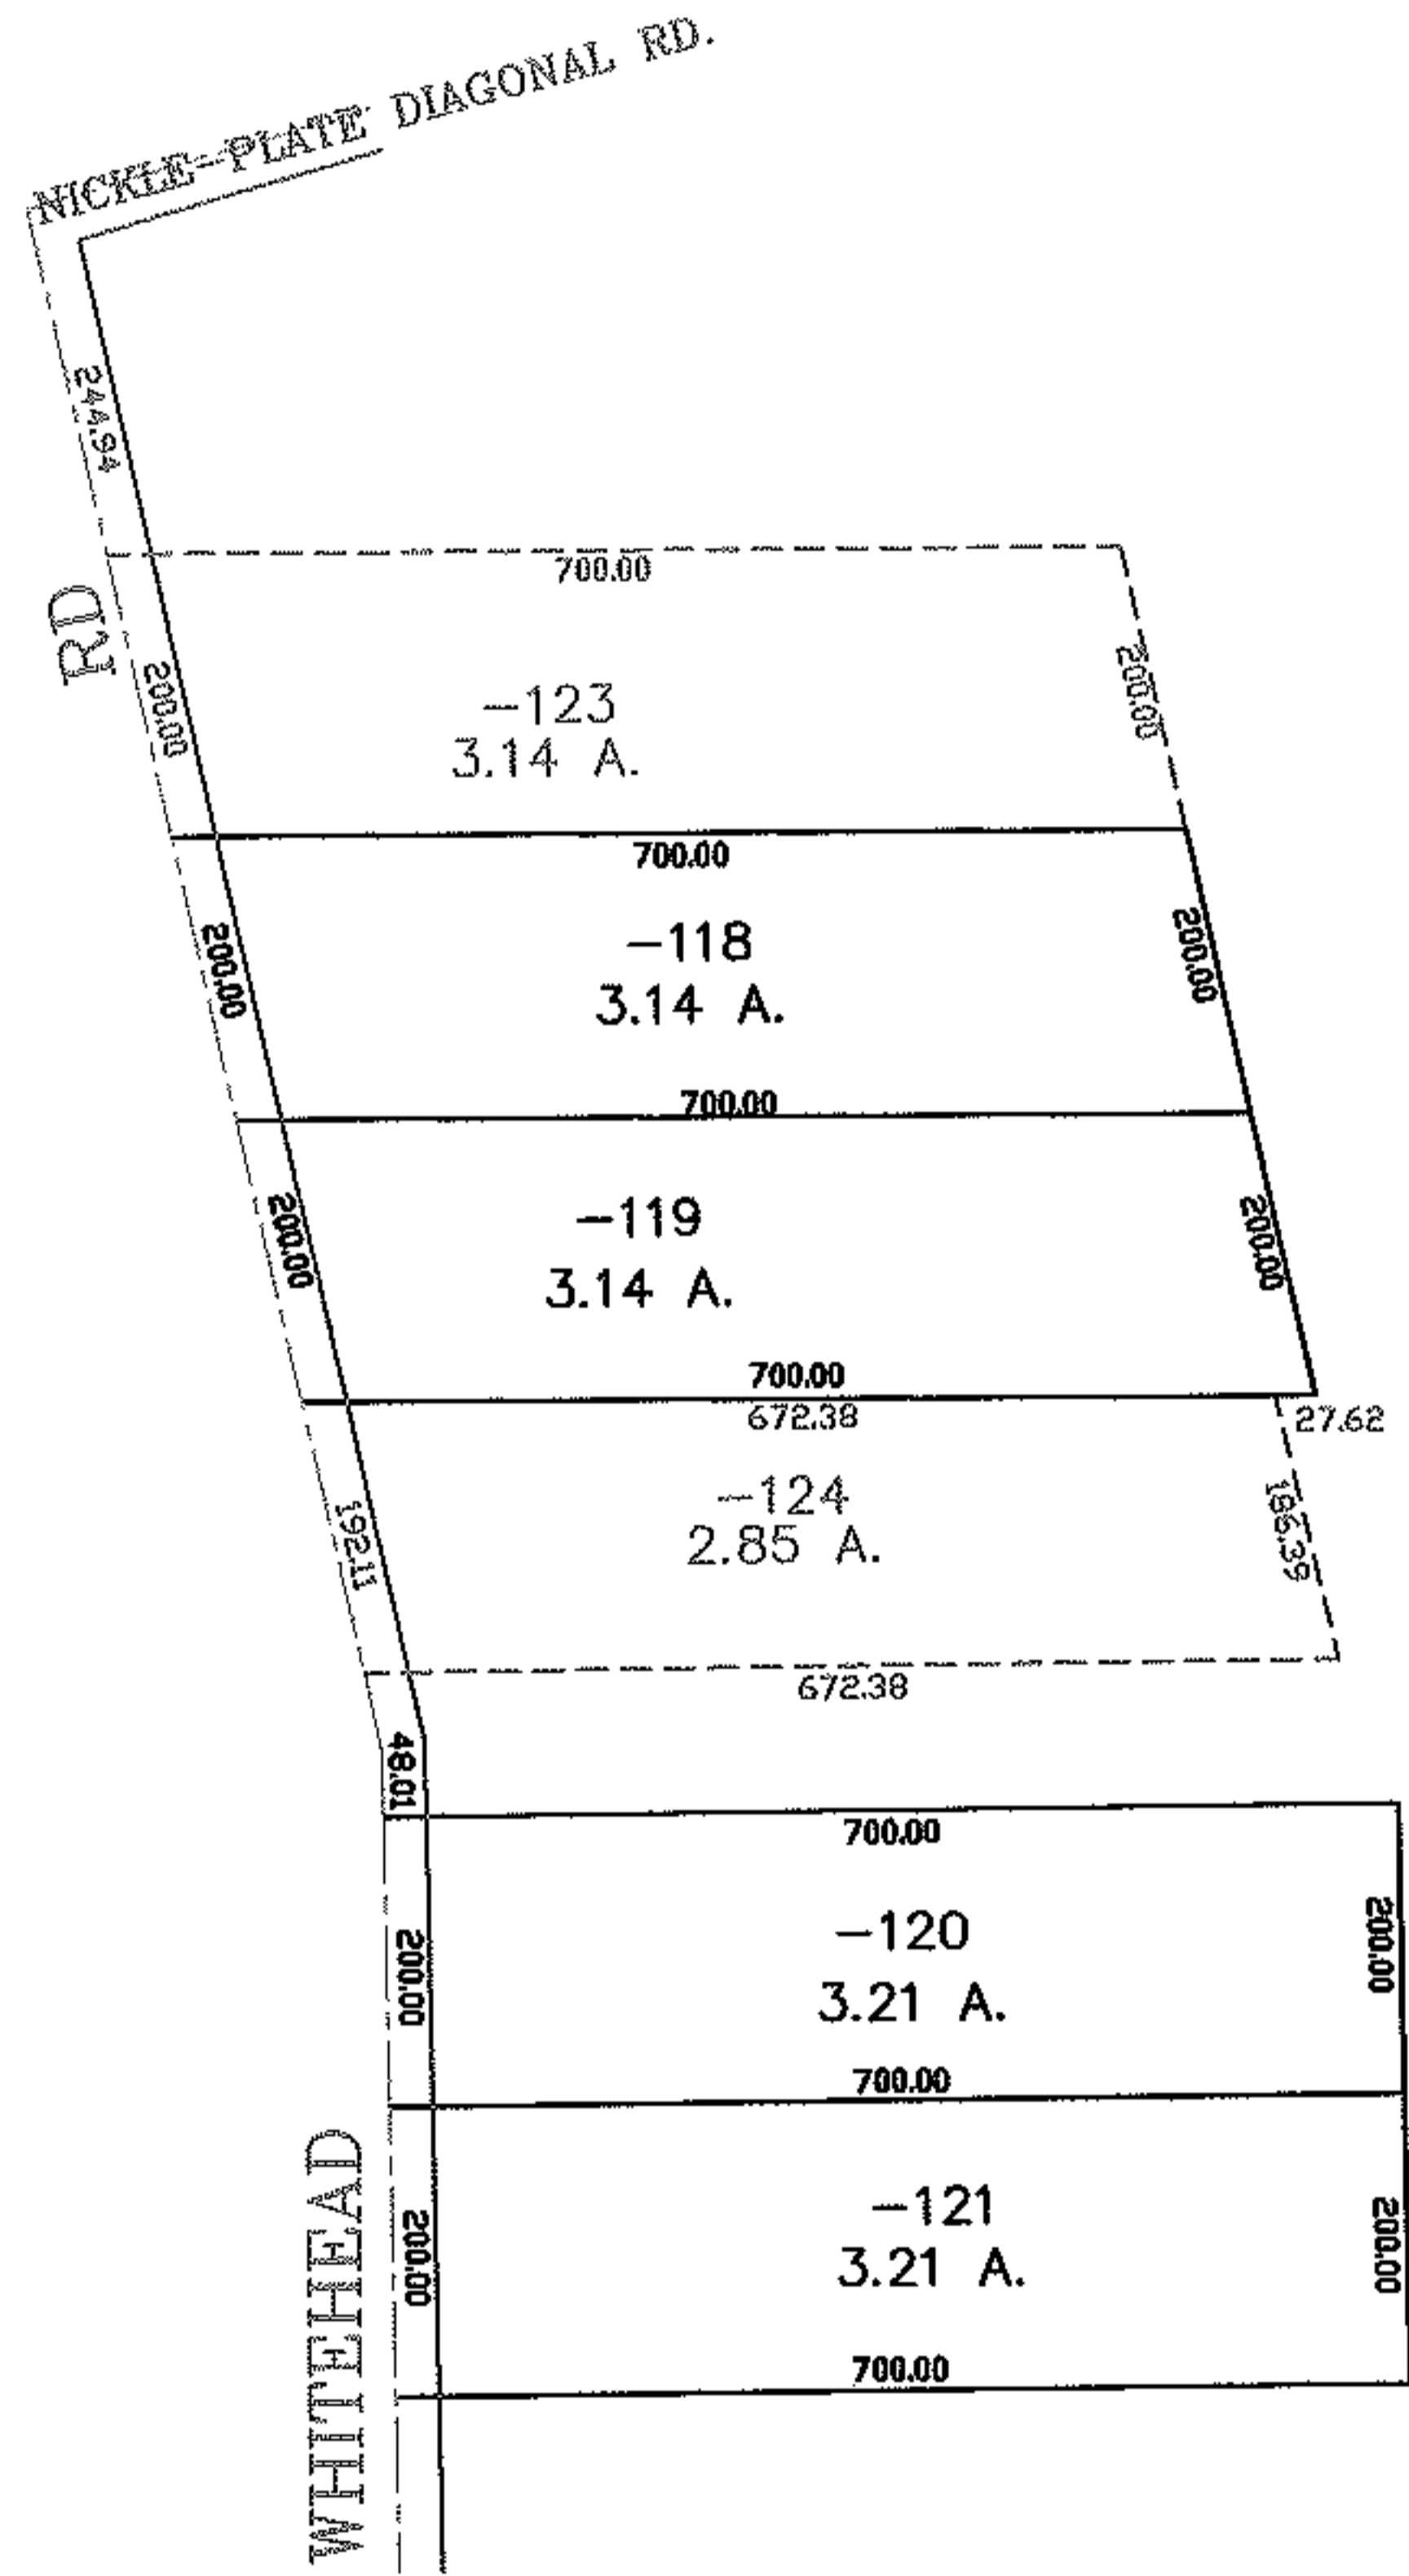


RASTER


PARENT PARCEL: 10-00-019-000-122
CHILD PARCEL: 10-00-019-000-123 THRU -125
STARTING POINT: CENTERLINE OF WHITEHEAD RD. & NICKLE-PLATE DIAGONAL RD.

05-02027

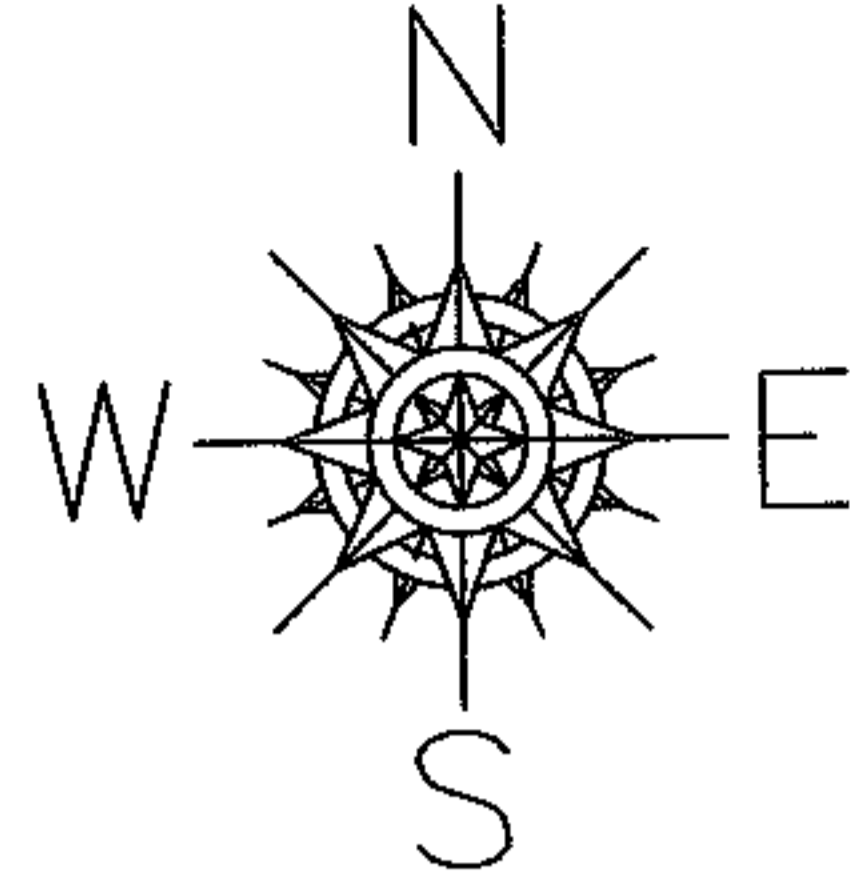

~~-122~~
~~58.28 A.~~
~~-125~~
~~52.29 A.~~
52.26 A.

AC. CORR
PER SURVEY
RICHARD CARLSON

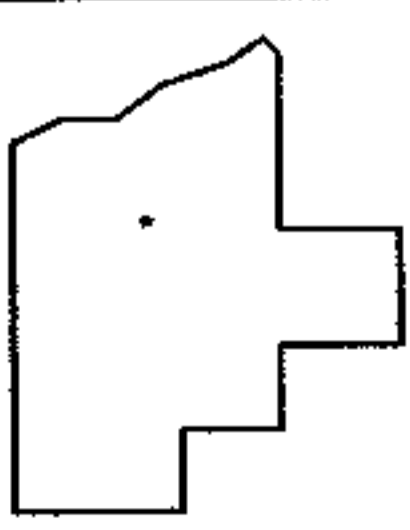

SPLITS/DEEDS PROCESSED
LORAIN COUNTY TAX MAP DEPARTMENT
226 MIDDLE AVE. ELYRIA, OHIO

SURVEYED BY: RICHARD CARLSON
CLOSURE: 0.00 : 10,000
MAP PAGE(S): 10-00-019-H
APPROVED BY: JAH DATE: 10-20-05
SCALE: 1" = 300 PRIOR INSTRUMENT: OR 244/235