


PARENT PARCEL: 11-00-010-000-029

10-02028-A



CHILD PARCEL: _____

STARTING POINT: AT A MON BOX AT THE INTERSECTION OF C/L OF ROOT RD. AND C/L OF SPRAGUE RD.

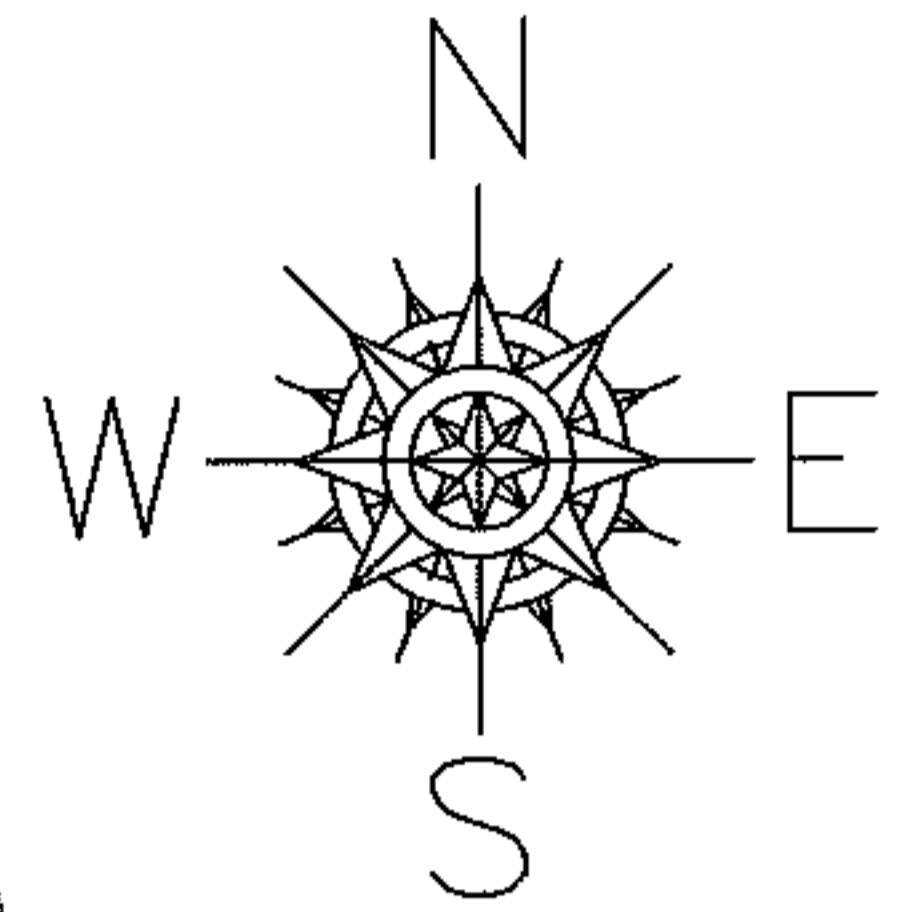

N. RIDGEVILLE TWP. O.L.8
EATON TWP. O.L.10

SPRAGUE RD.

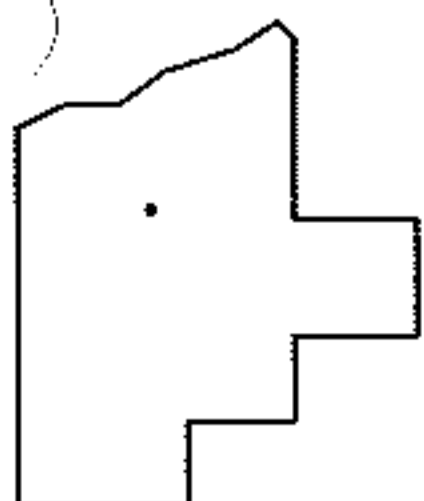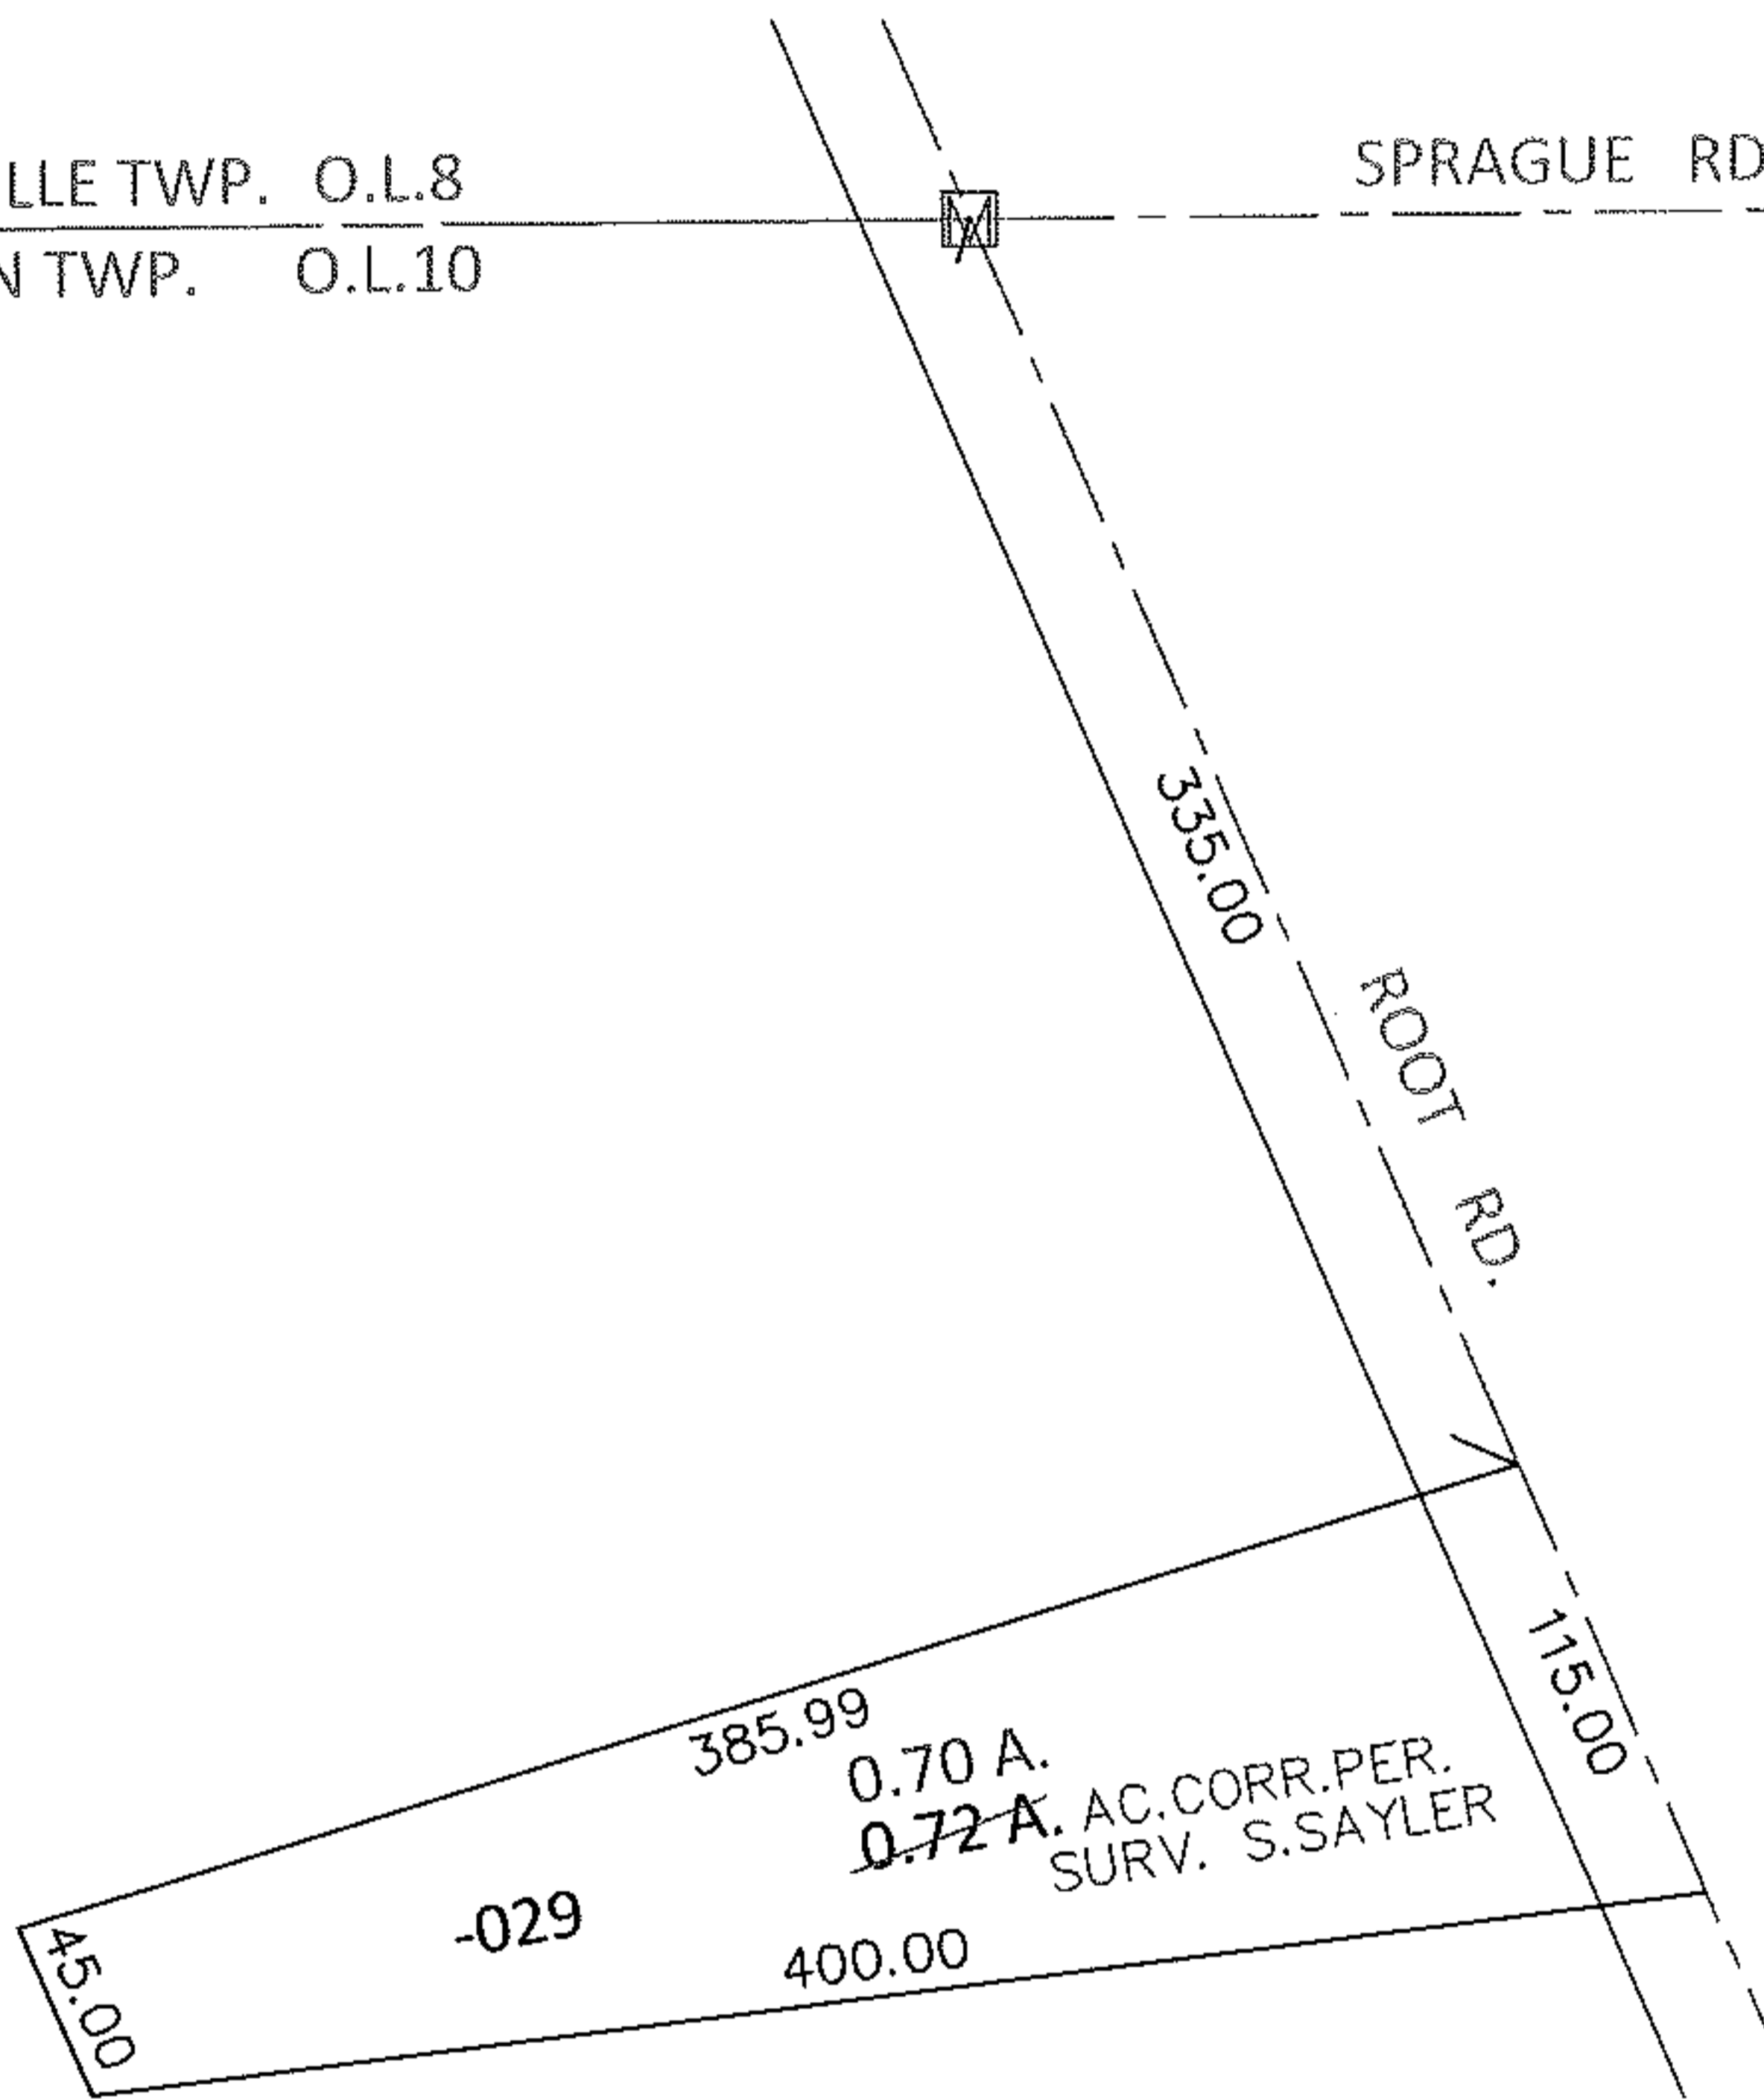

SPLITS/DEEDS PROCESSED

LORAIN COUNTY TAX MAP DEPARTMENT
226 MIDDLE AVE. ELYRIA, OHIO

SURVEYED BY: STEWART W. SAYLER

CLOSURE: .01:10,000

MAP PAGE(S): 11-00-010-A

APPROVED BY: RRM DATE: 5-6-10

SCALE: 1"= 100 PRIOR INST.: 20100326125