


PARENT PARCEL: 15-00-059-000-016



CHILD PARCEL: 15-00-059-000-018, -019

STARTING POINT: CENTERLINE OF NICKLE PLATE DIAGONAL RD. & WAKEMAN BELDEN RD.

05-02029
PT. 2

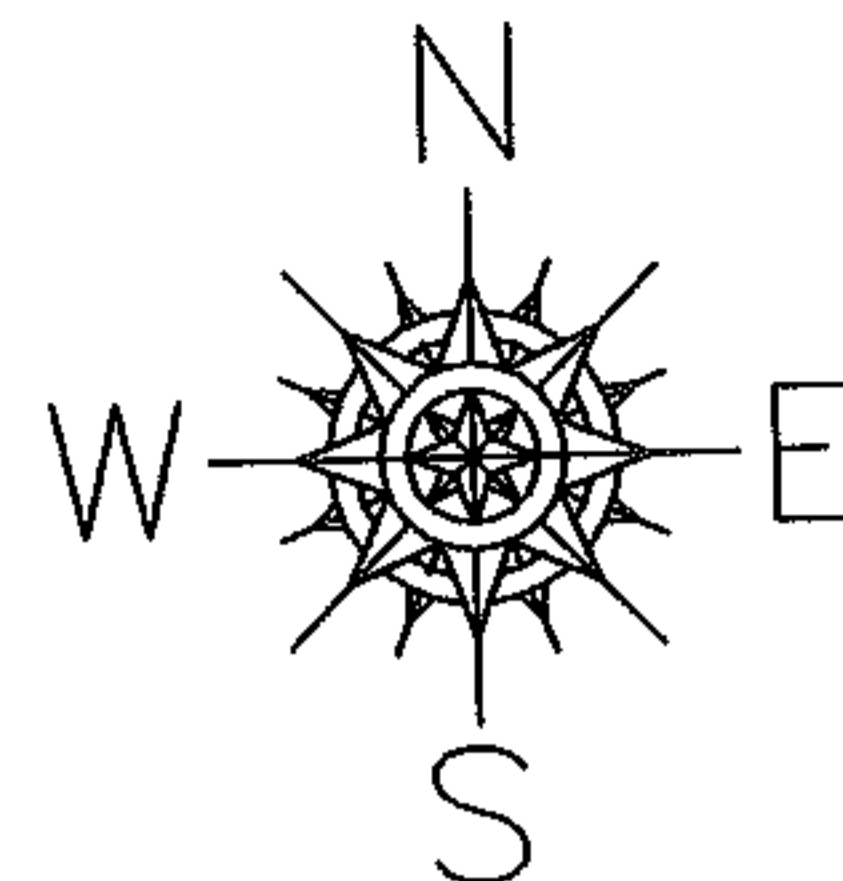

WAKEMAN BELDEN RD.

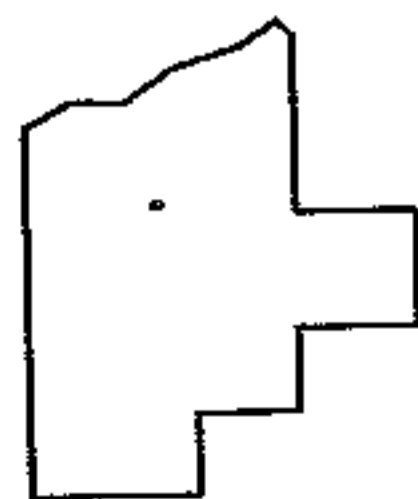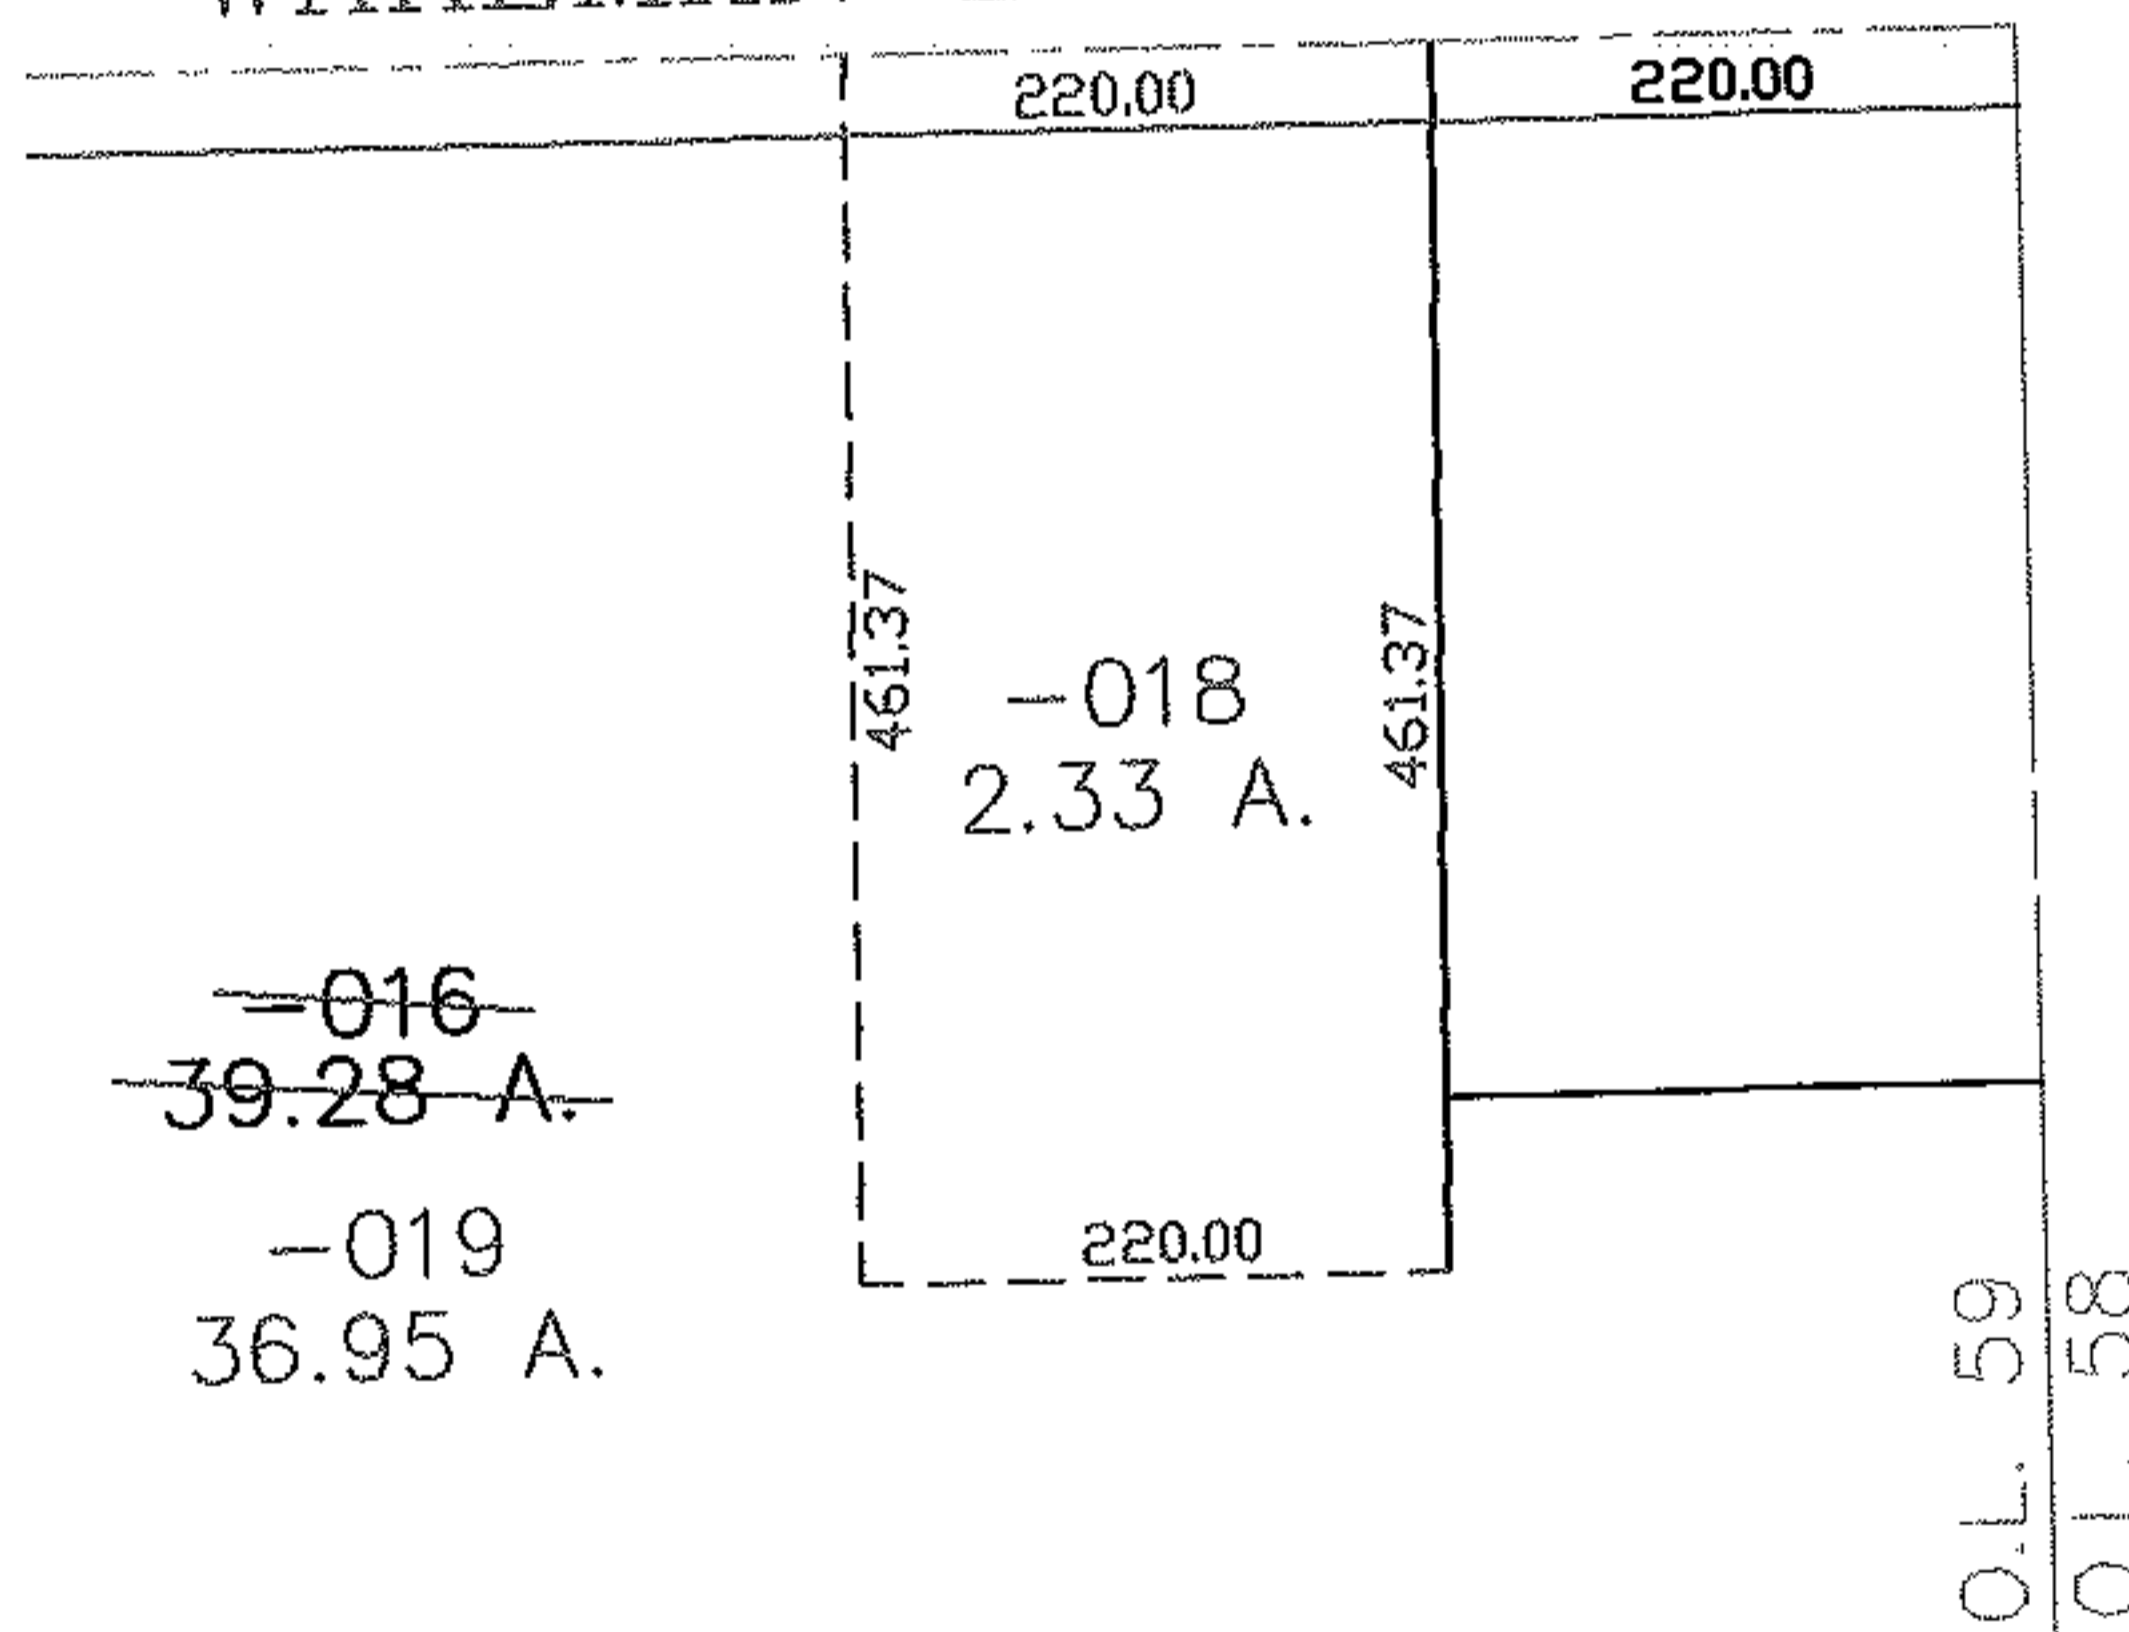

SPLITS/DEEDS PROCESSED
LORAIN COUNTY TAX MAP DEPARTMENT
226 MIDDLE AVE. ELYRIA, OHIO

SURVEYED BY: RICHARD CARLSON
CLOSURE: 0.00 : 10.000
MAP PAGE(S): 15-00-059-B
APPROVED BY: JAH DATE: 10-25-05
SCALE: 1" = 200 PRIOR INSTRUMENT: 990625153