




RASTER

PARENT PARCEL: 15-00-059-000-009

CHILD PARCEL: 15-00-059-000-010 THRU -017

STARTING POINT: CENTERLINE OF NICKLE PLATE DIAGONAL RD & WAKEMAN BELDEN RD.

05-02029

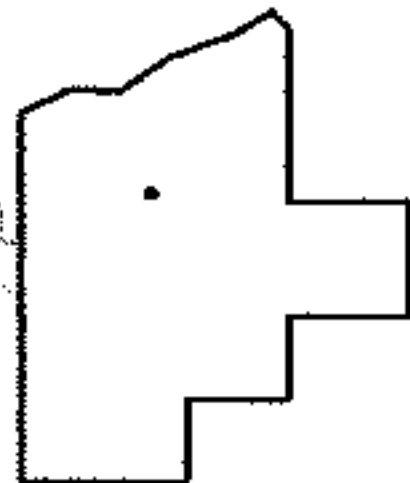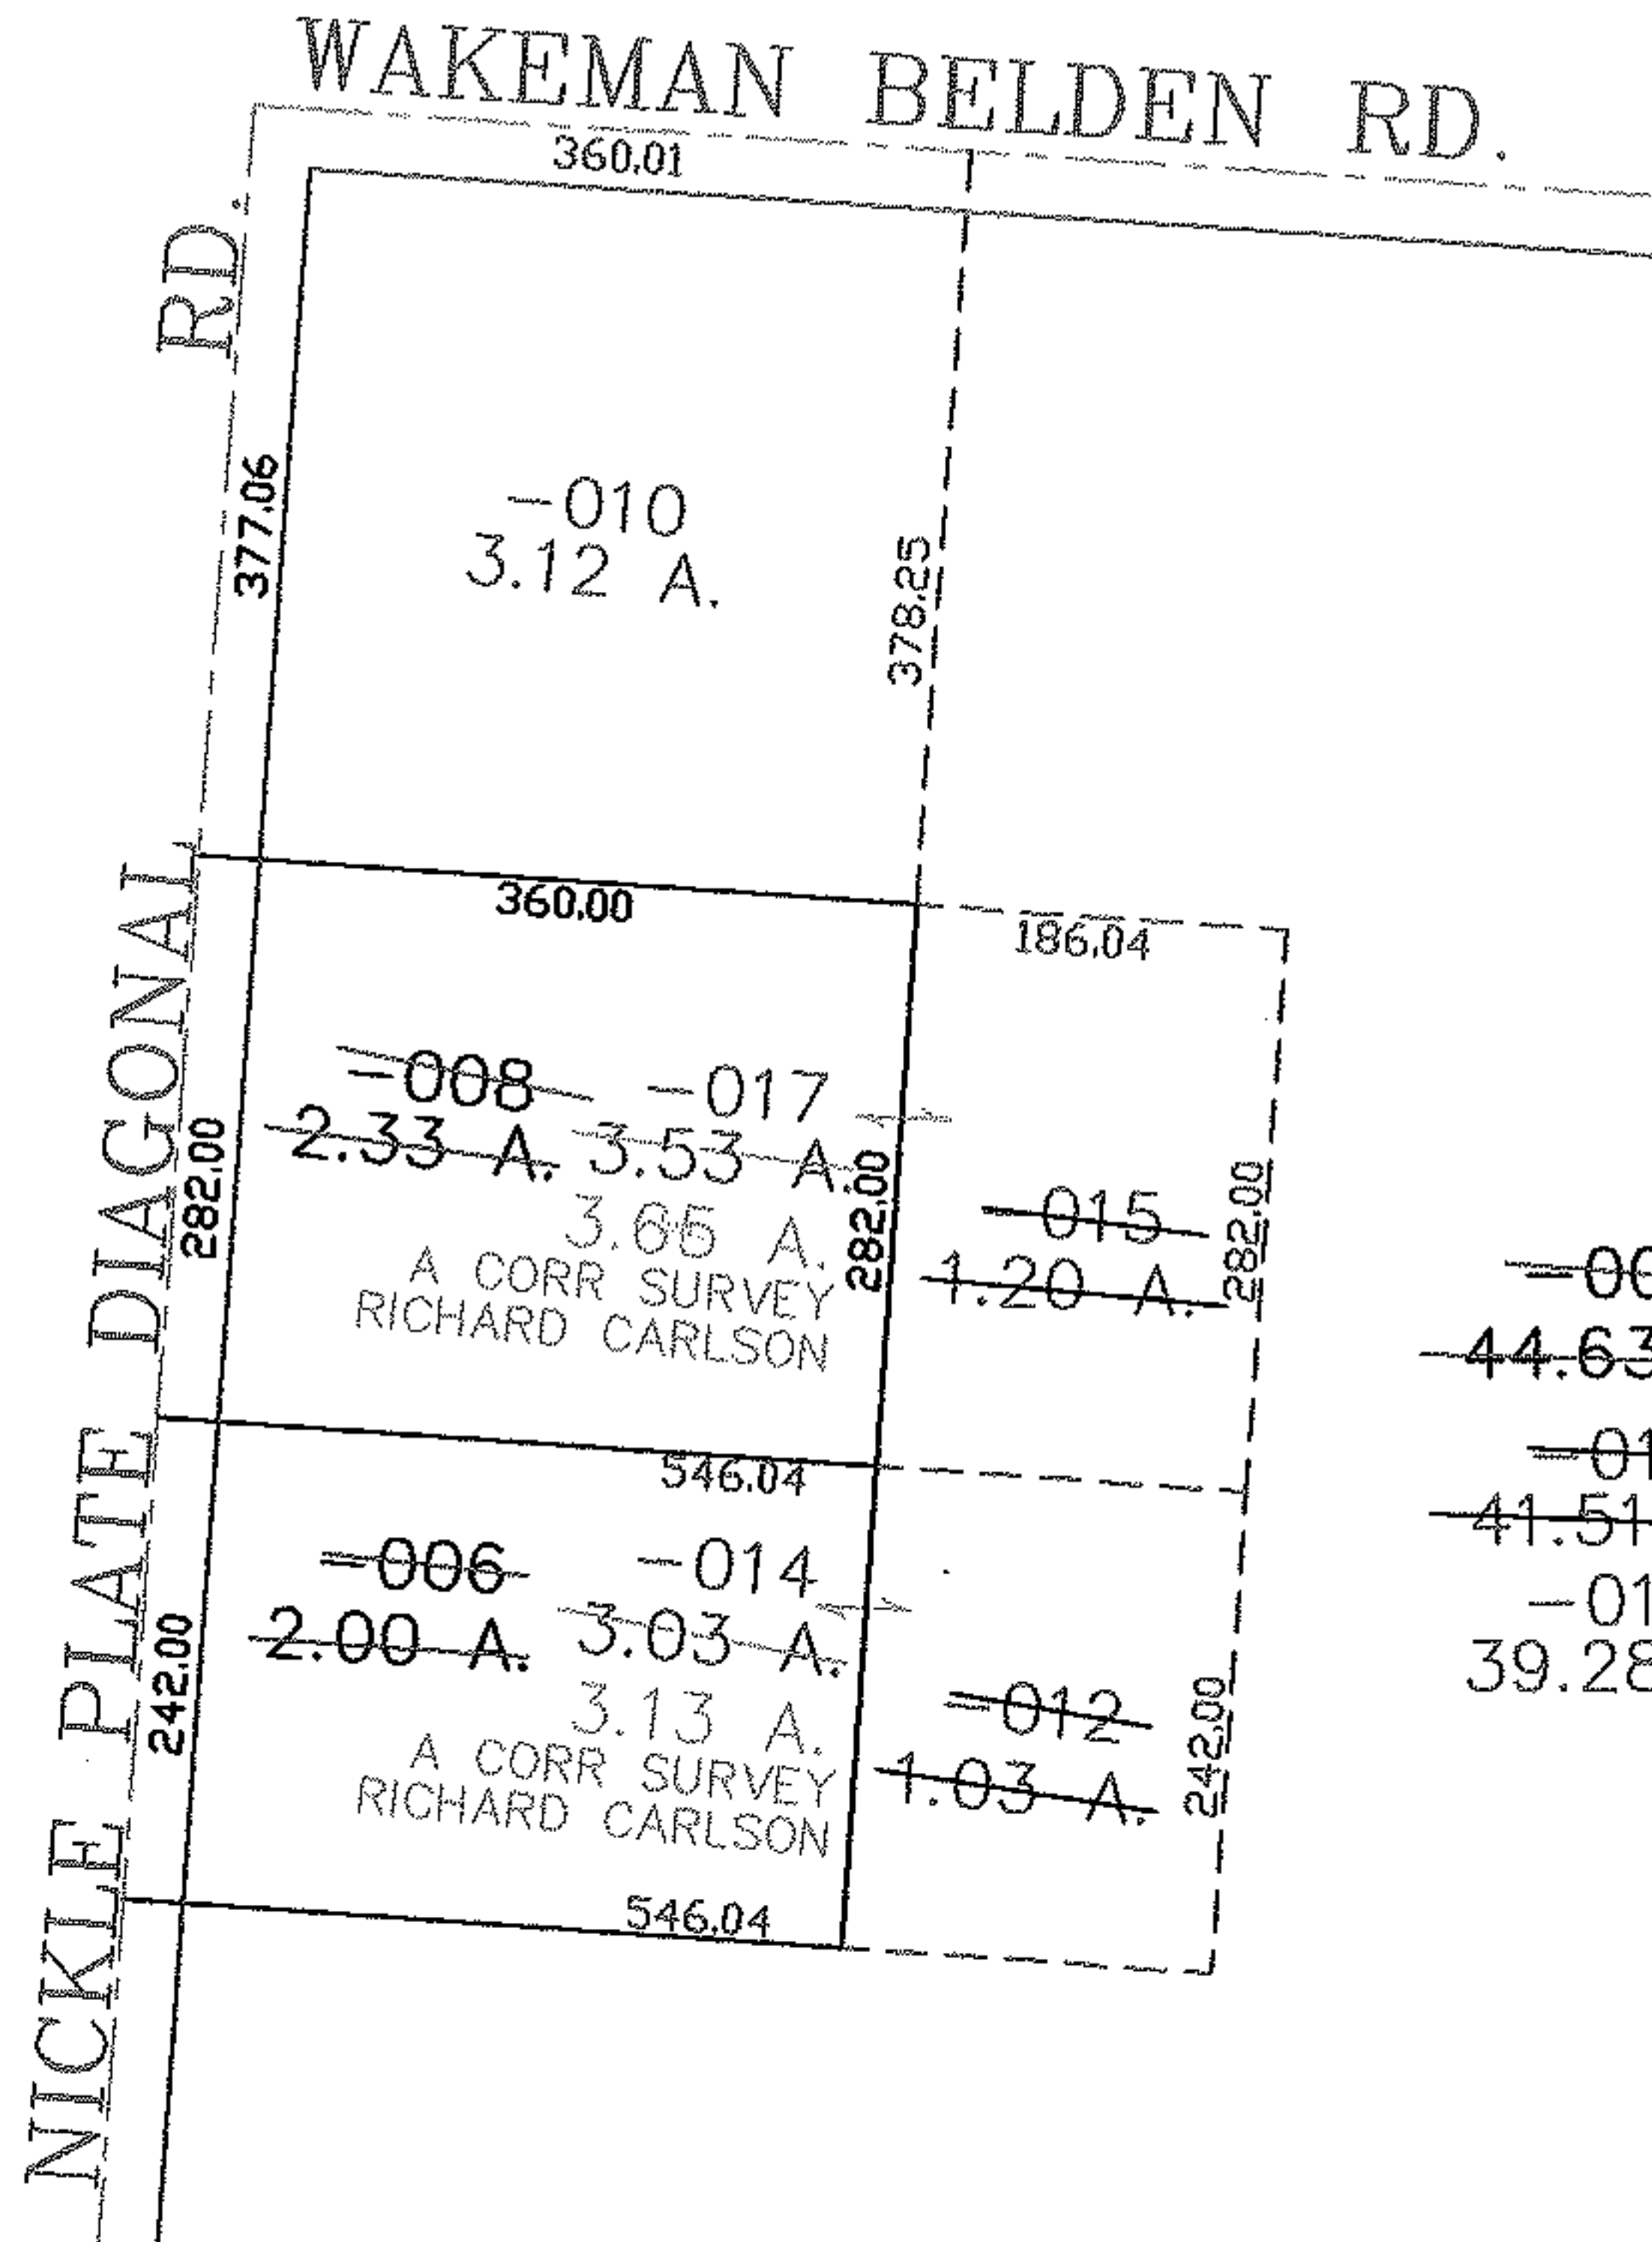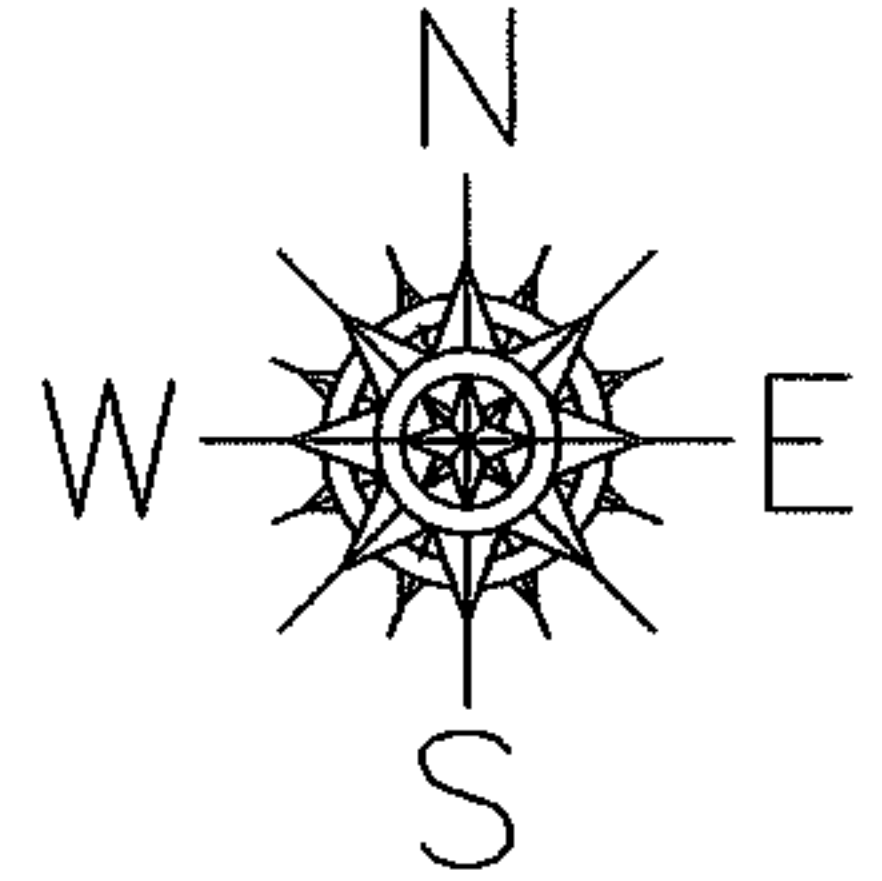

SPLITS/DEEDS PROCESSED
 LORAIN COUNTY TAX MAP DEPARTMENT
 226 MIDDLE AVE. ELYRIA, OHIO

SURVEYED BY: RICHARD CARLSON
 CLOSURE: 0.00 : 10.000
 MAP PAGE(S): 15-00-059-B
 APPROVED BY: JAH DATE: 10-25-05
 SCALE: 1" = 200 PRIOR INSTRUMENT: 990625153