




PARENT PARCEL: 07-00-021-118-019  
CHILD PARCEL: XX-XX-XXX-XXX-XXX  
STARTING POINT: N.E. CORNER OF S/L/ 12 IN ROOT FARMS ALLOT. VOL. 8 PG. 43

10-02030-C

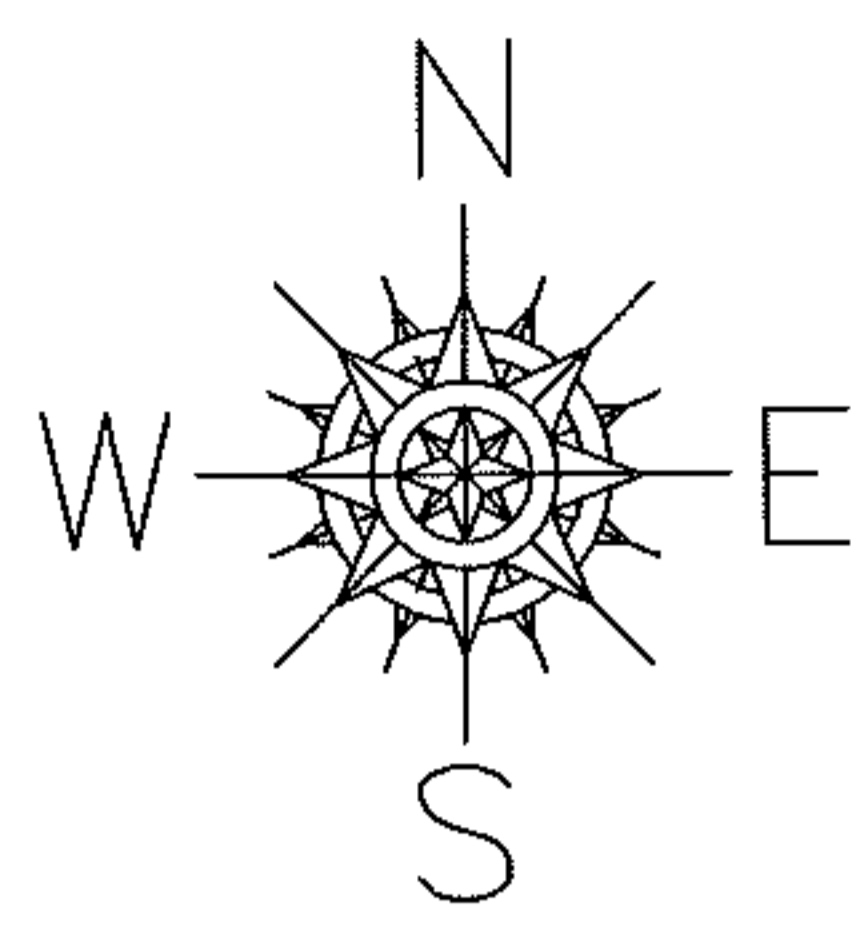

# MAP CORRECTION

ADD DEPTH DIMENSIONS

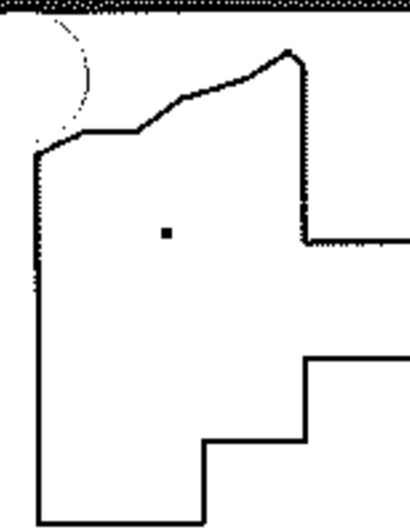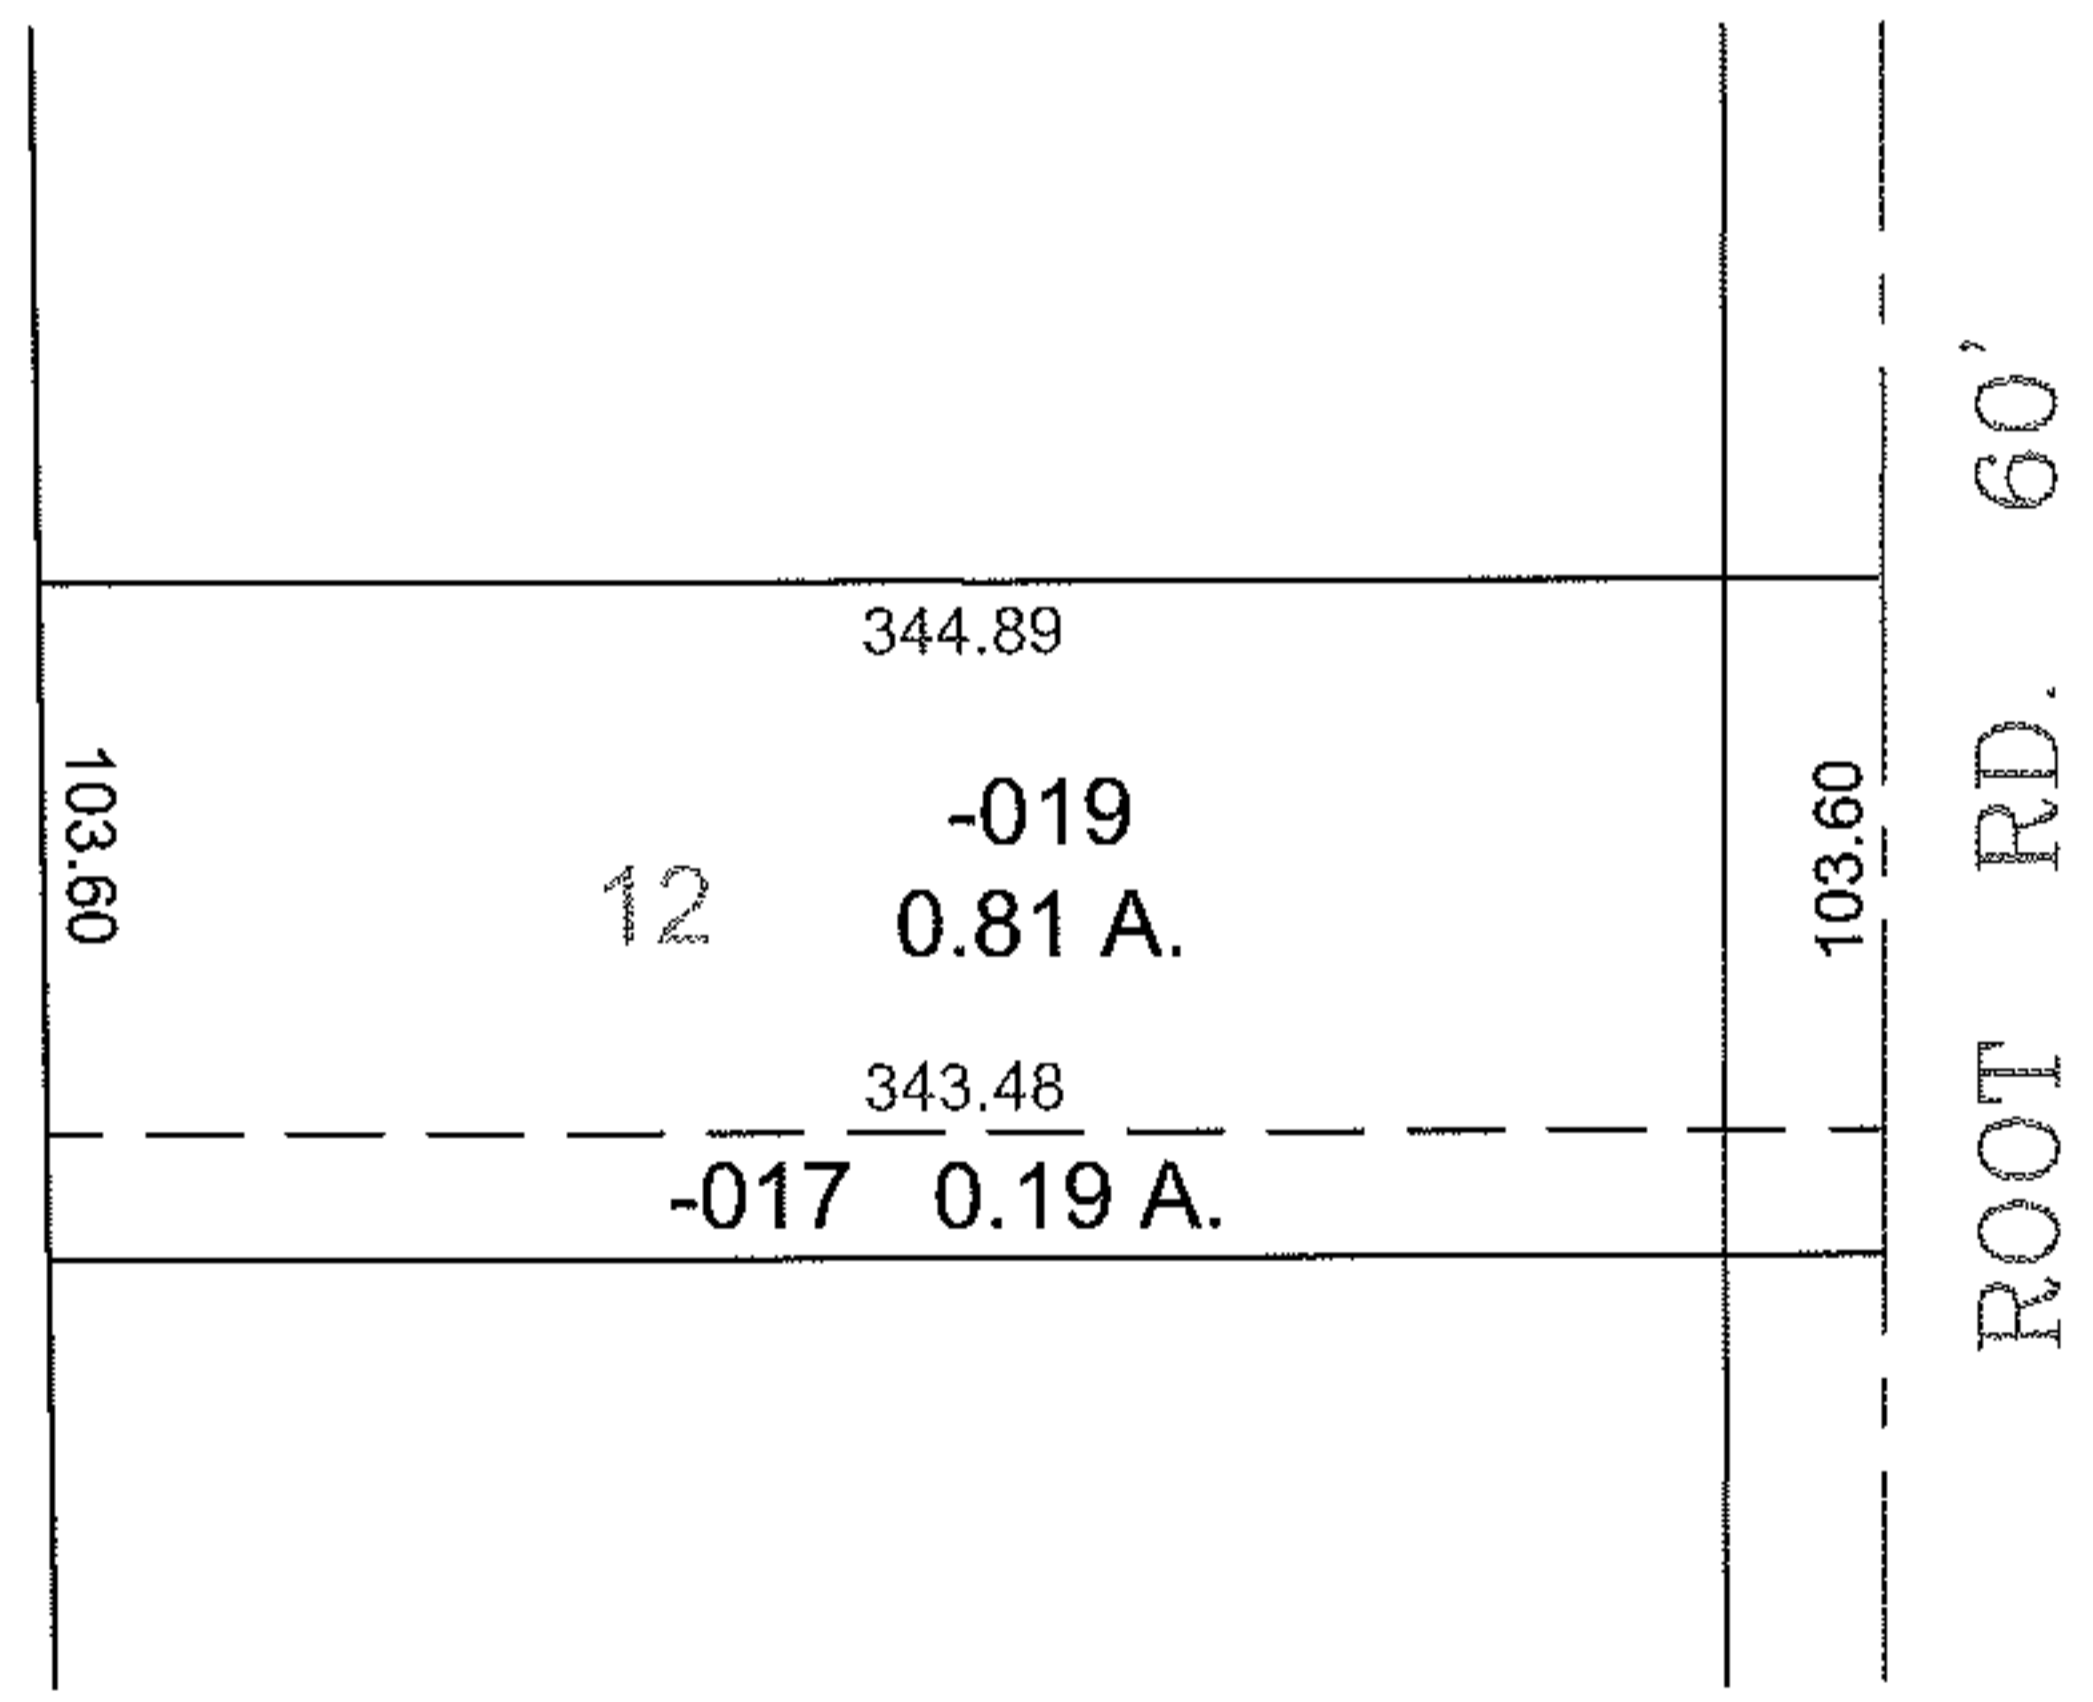

**SPLITS/DEEDS PROCESSED**  
LORAIN COUNTY TAX MAP DEPARTMENT  
226 MIDDLE AVE. ELYRIA, OHIO

SURVEYED BY: XXXXXXXXXX  
CLOSURE: 1 : 85,000  
MAP PAGE(S): 7-00-021-D  
APPROVED BY: TJS DATE: 5/14/10  
SCALE: 1" = 100 PRIOR INSTRUMENT: 20080244180