
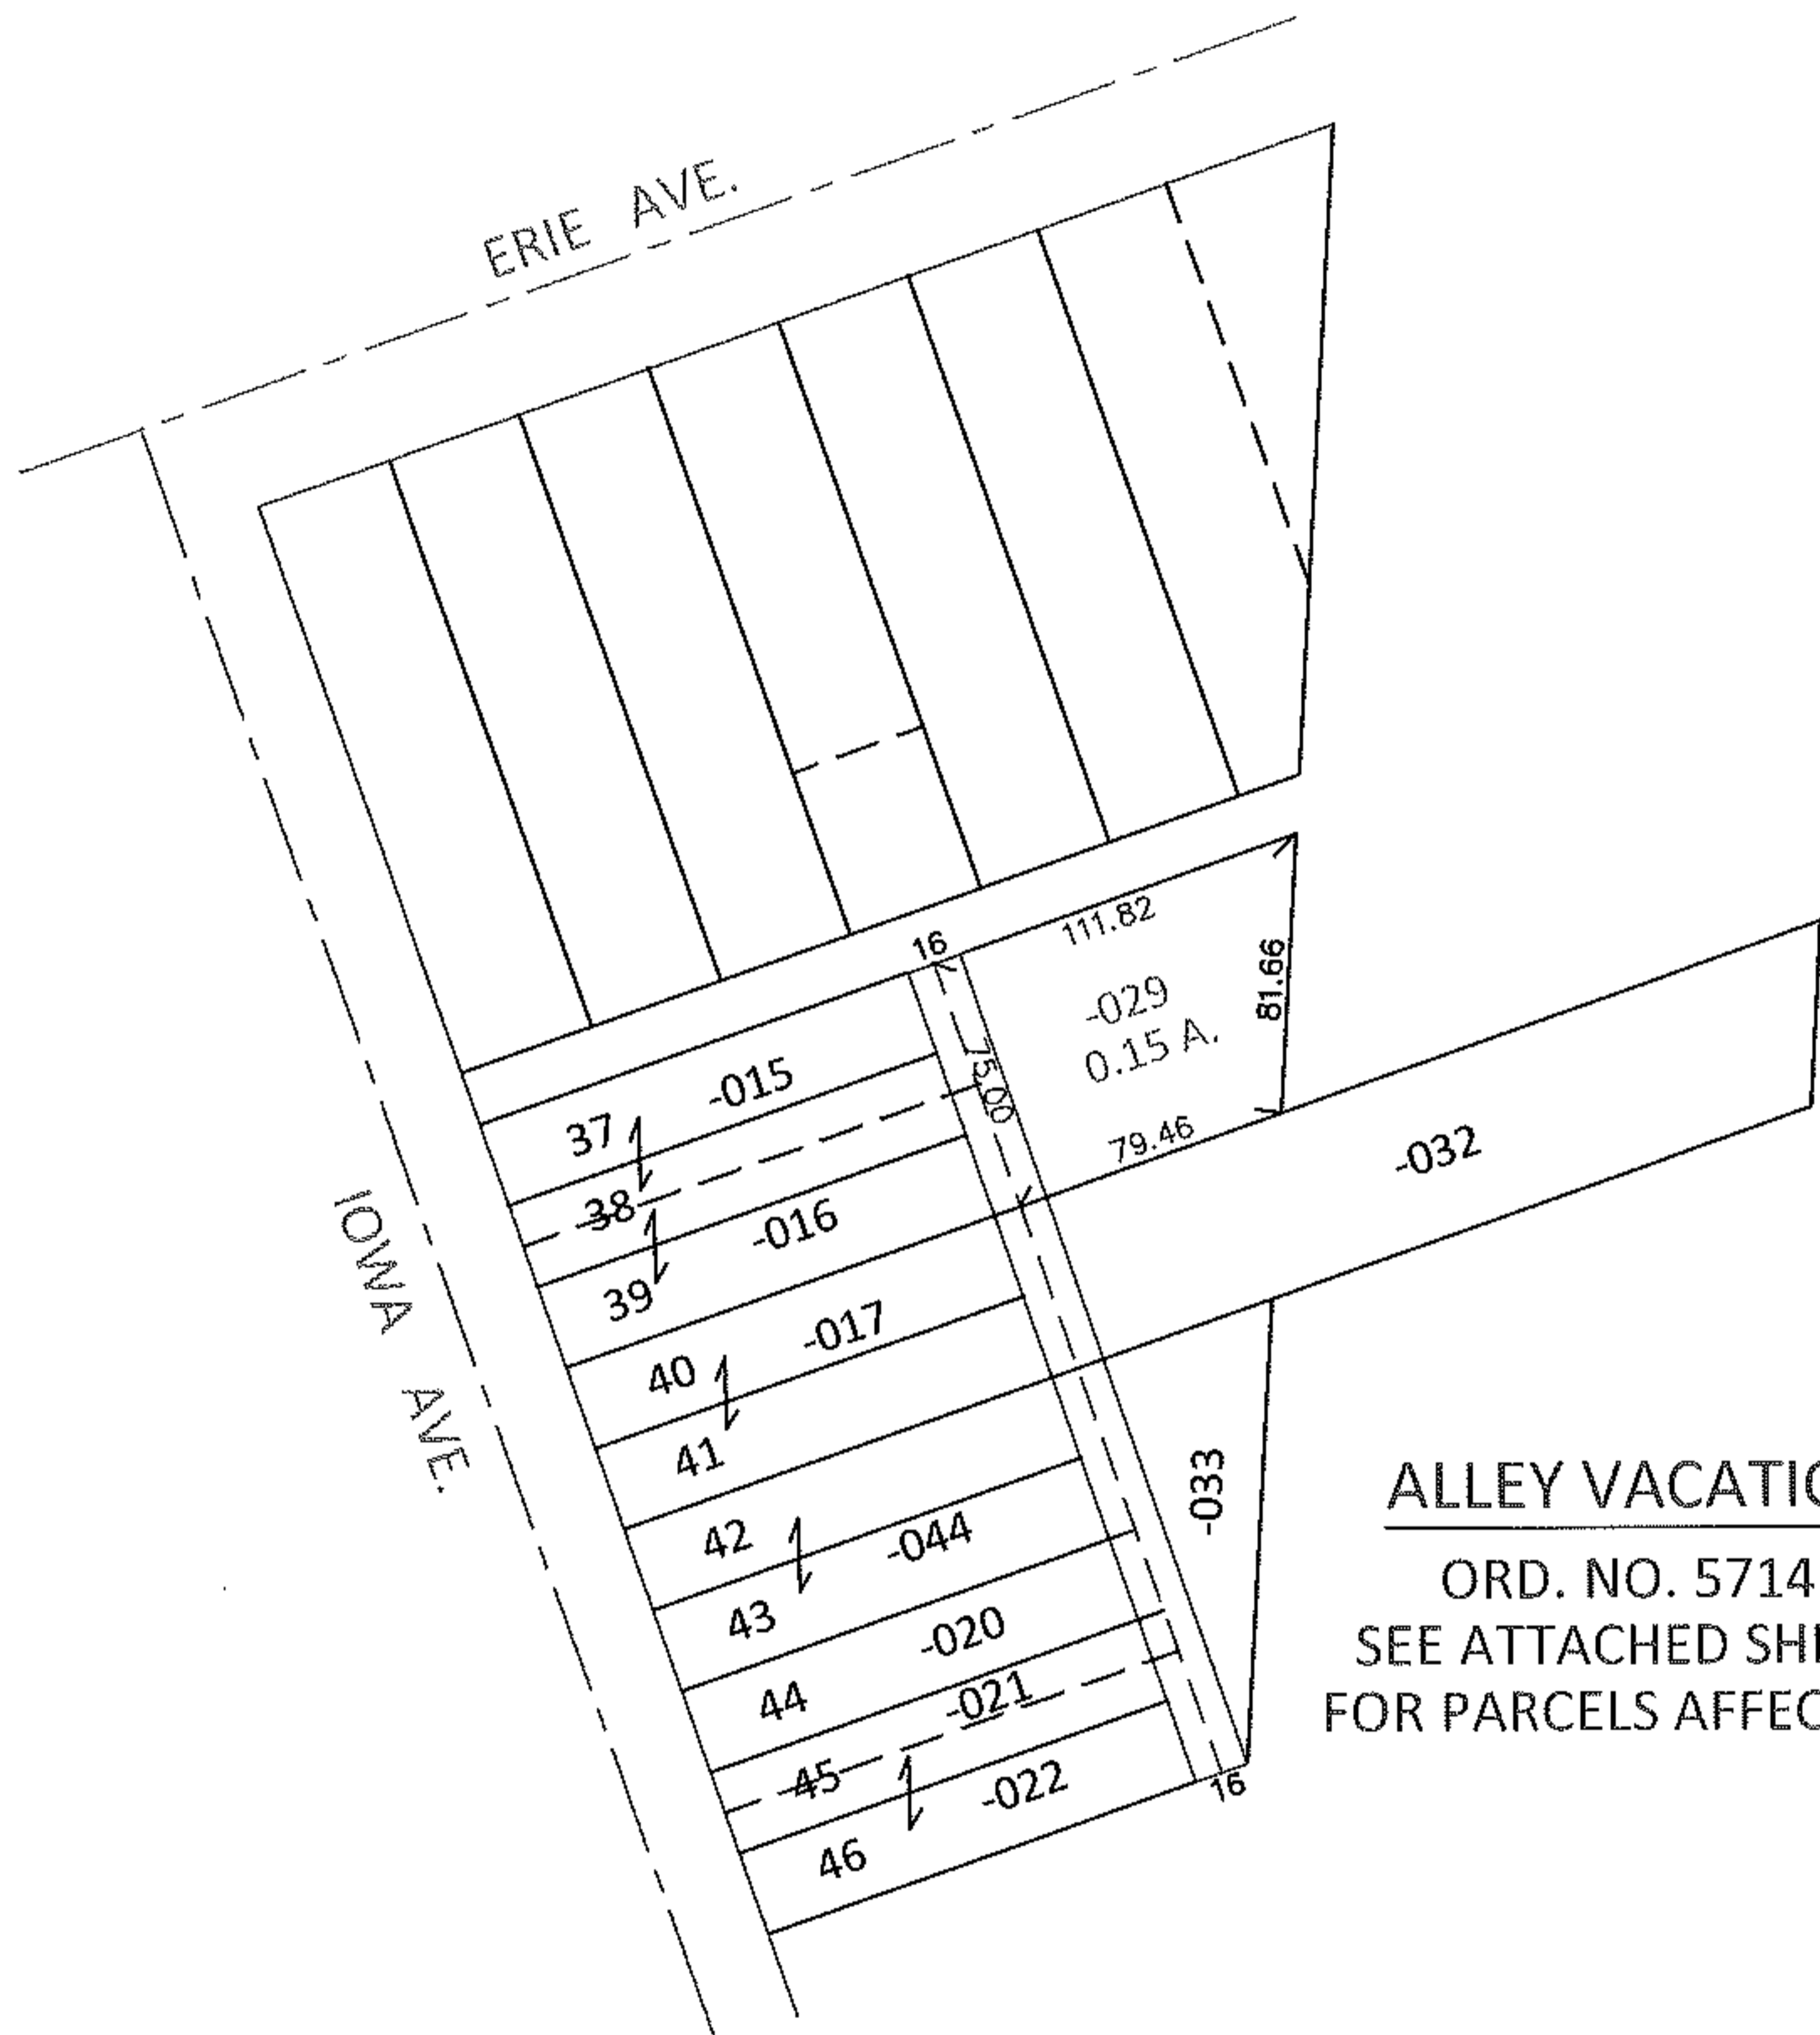


PARENT PARCEL: 02-00-051-105-015.-016,-017,-020,-021,-022,-029,-032,-033,-044


CHILD PARCEL: _____

STARTING POINT: _____

10-02031-V

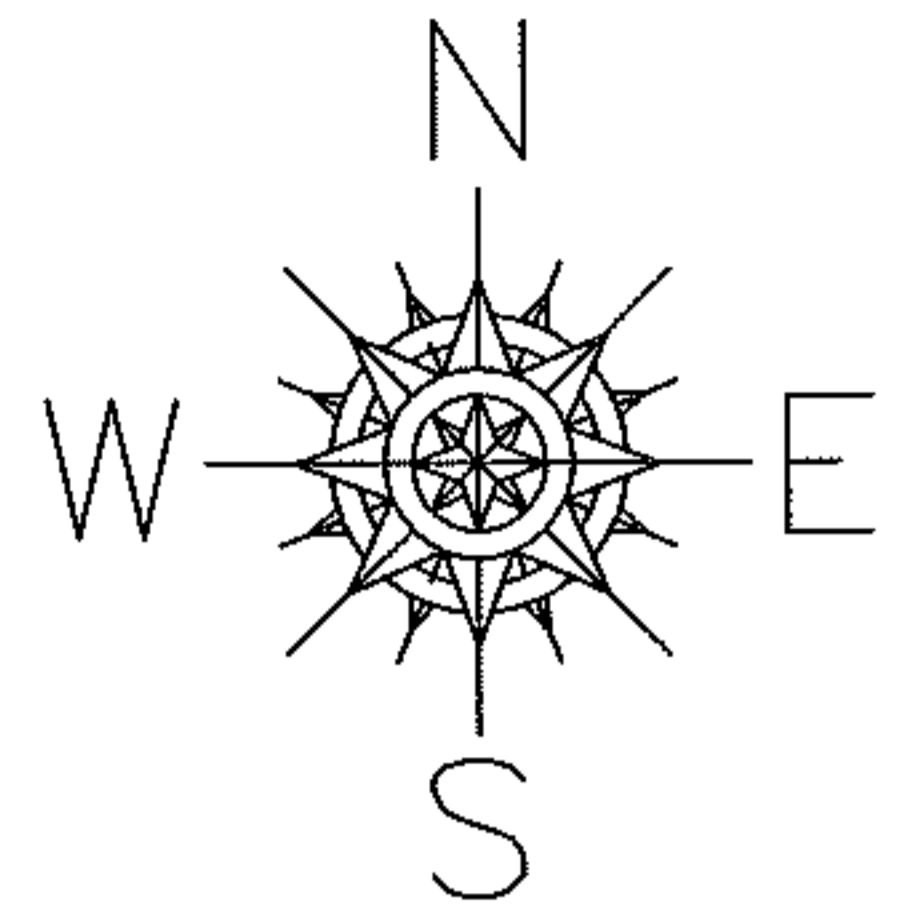

ALLEY VACATION
ORD. NO. 5714
SEE ATTACHED SHEET
FOR PARCELS AFFECTED

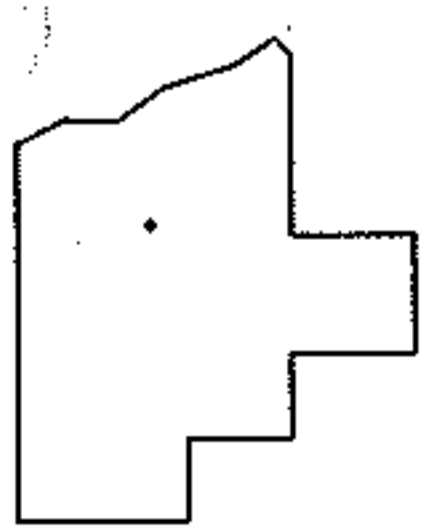

SPLITS/DEEDS PROCESSED

LORAIN COUNTY TAX MAP DEPARTMENT
226 MIDDLE AVE. ELYRIA, OHIO

SURVEYED BY: N/A
CLOSURE: N/A
MAP PAGE(S): 2-00-051-A
APPROVED BY: RRM DATE: 5/20/10
SCALE: 1"= 100 PRIOR INST.: 20040033927