
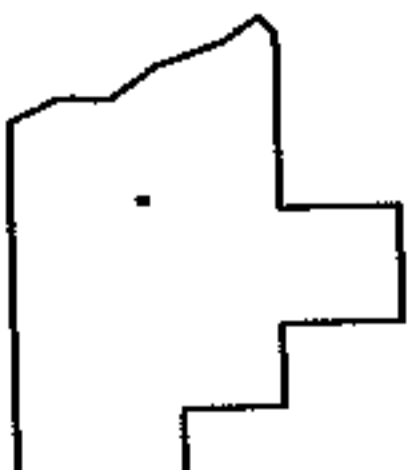
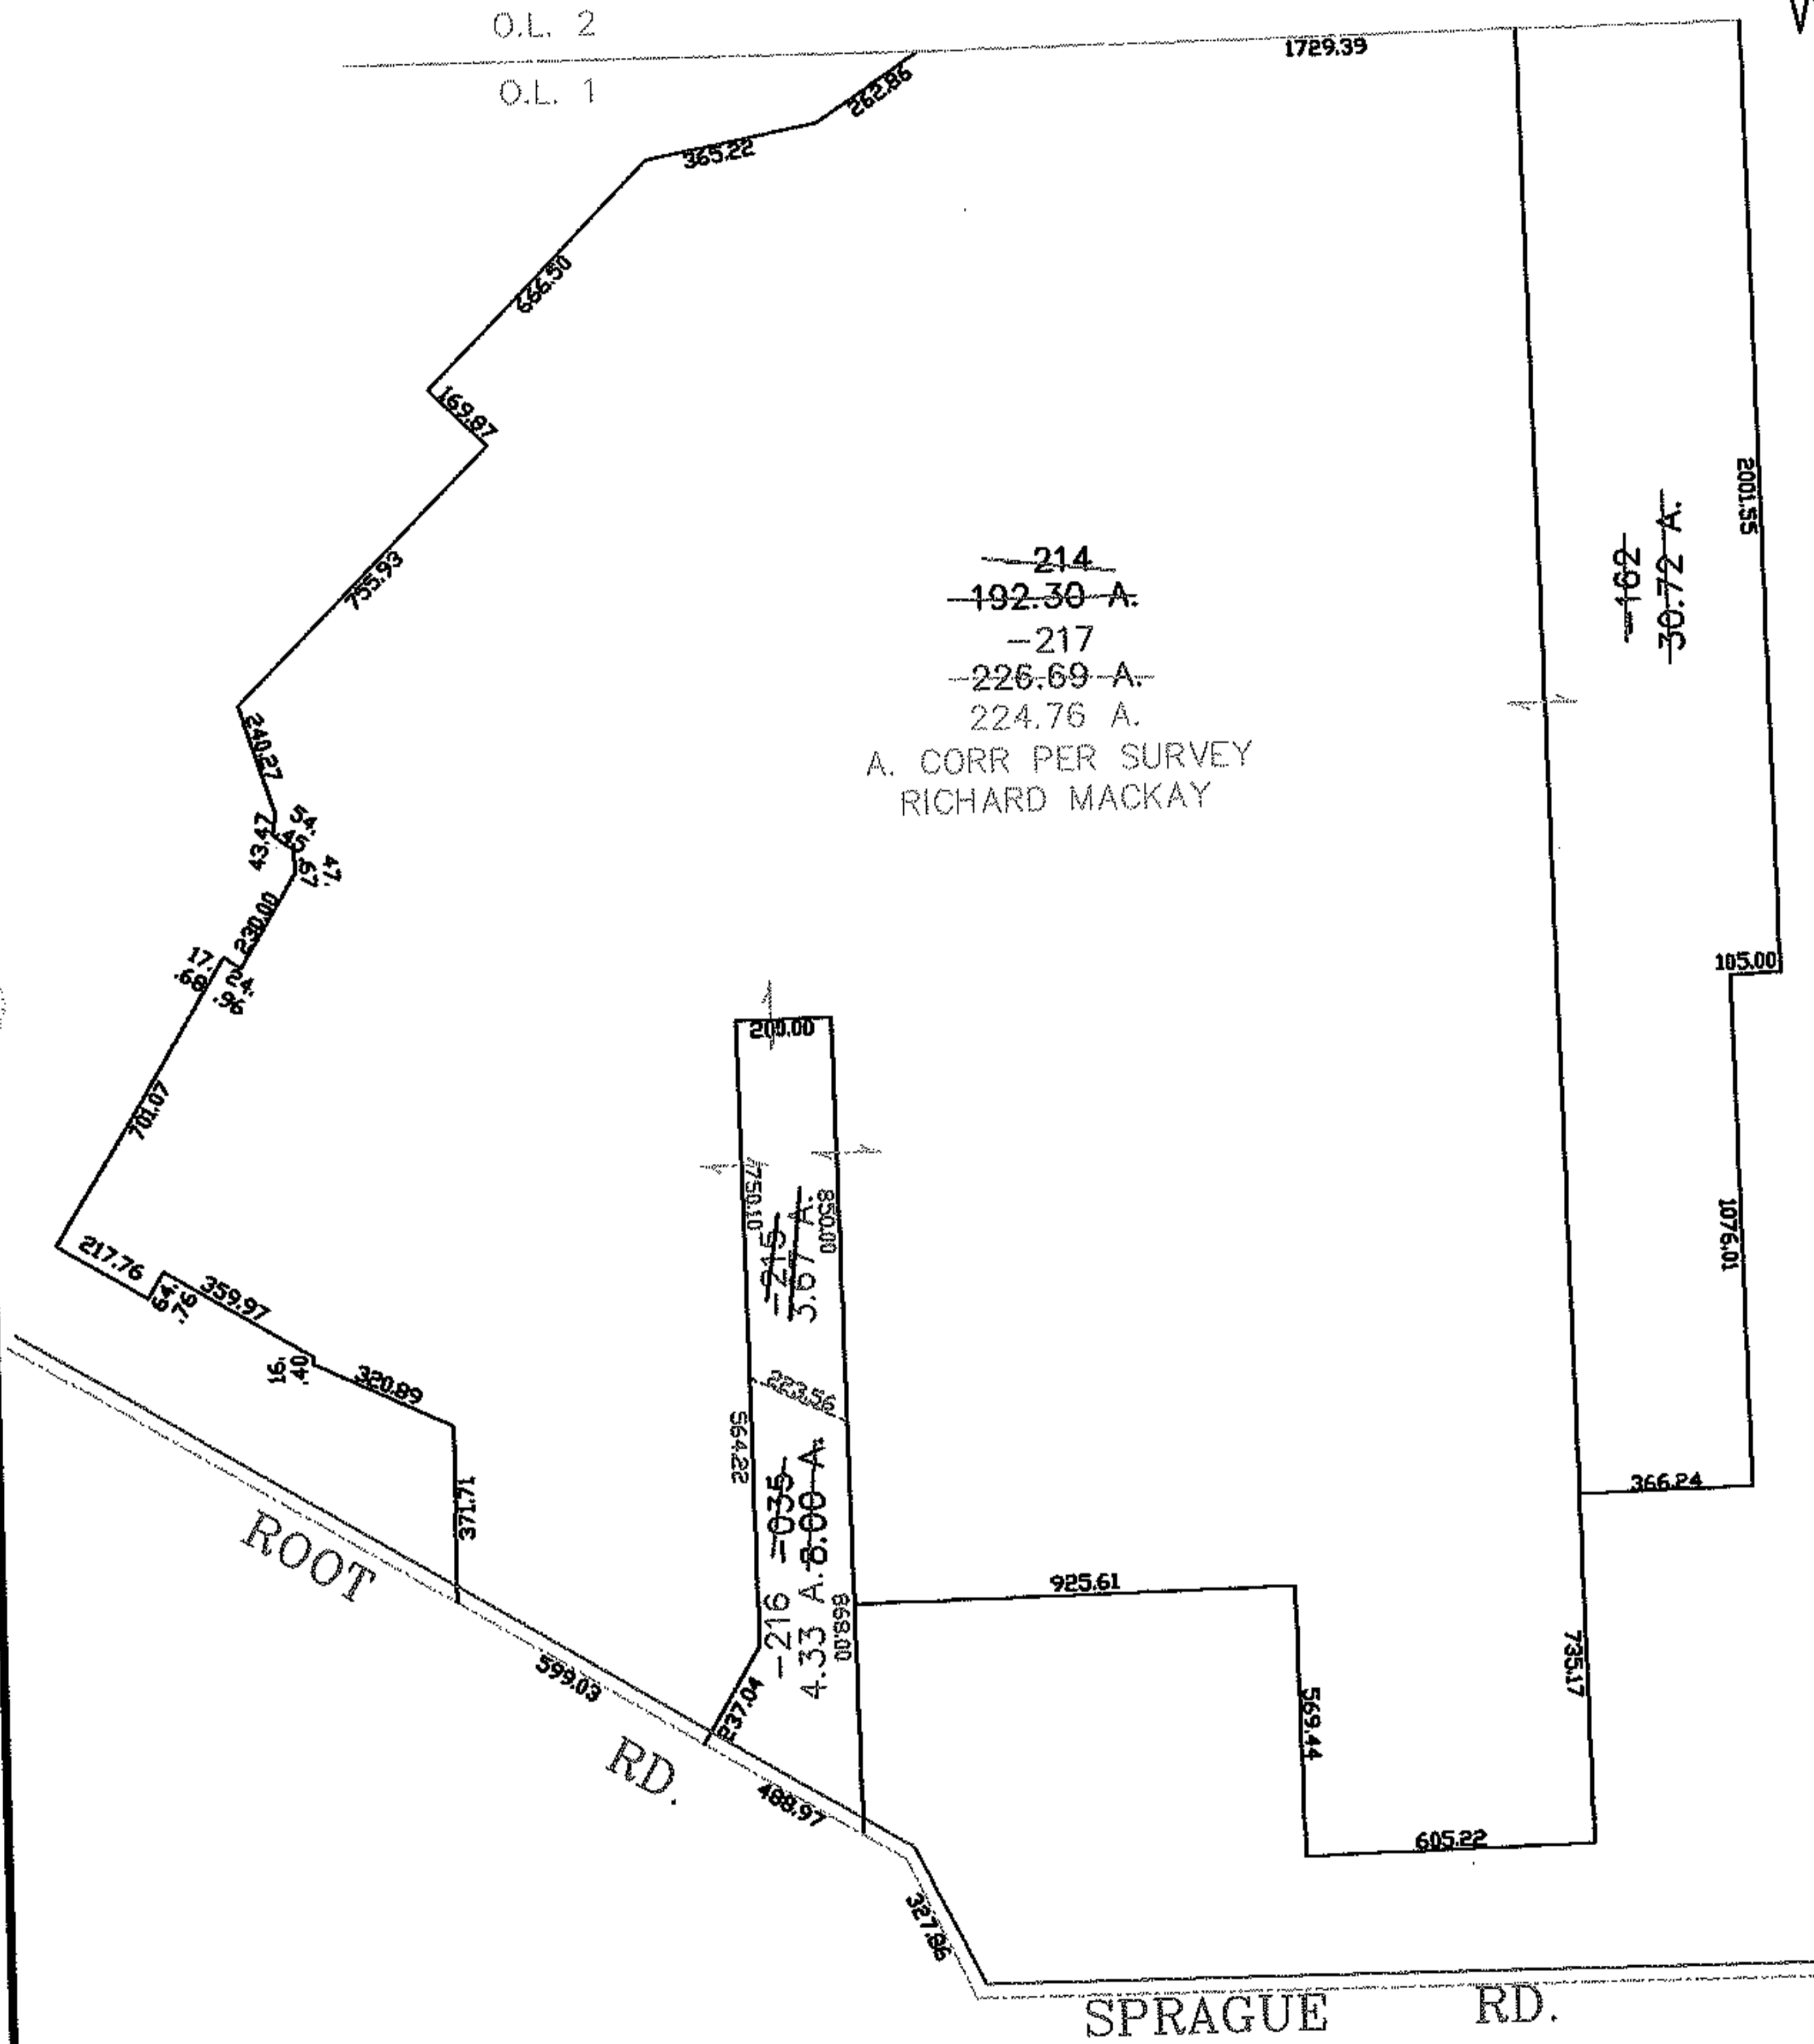


PARENT PARCEL: 07-00-001-000-035, 214, -162
 CHILD PARCEL: 07-00-001-000-215 THRU -217
 STARTING POINT: CENTERLINE OF ROOT RD. & SPRAGUE RD.

05-02031

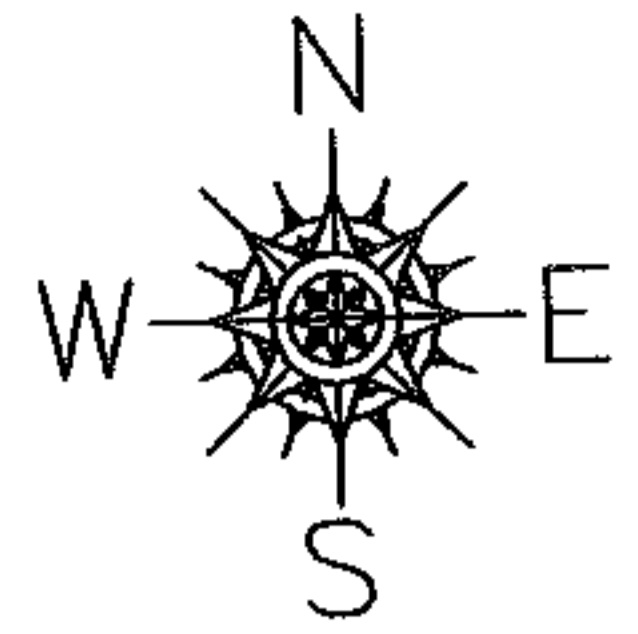

SPLITS/DEEDS PROCESSED

LORAIN COUNTY TAX MAP DEPARTMENT
 226 MIDDLE AVE. ELYRIA, OHIO

SURVEYED BY: RICHARD MACKAY
 CLOSURE: 0.00 : 10.000
 MAP PAGE(S): 07-00-001-C
 APPROVED BY: JAH DATE: 11-9-05
 SCALE: 1" = 600 PRIOR INSTRUMENT: OR 198/431