


PARENT PARCEL: 02-02-007-108-004

CHILD PARCEL:

10-02034-C



STARTING POINT: S/L 61 IN FOREST HILLS SUB. NO.3(VOL.23 PG.83)

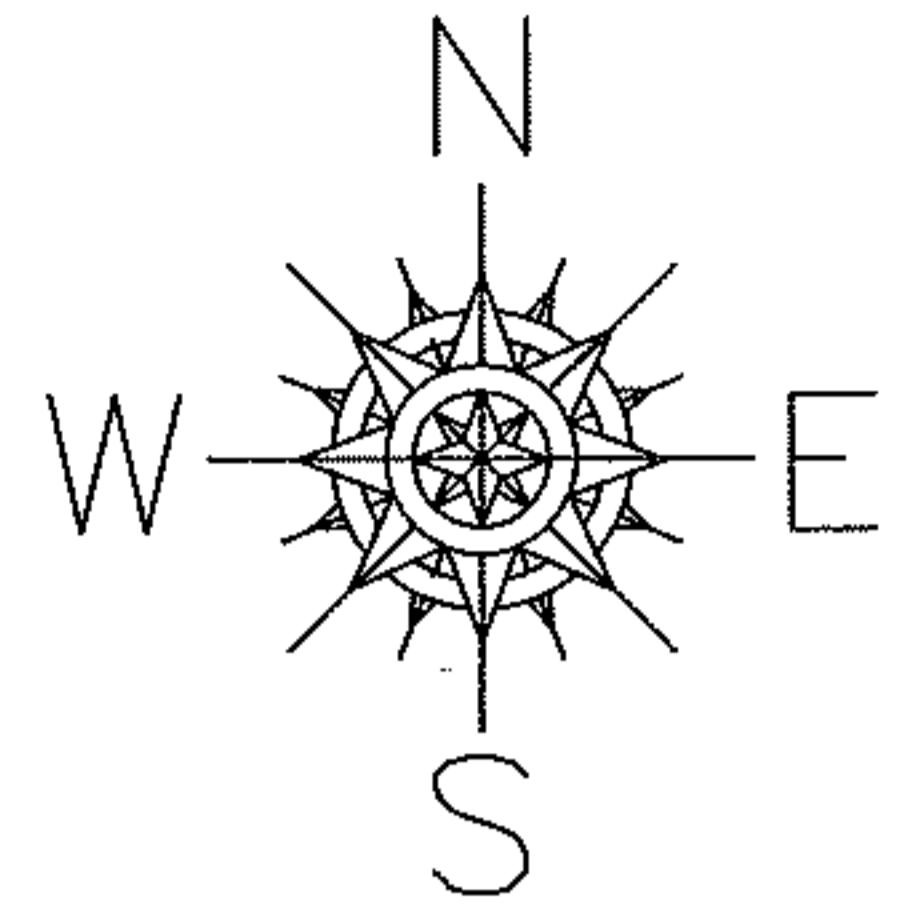

FRONTAGE AND DEPTH CORRECTION

02-02-007-108-004

71.42 X 156.93 CORR. PER. DEEDS
~~70.42 X 157~~

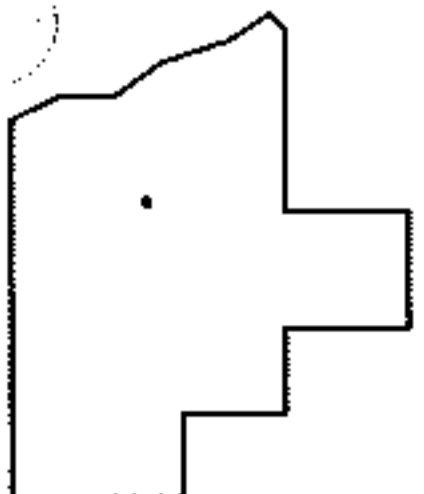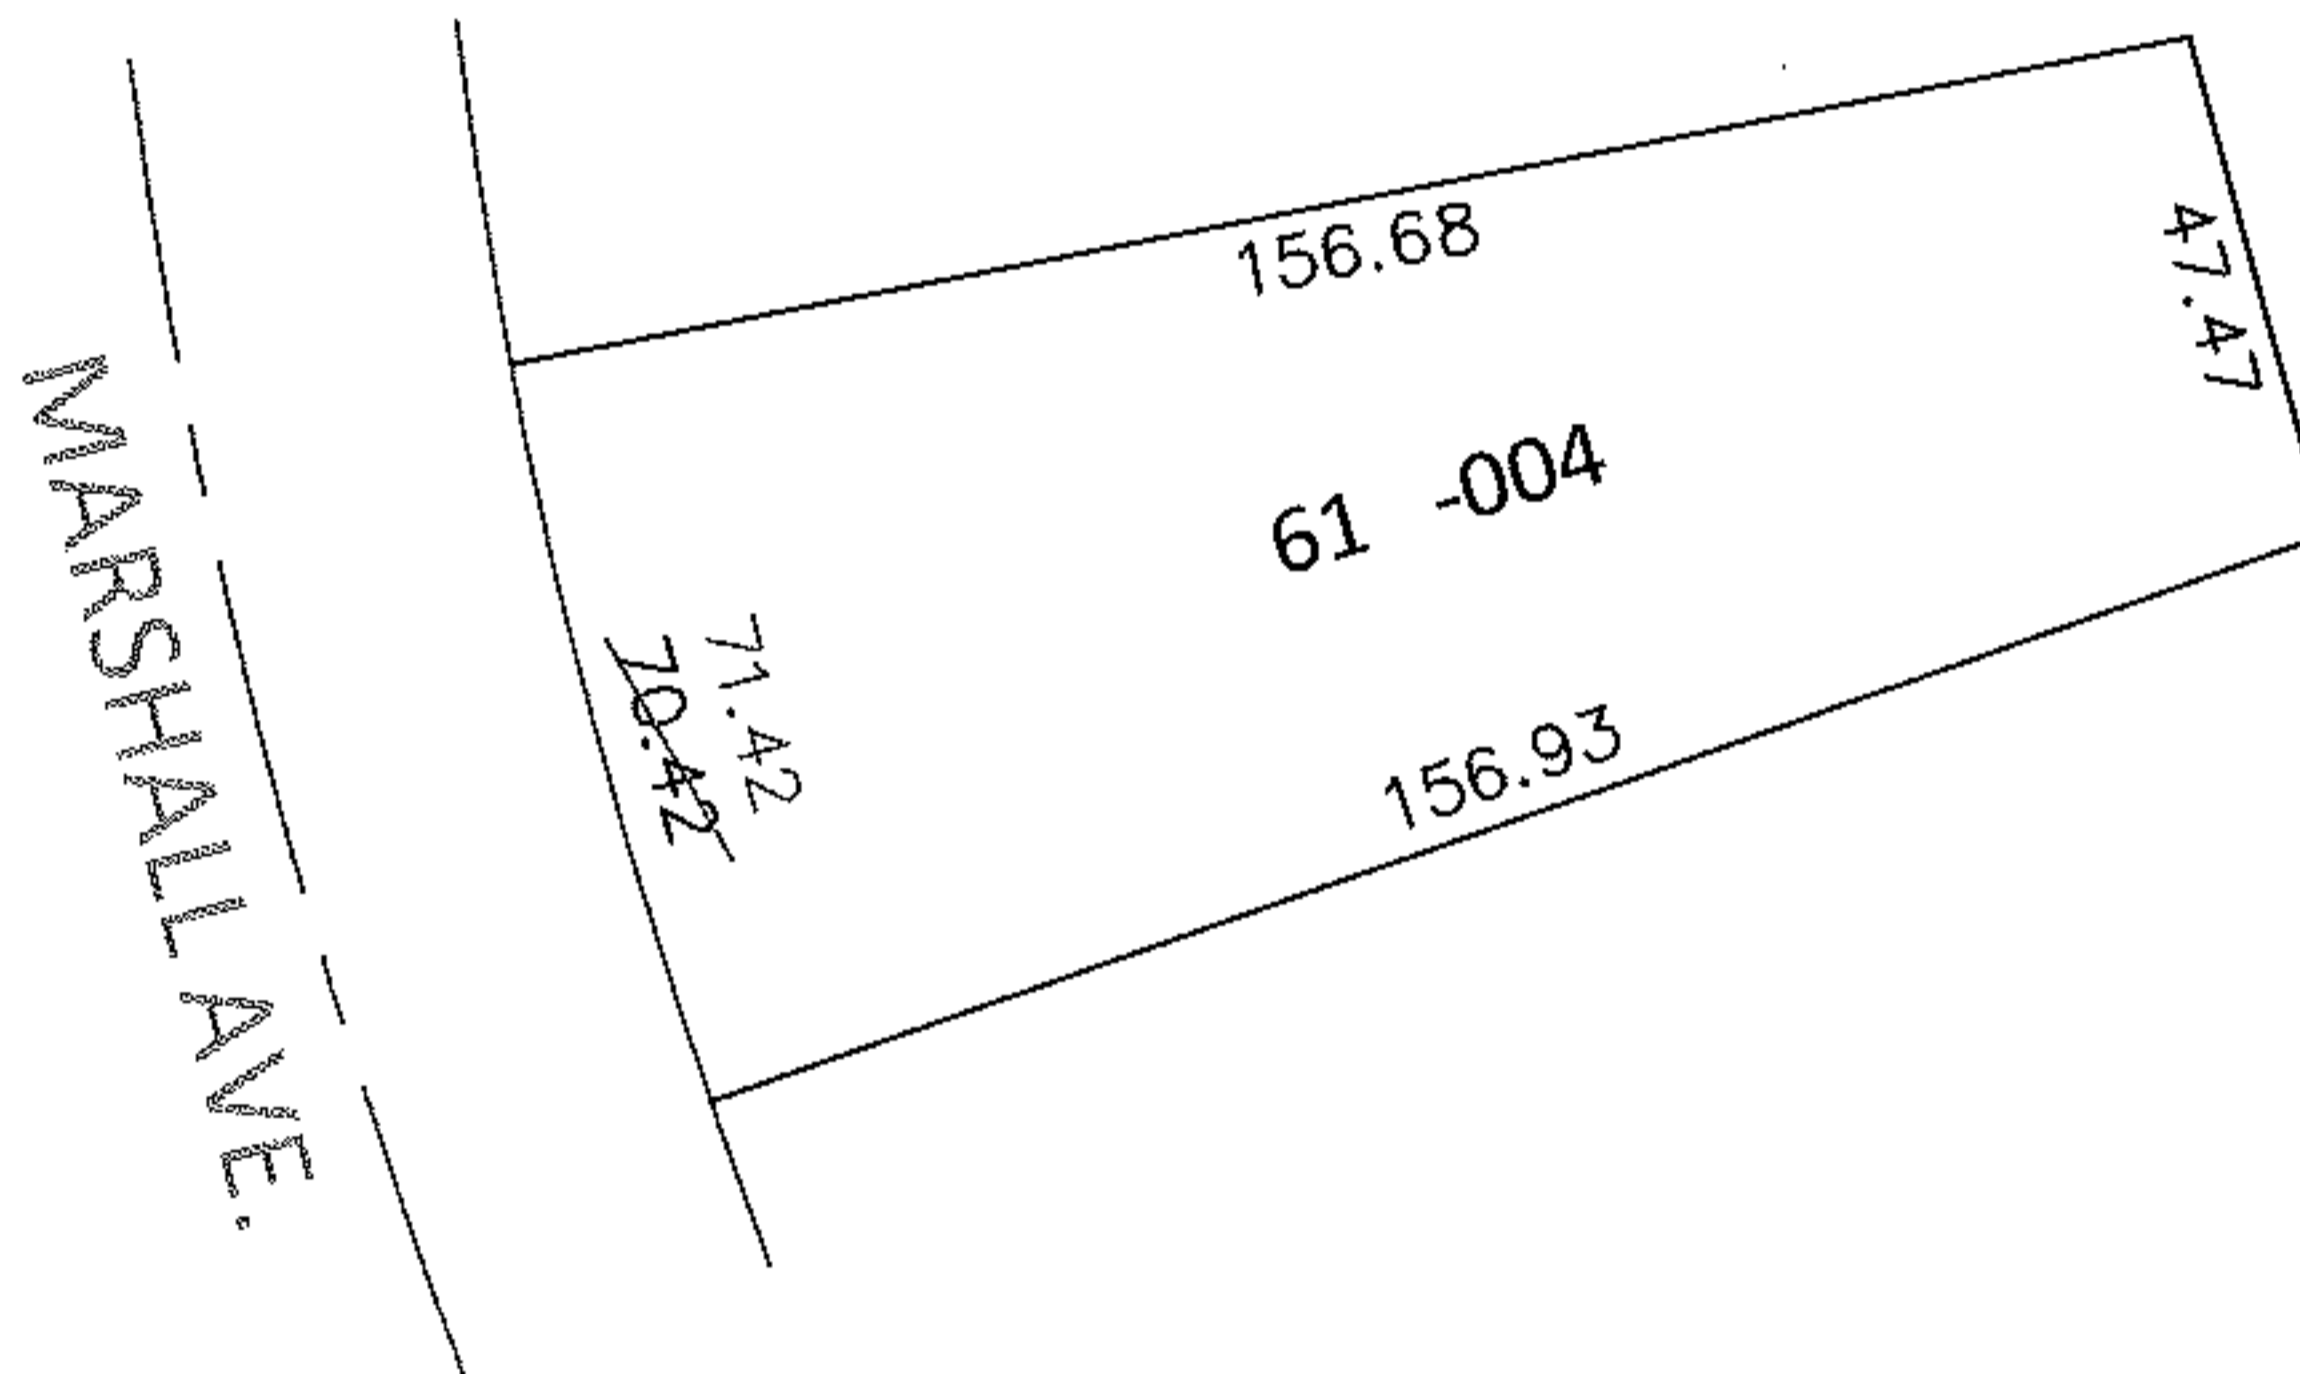

SPLITS/DEEDS PROCESSED

LORAIN COUNTY TAX MAP DEPARTMENT
226 MIDDLE AVE. ELYRIA, OHIO

SURVEYED BY: N/A

CLOSURE: N/A

MAP PAGE(S): 2-02-007-B

APPROVED BY: RRM DATE: 5-26-10

SCALE: 1" = 50' PRIOR INST.: PLAT 23/83