
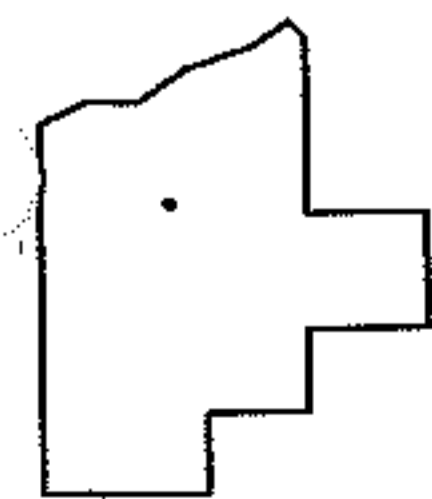
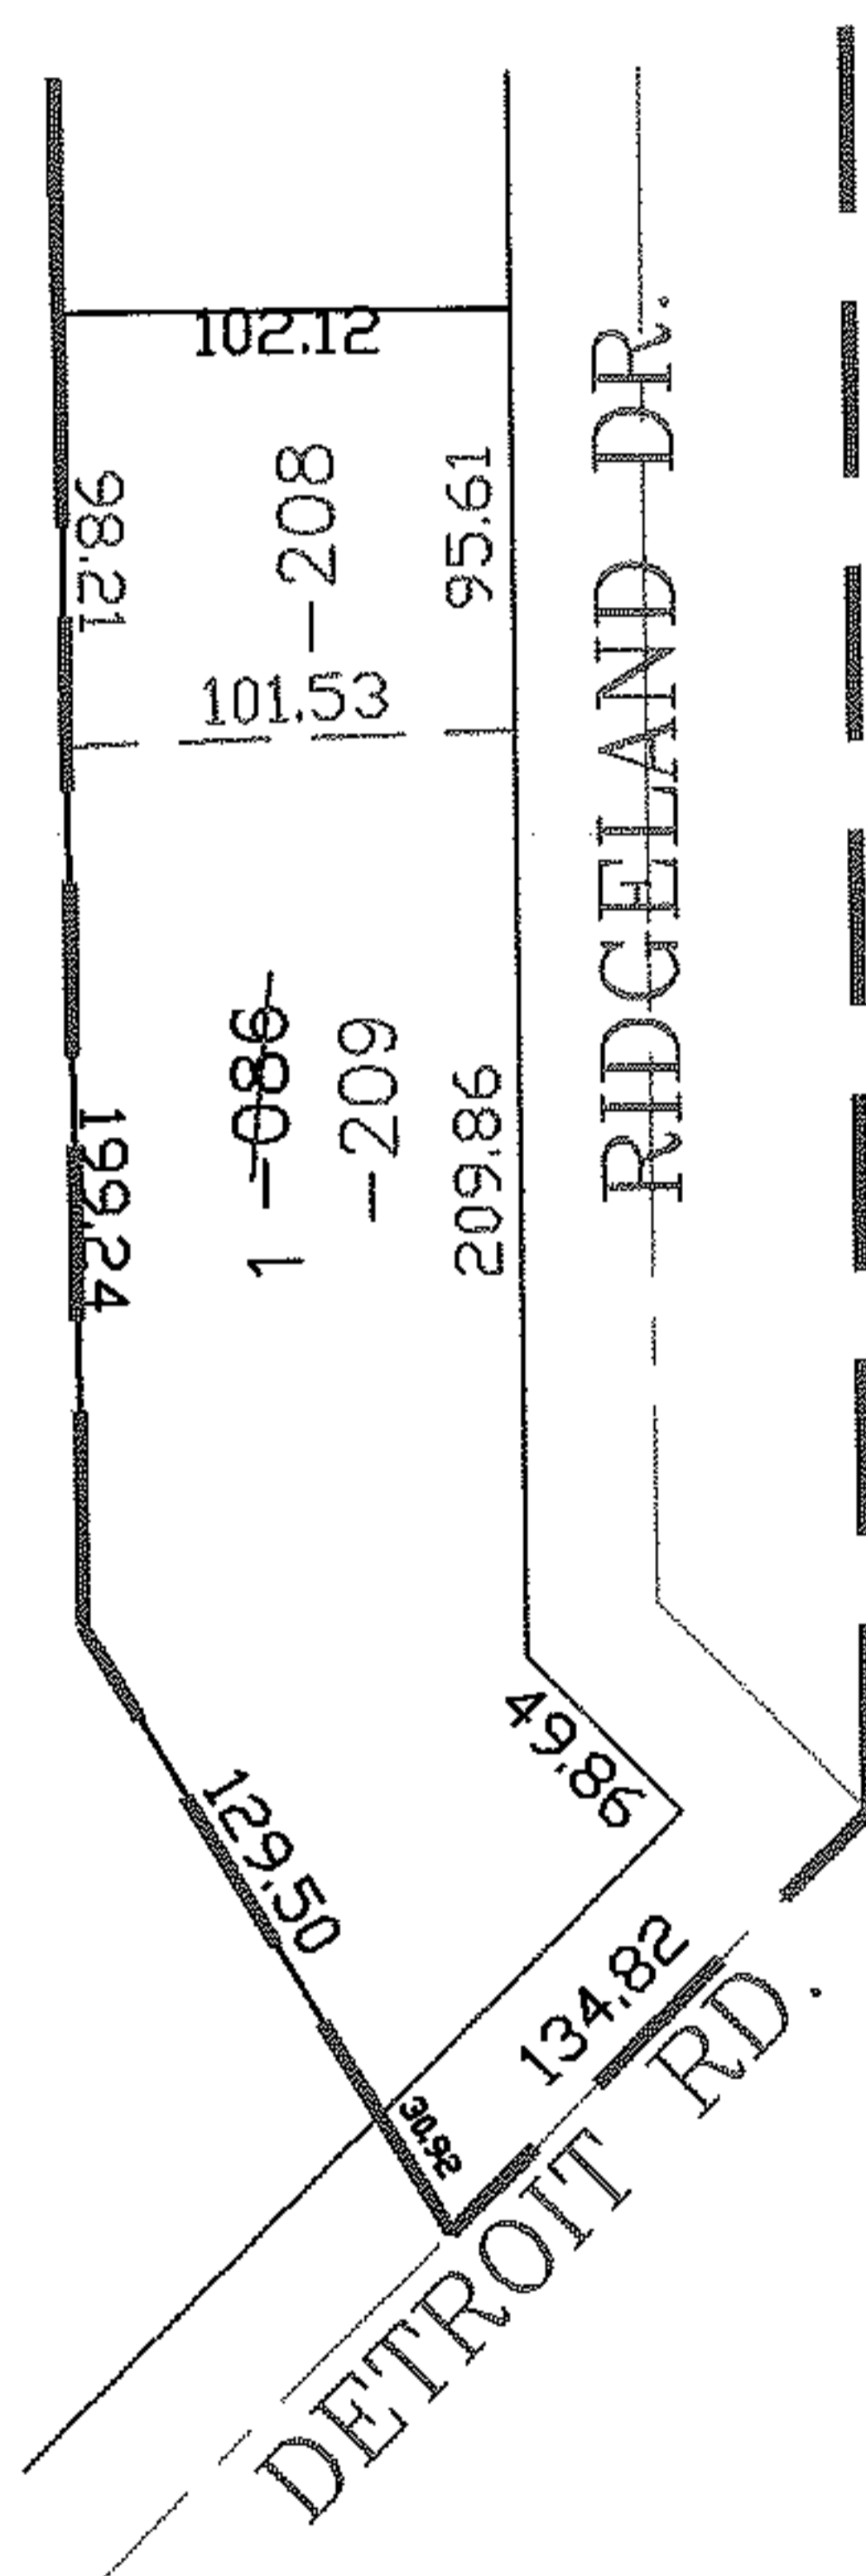


PARENT PARCEL: 04-00-010-111-086

CHILD PARCEL: 04-00-010-111-208, -209

STARTING POINT: CENTERLINE OF DETROIT RD. & RIDGELAND DR.

05-02034

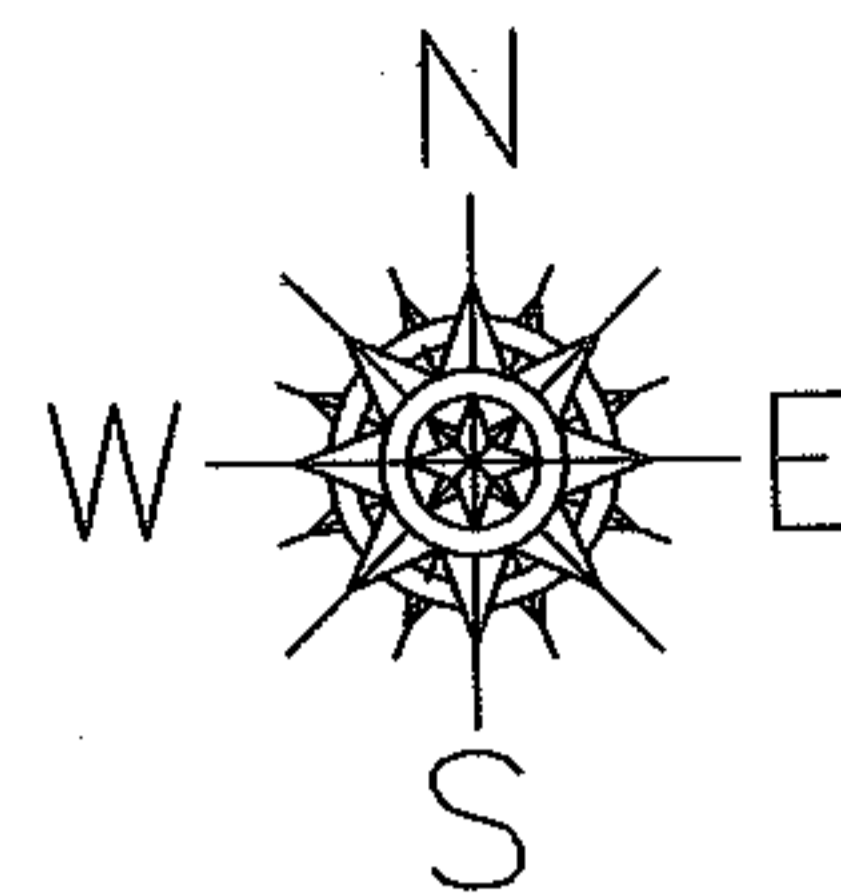

SPLITS/DEEDS PROCESSED

LORAIN COUNTY TAX MAP DEPARTMENT
226 MIDDLE AVE. ELYRIA, OHIO

SURVEYED BY: CHRISTOPHER HIRZEL

CLOSURE: 0.00 : 10,000

MAP PAGE(S): 04-00-010-G

APPROVED BY: JAH DATE: 11-1-05

SCALE: 1" = 100 PRIOR INSTRUMENT: 19990618010