
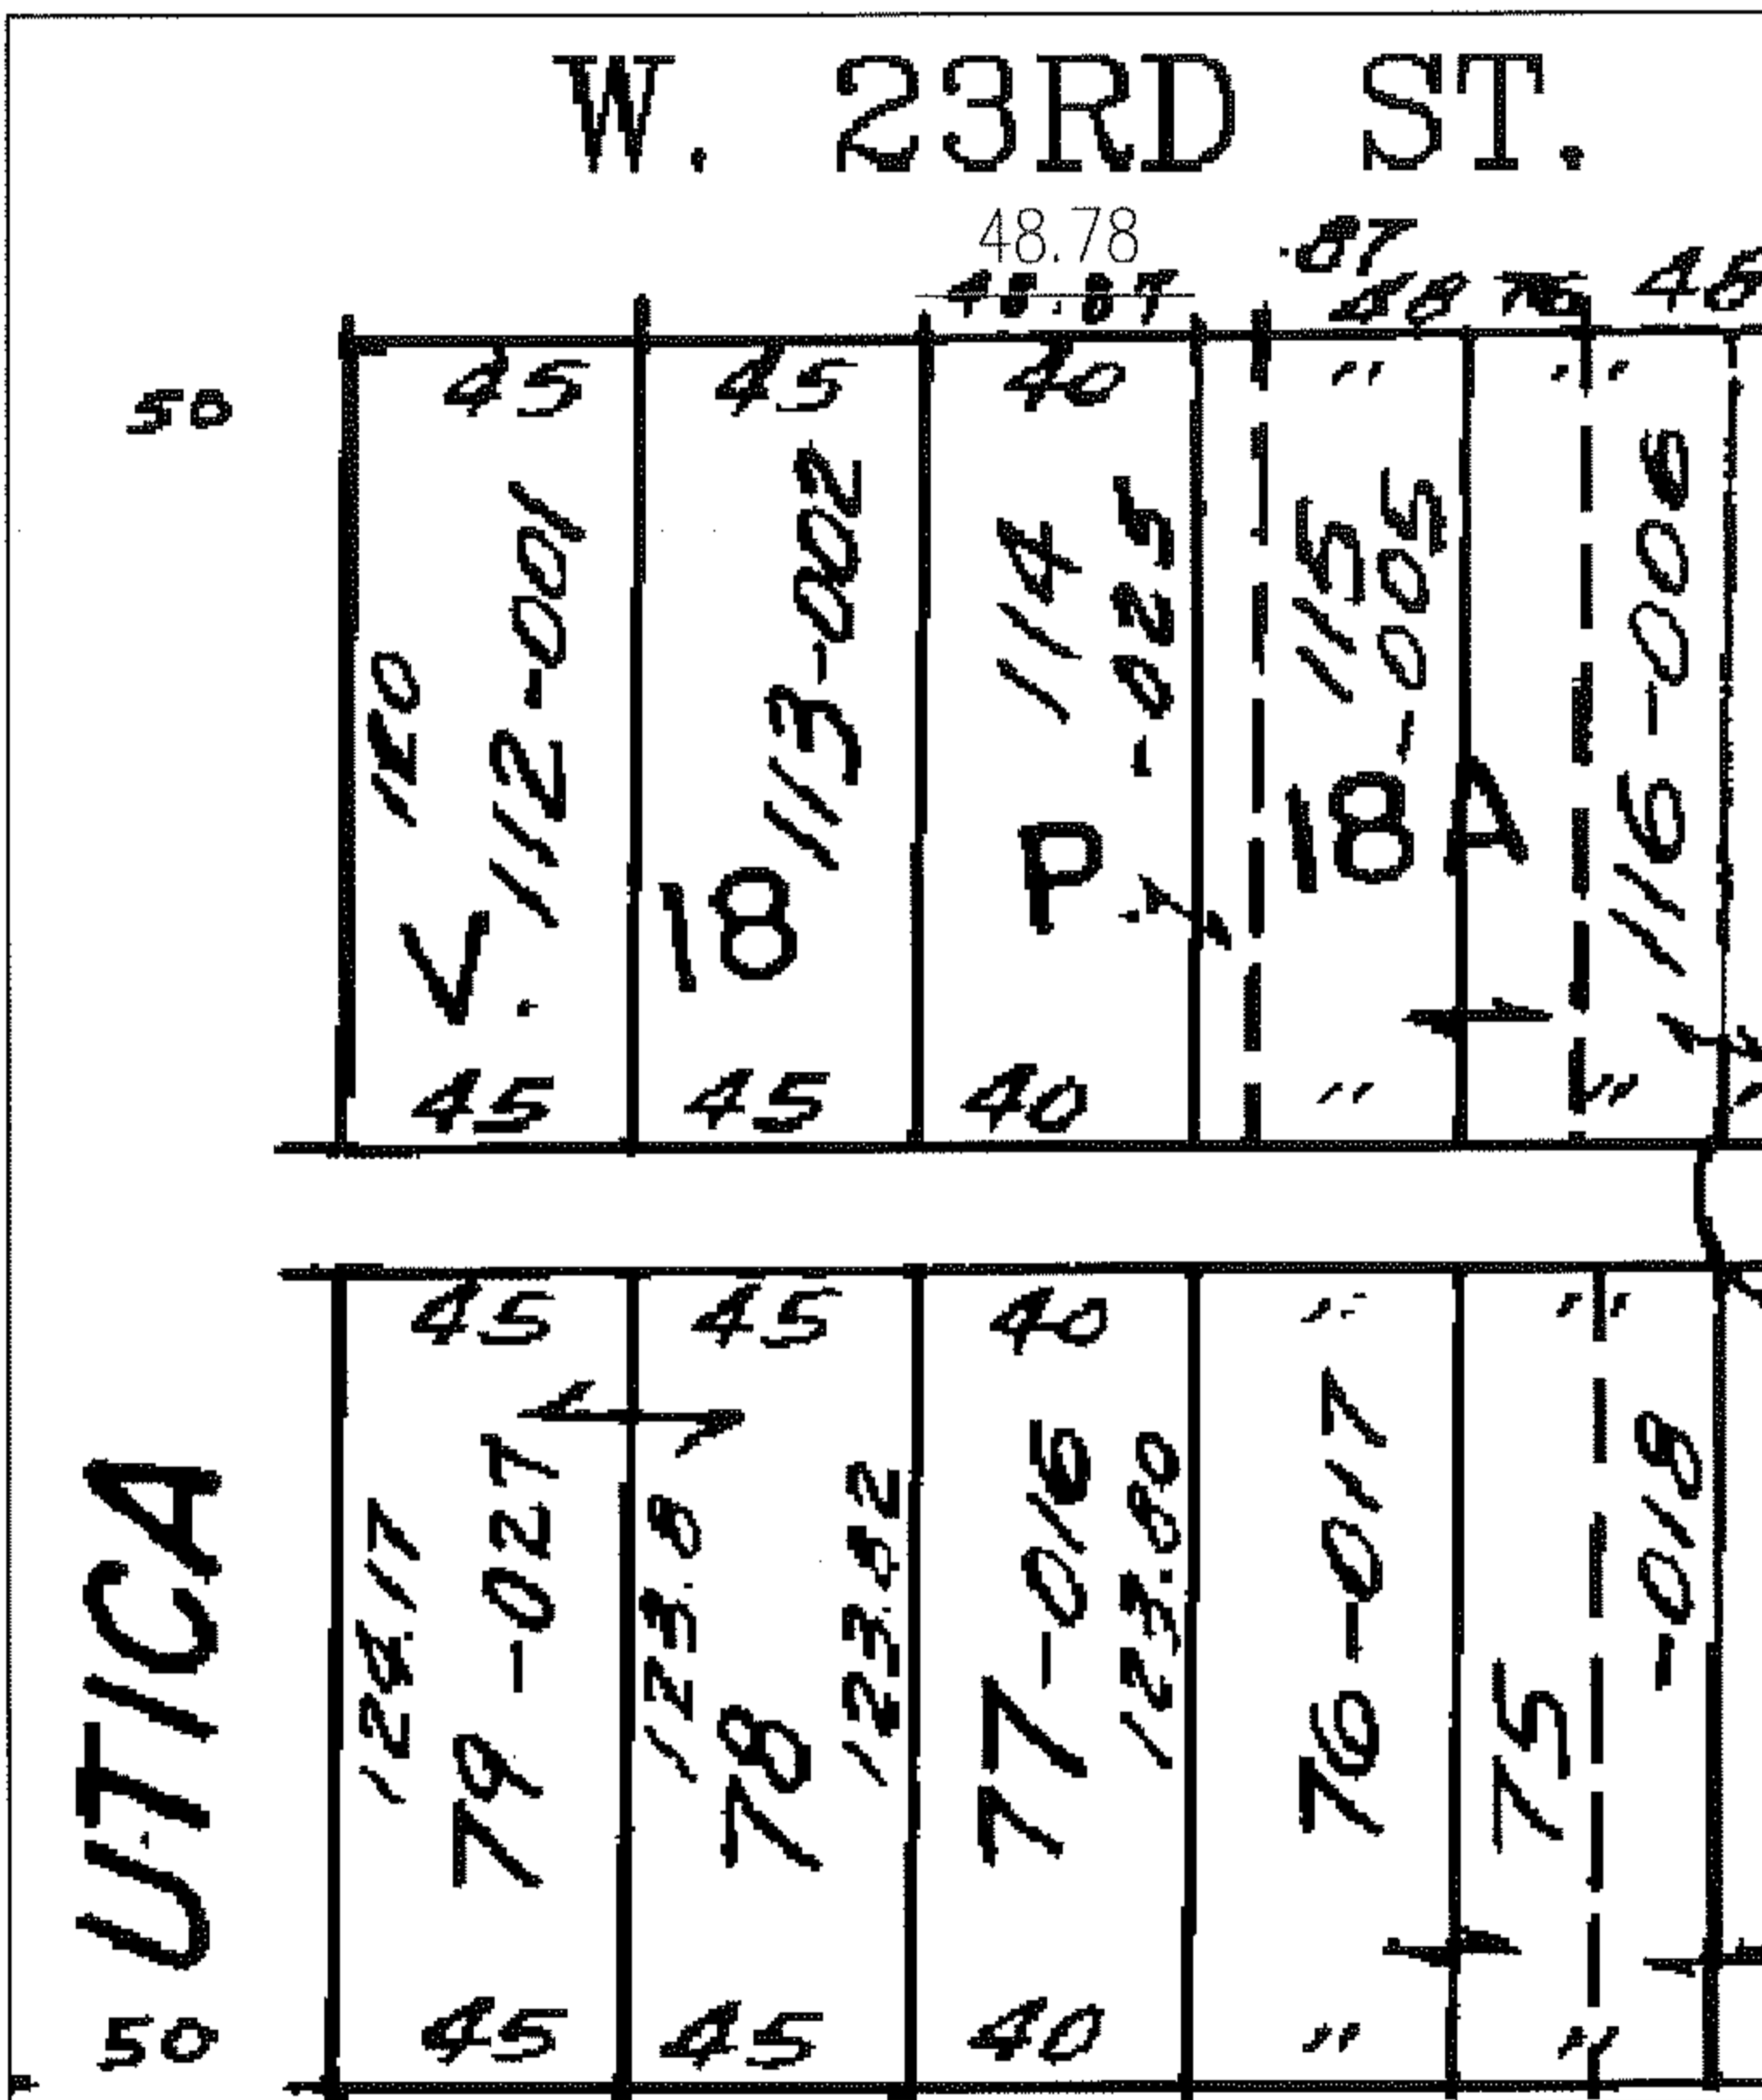


PARENT PARCEL: 02-02-016-105-025
 CHILD PARCEL: XX-XX-XXX-XXX-XXX
 STARTING POINT: N.W.CORNER OF S/L 114 IN OBERLIN AVE. CO. ADD. NO. 2 (V. 18 PG. 18A)

10-02036-C

FRONTAGE CORRECTION

02-02-016-105-025
~~48.87 X 120.00~~
 48.78 X 120.00
 CORR. PER DEED
 20010780208

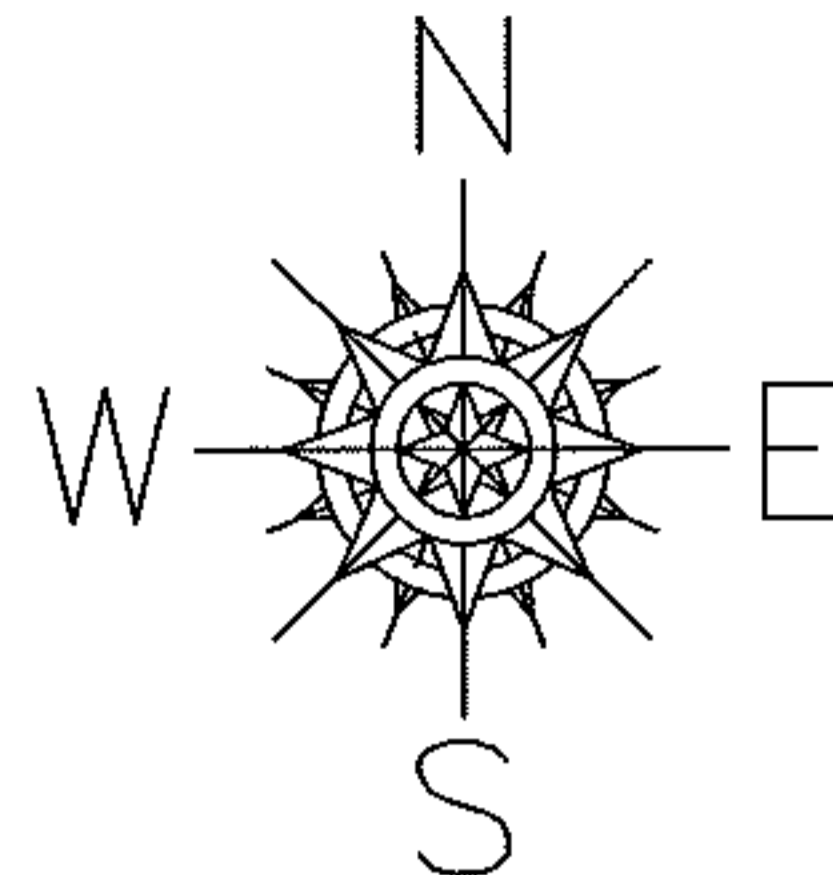

SPLITS/DEEDS PROCESSED

LORAIN COUNTY TAX MAP DEPARTMENT
 226 MIDDLE AVE. ELYRIA, OHIO

SURVEYED BY: NONE
 CLOSURE: NONE
 MAP PAGE(S): 02-02-016-A
 APPROVED BY: TJS DATE: 6/7/10
 SCALE: 1"= 50' PRIOR INST.: OR 1026/758