
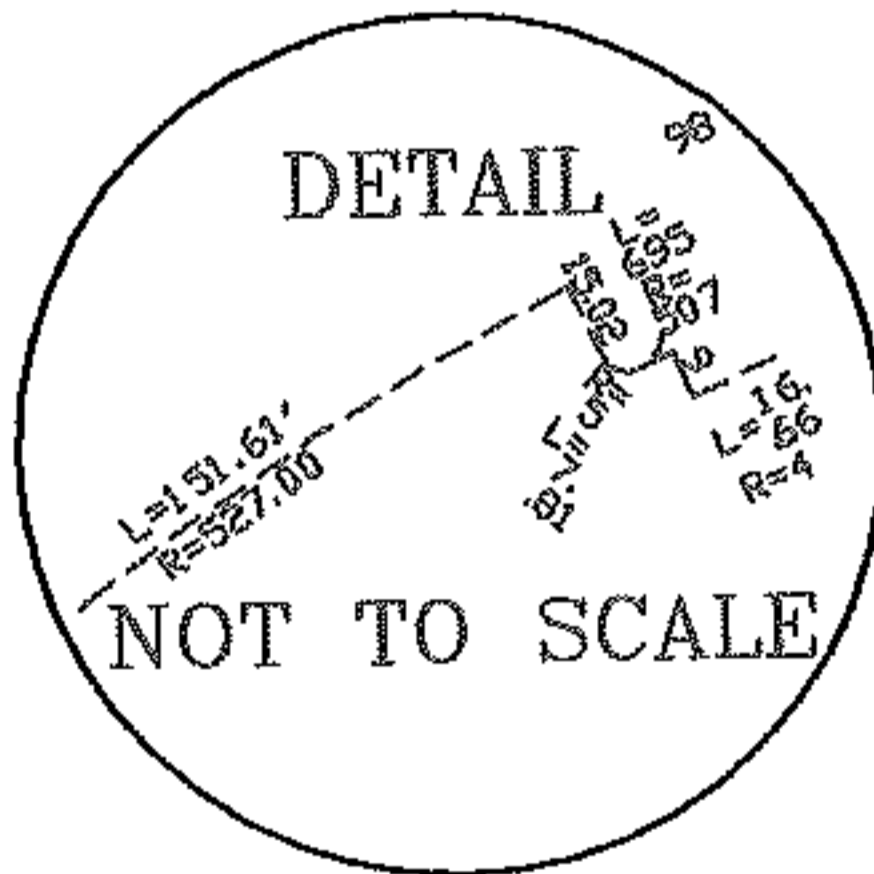
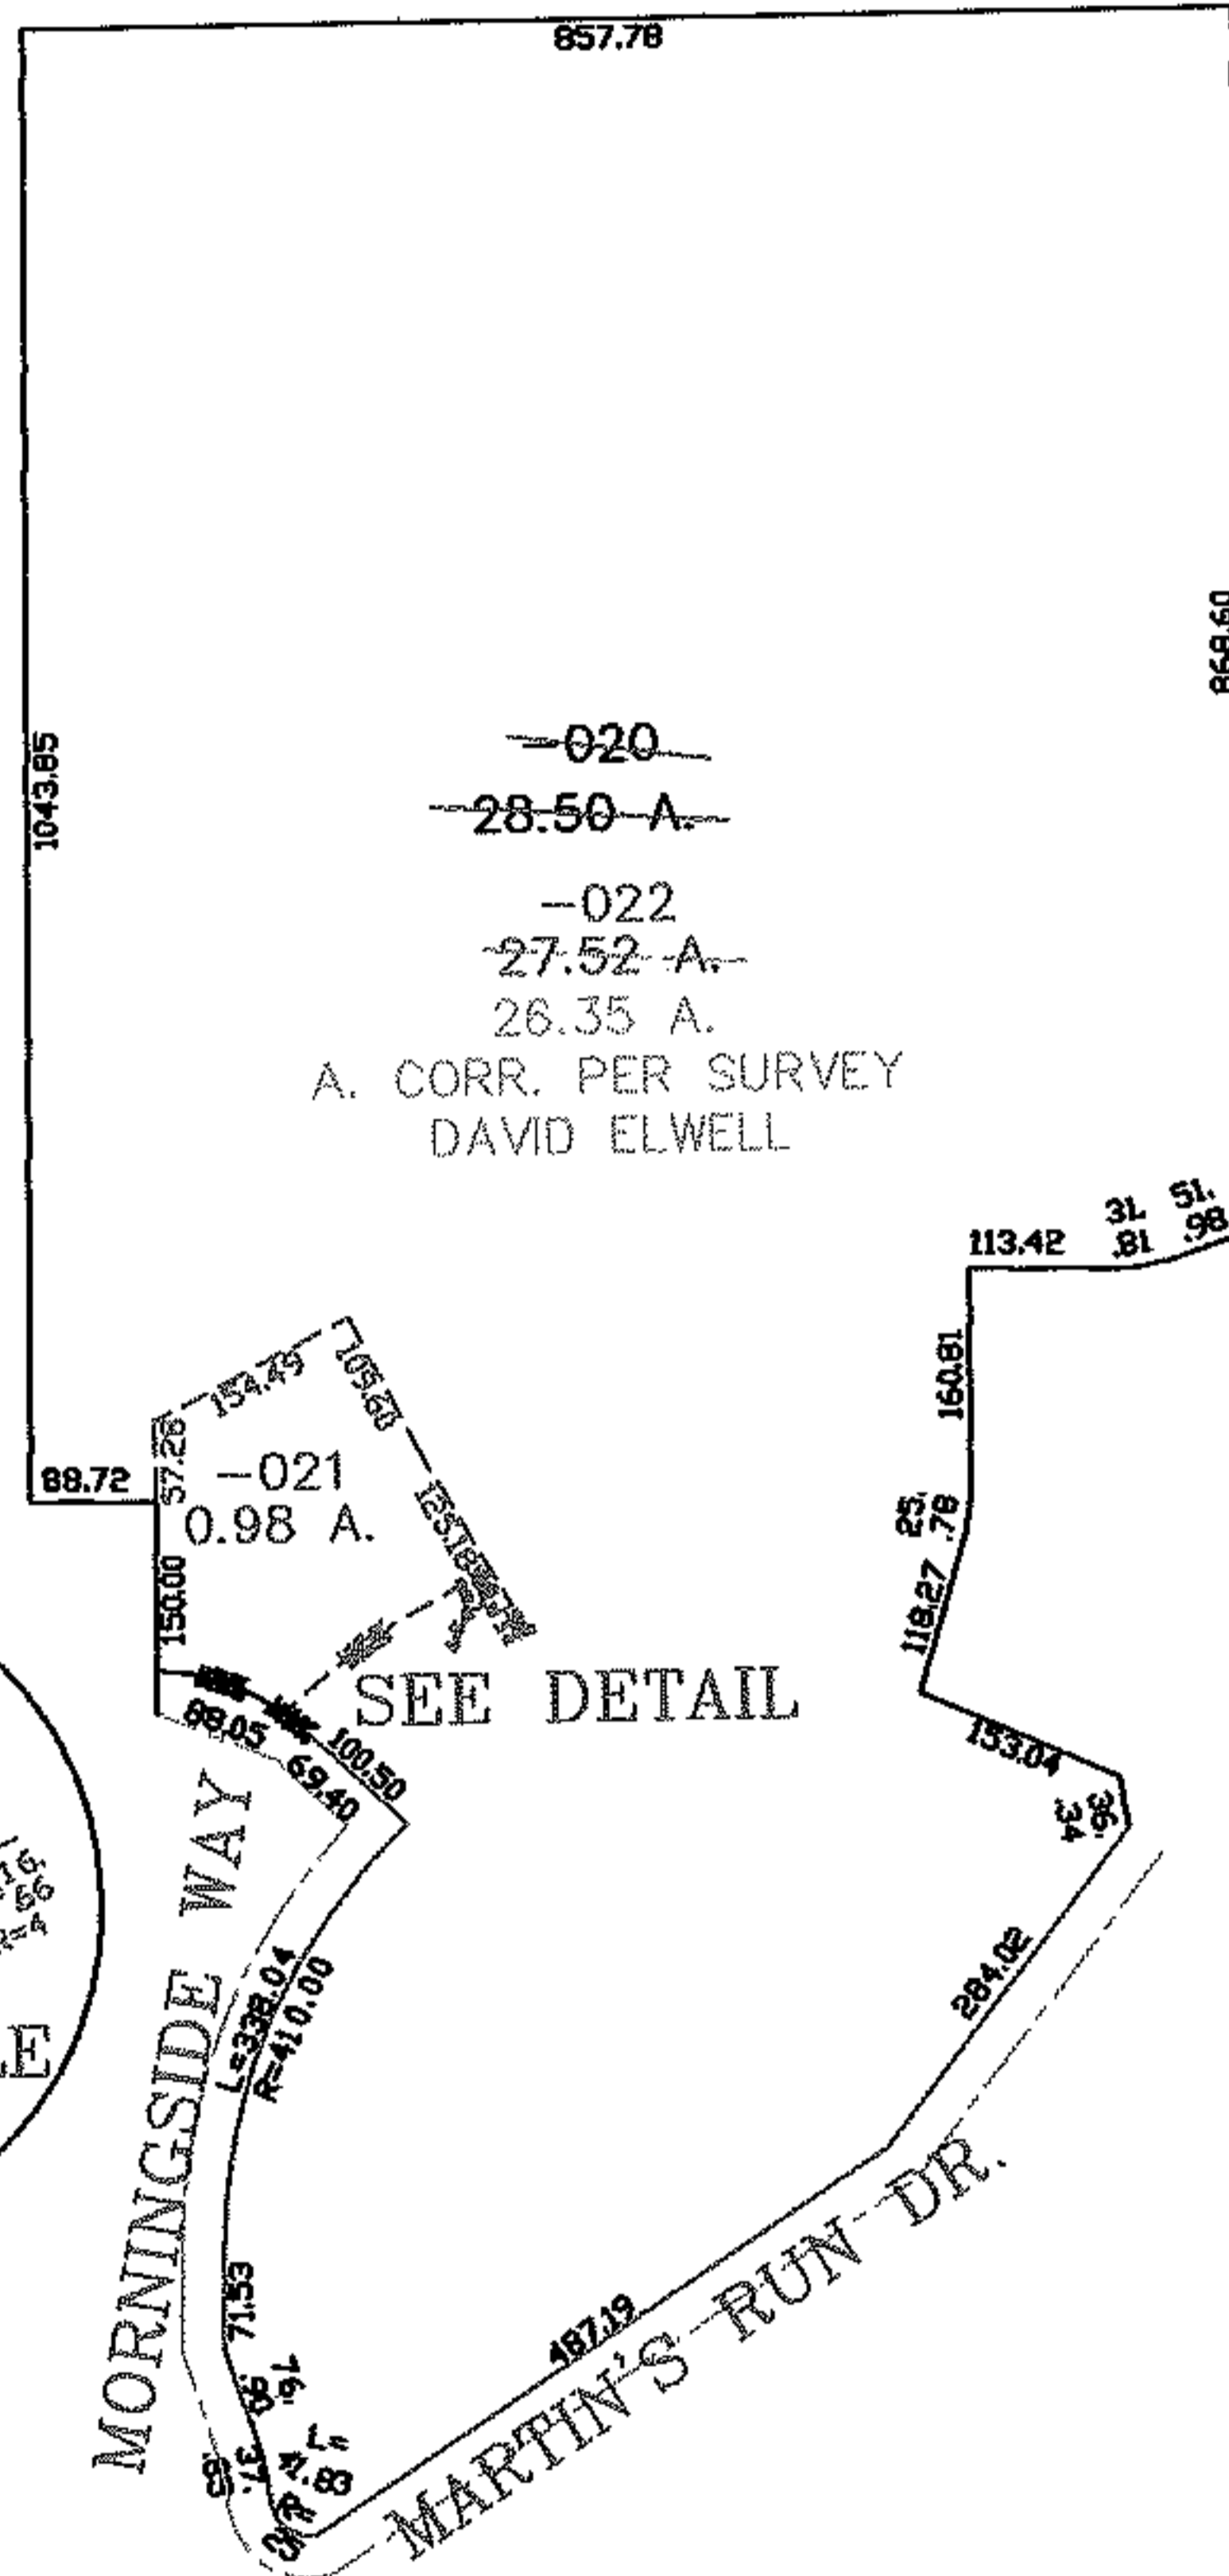


PARENT PARCEL: 02-03-001-111-020

CHILD PARCEL: 02-03-001-111-021, -022

STARTING POINT: CENTERLINE OF MORNINGSIDE WAY & CARDINAL CT.

05-02037

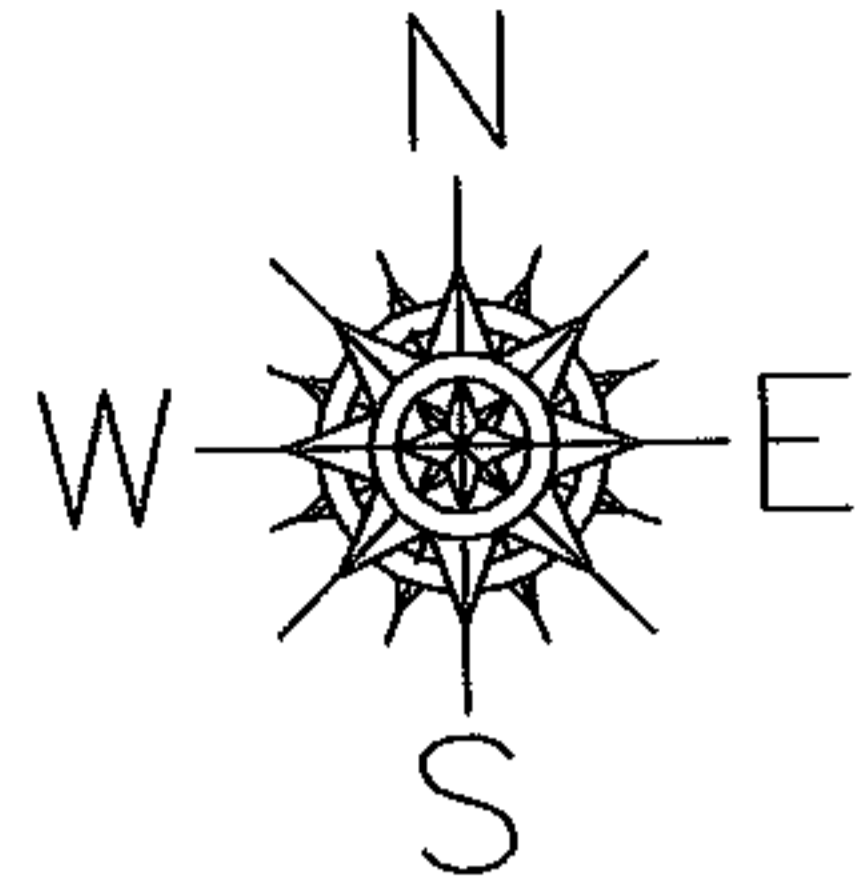

SEE DETAIL

SURVEYED BY: DAVID ELWELL

CLOSURE: 0.00 : 10.000

MAP PAGE(S): 02-03-001-B

APPROVED BY: JAH DATE: 11-2-05

SCALE: 1" = 300 PRIOR INSTRUMENT: 20040006210

SPLITS/DEEDS PROCESSED

LORAIN COUNTY TAX MAP DEPARTMENT
226 MIDDLE AVE. ELYRIA, OHIO