


RASTER

PARENT PARCEL: 06-25-159-000-015


CHILD PARCEL: 06-25-159-000-016, -017

STARTING POINT: S/L 46 & 47 OF ELYWOODS SUBD. NO 4


05-02039

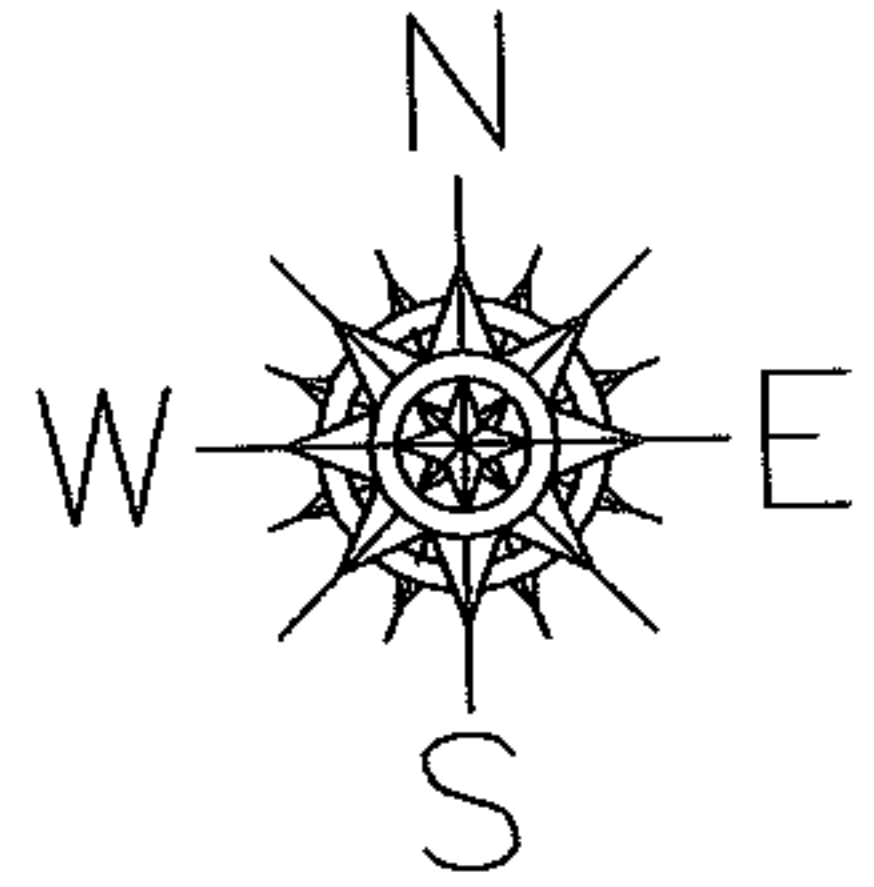

ELYWOOD SUBD. NO 4
VOL 15 PG 11

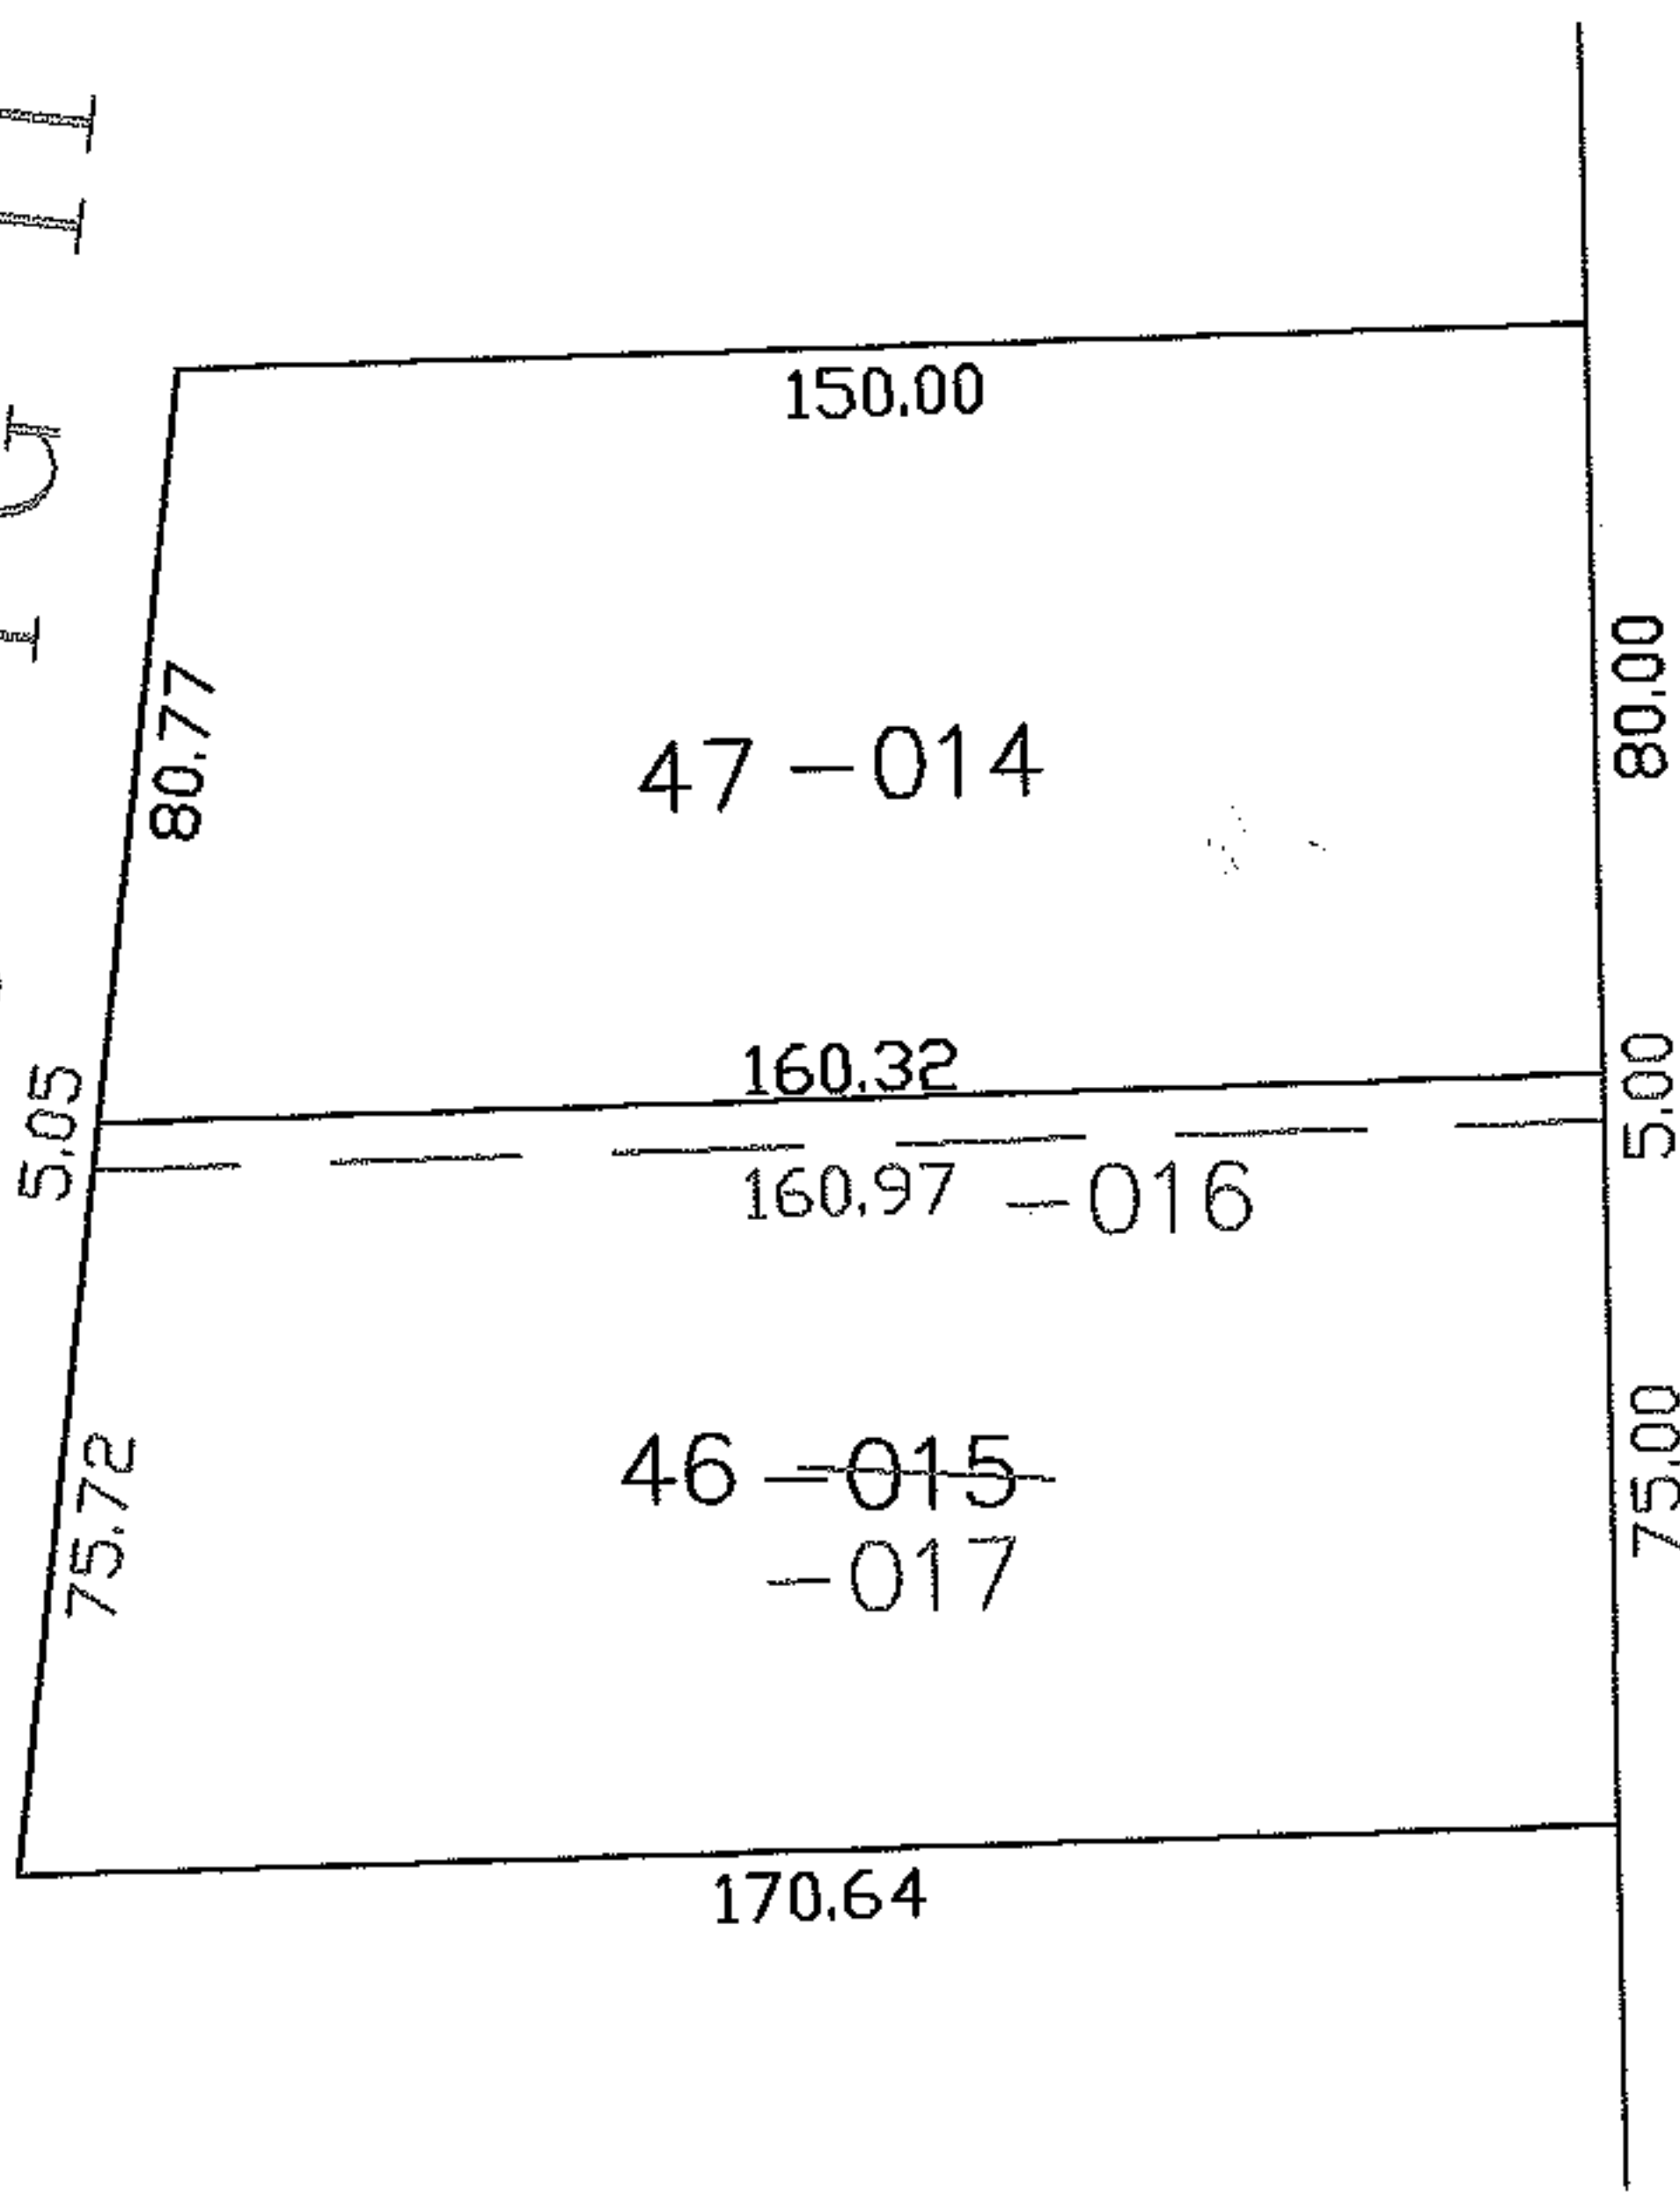

GLENWOOD ST.

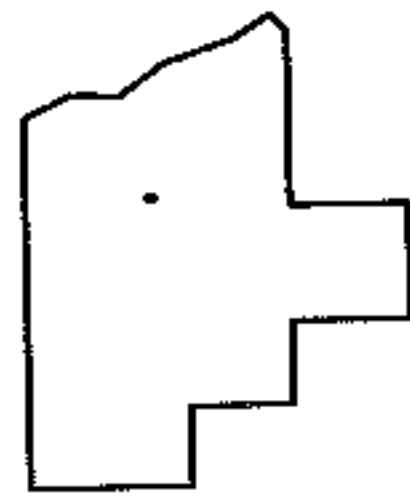

SPLITS/DEEDS PROCESSED

LORAIN COUNTY TAX MAP DEPARTMENT
226 MIDDLE AVE. ELYRIA, OHIO

SURVEYED BY: RICHARD CARLSON
CLOSURE: 0.00 : 10.000
MAP PAGE(S): 6-84
APPROVED BY: JAH DATE: 11-8-05
SCALE: 1" = 100 PRIOR INSTRUMENT: PL VOL 15/11