



RASTER

PARENT PARCEL: 04-00-030-111-049

CHILD PARCEL: 04-00-030-111-062, -063

STARTING POINT: CENTERLINE OF SOUTHPOINT DR. & LAKEVIEW DR.

05-02044

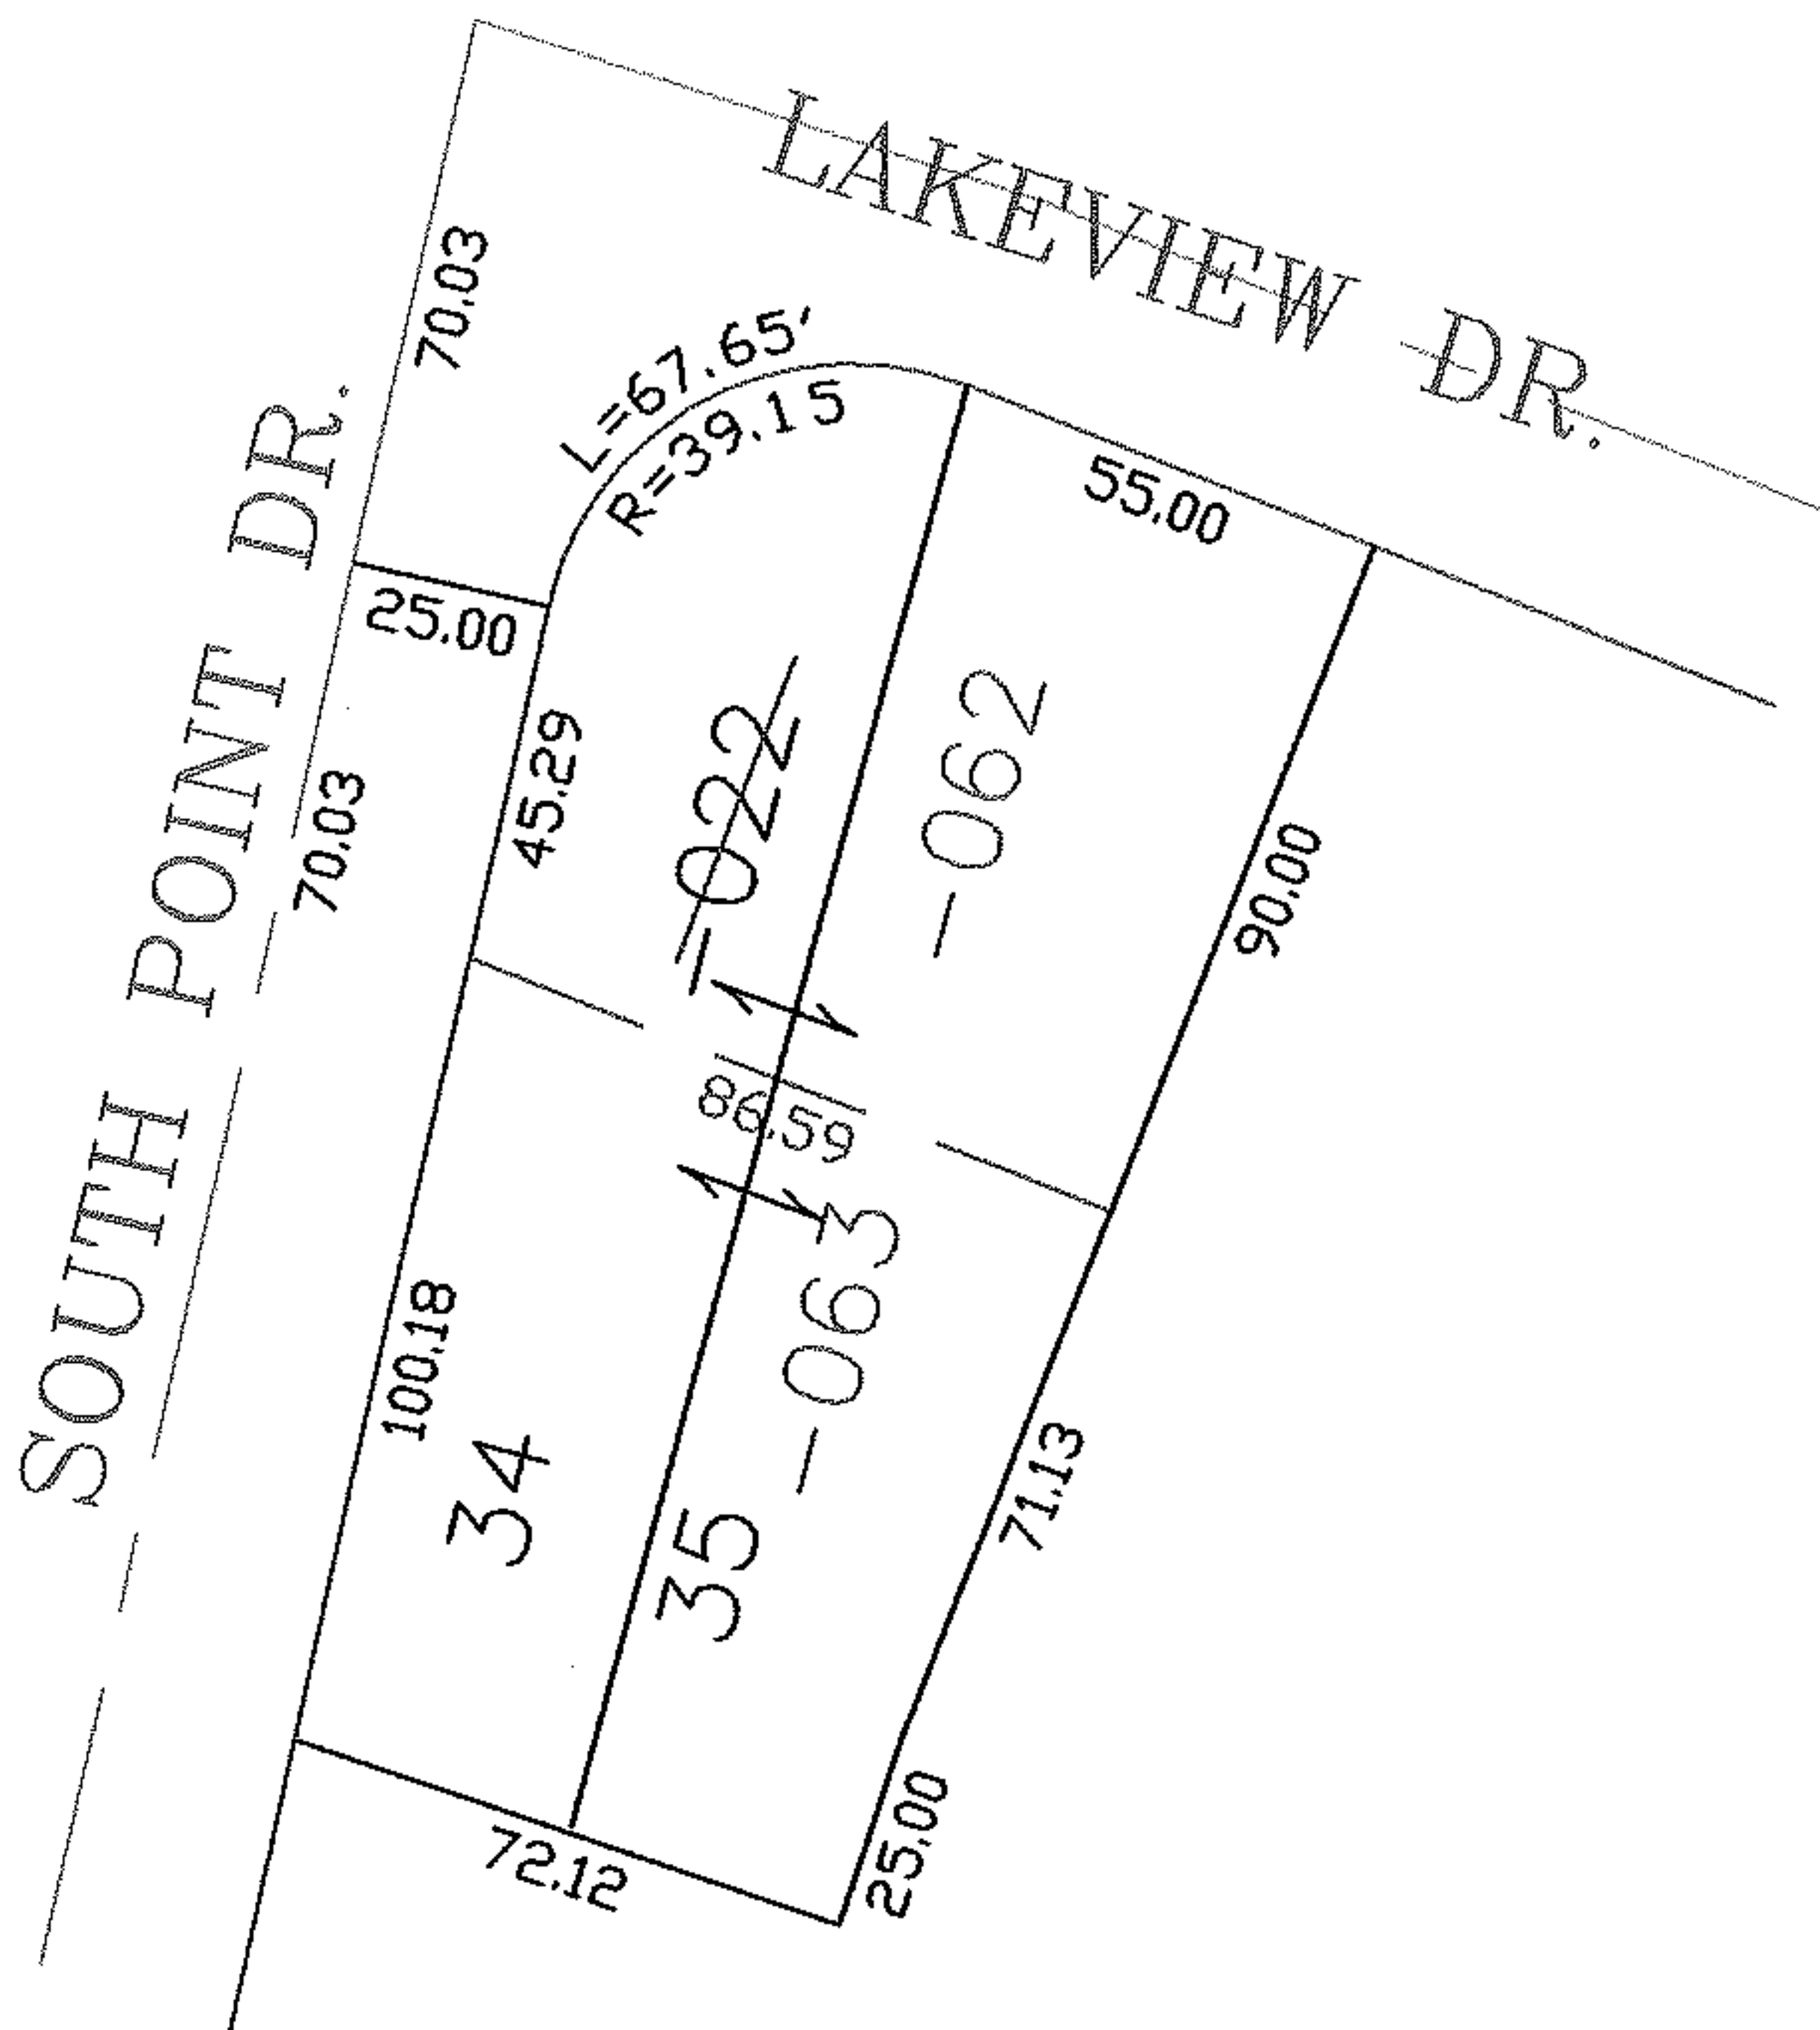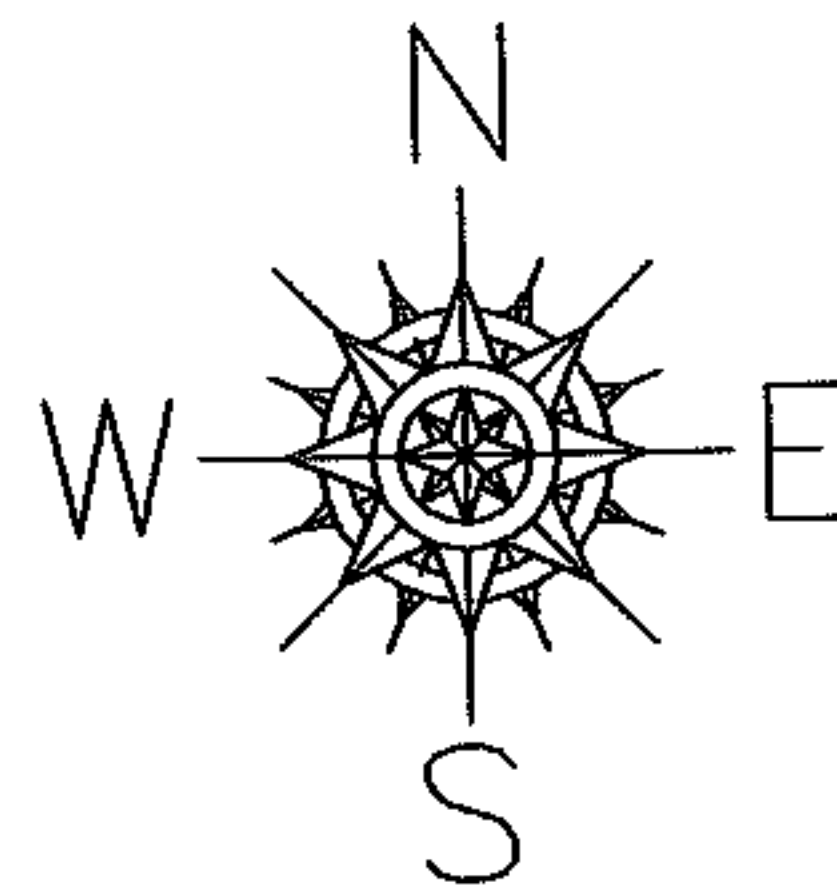

SPLITS/DEEDS PROCESSED

LORAIN COUNTY TAX MAP DEPARTMENT
226 MIDDLE AVE. ELYRIA, OHIO

SURVEYED BY: GEORGE A. HOFMANN

CLOSURE: 0.00 : 10.000

MAP PAGE(S): 04-00-030-A

APPROVED BY: JAH DATE: 11-21-05

SCALE: 1" = 100 PRIOR INSTRUMENT: 20030887639