


RASTER

PARENT PARCEL: 06-25-001-000-078


CHILD PARCEL: 06-25-001-000-234, -235

STARTING POINT: MICHAEL PKWY & SUGAR LANE

05-02045

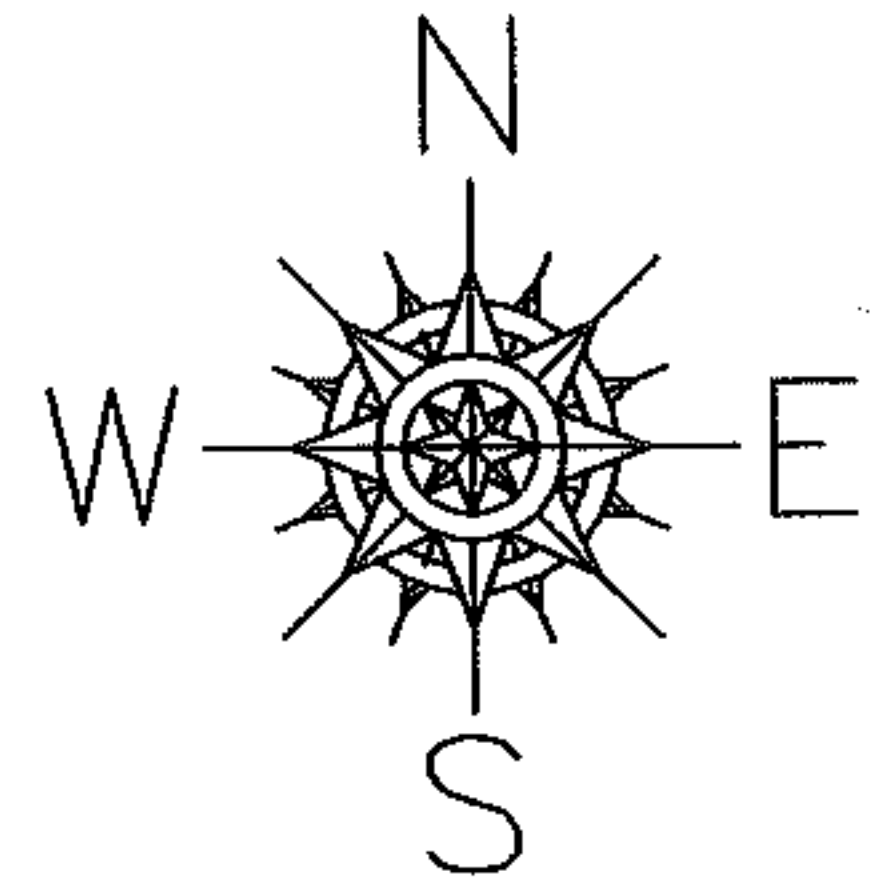

MICHAEL PKWY

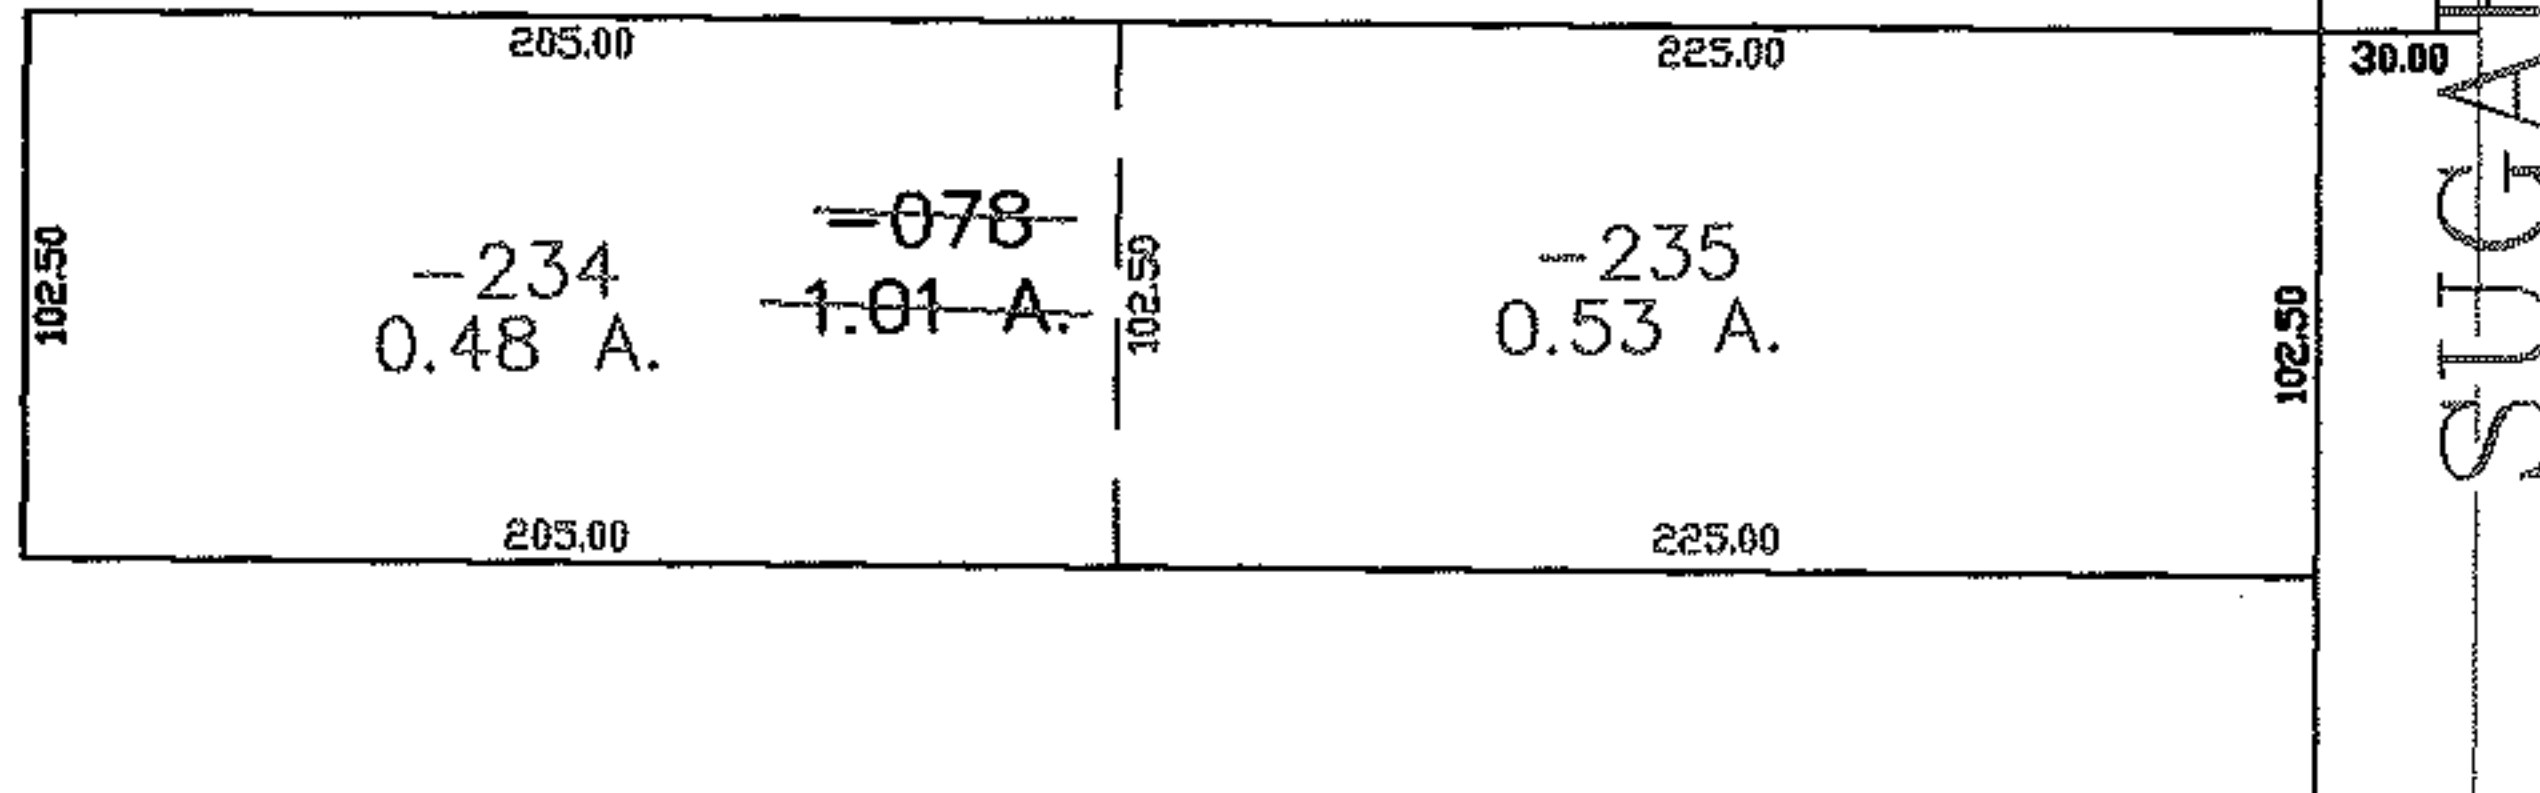

SPLITS/DEEDS PROCESSED

LORAIN COUNTY TAX MAP DEPARTMENT  
226 MIDDLE AVE. ELYRIA, OHIO

SURVEYED BY: THOMAS SIMON

CLOSURE: 0.00 : 10,000

MAP PAGE(S): 6-143

APPROVED BY: JAH DATE: 11-21-05

SCALE: 1" = 100 PRIOR INSTRUMENT: 20050091192