


PARENT PARCEL: 02-02-004-106-017

CHILD PARCEL: _____

10-02048-C

STARTING POINT: INTERSECTION OF NORTH LINE OF S/L 2 IN WILLIAMSBURG HEIGHTS SUB. NO.1 (VOL.24 PG.24) AND THE WEST LINE OF WILLIAMSBURG DR.


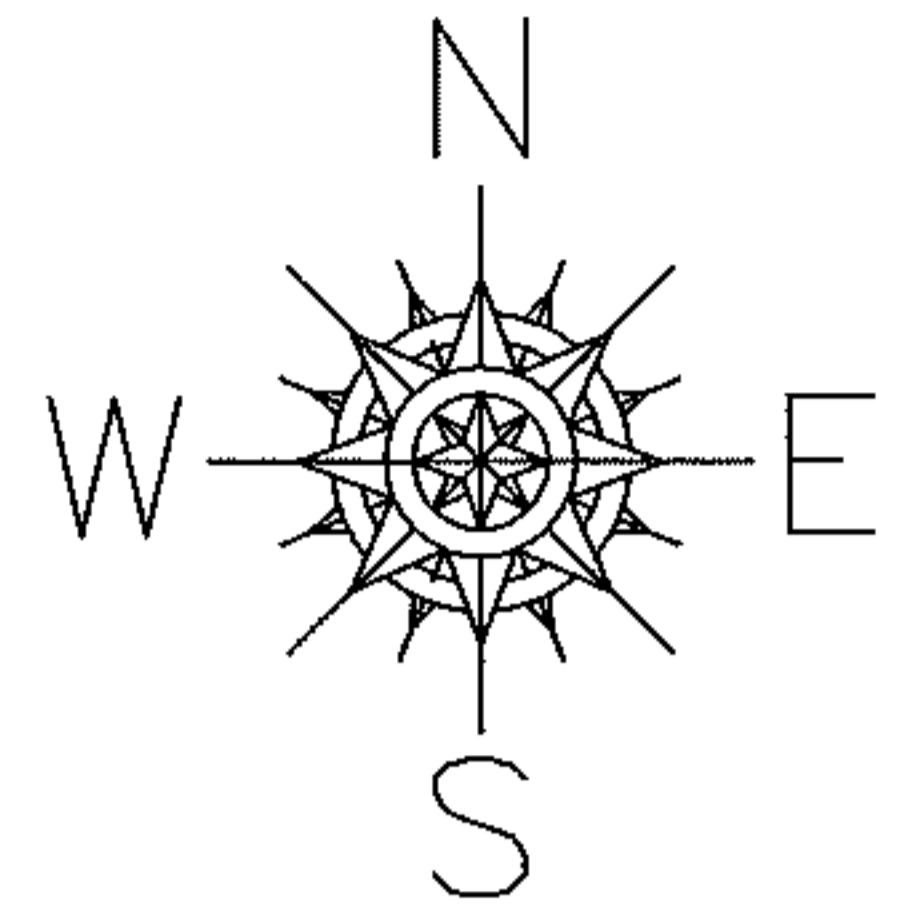


FRONTAGE AND DEPTH CORRECTION

02-02-004-106-017

55.04 X 143.34 CORR. PER. SURV.

~~56.54 X 143.62~~ R.HOLLIS

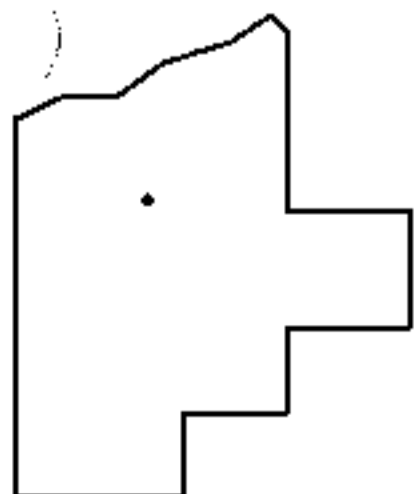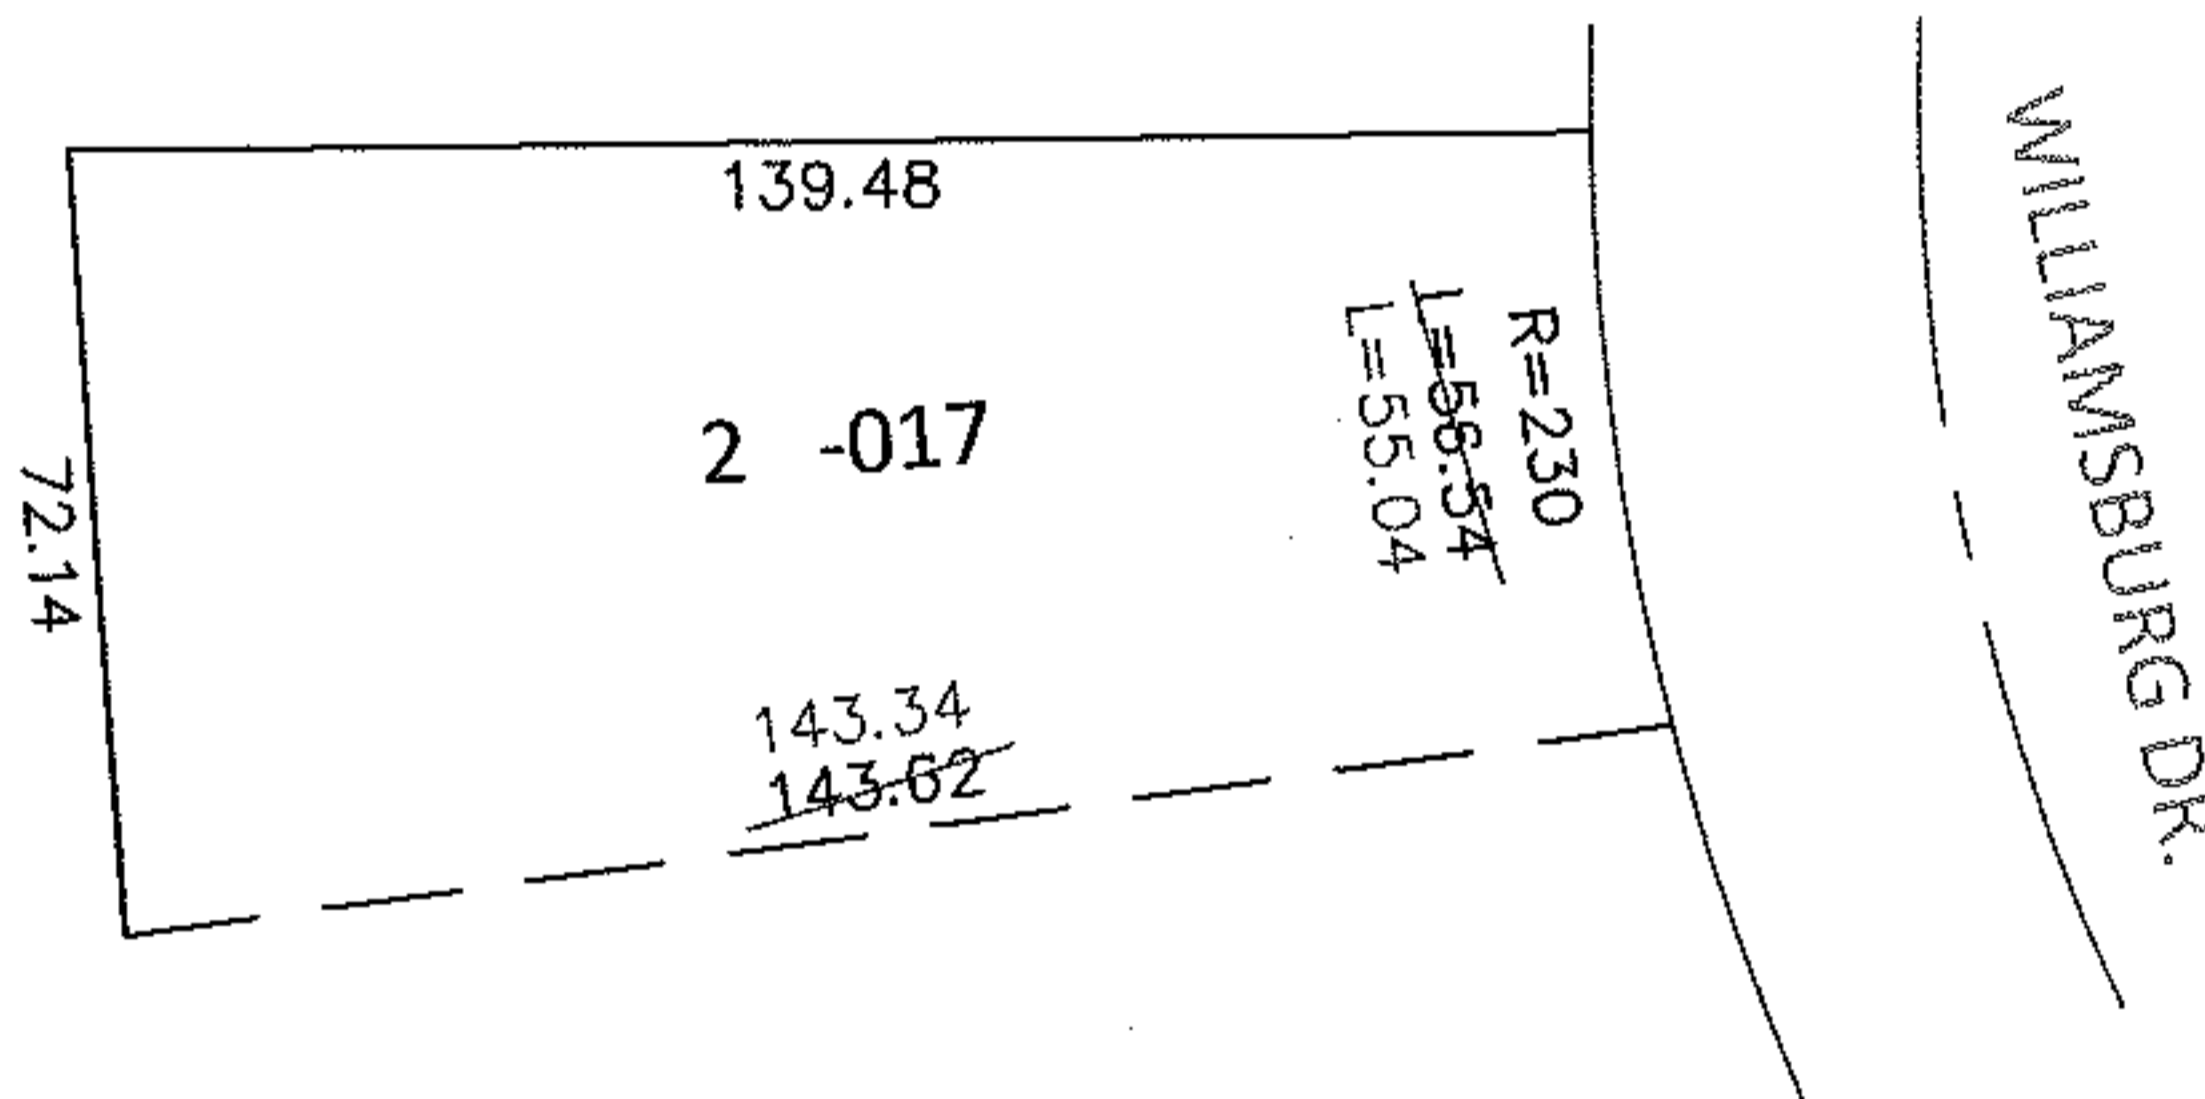

SPLITS/DEEDS PROCESSED

LORAIN COUNTY TAX MAP DEPARTMENT
226 MIDDLE AVE. ELYRIA, OHIO

SURVEYED BY: RAY E. HOLLIS

CLOSURE: .00:10,000

MAP PAGE(S): 2-02-004-A

APPROVED BY: RRM DATE: 6-25-10

SCALE: 1"= 50' PRIOR INST.: 20070212092