


RASTER

05-02048


PARENT PARCEL: 15-00-045-105-043

CHILD PARCEL: 15-00-045-105-049, -050

STARTING POINT: CENTERLINE OF FACTORY ST. & WEST MAIN ST.

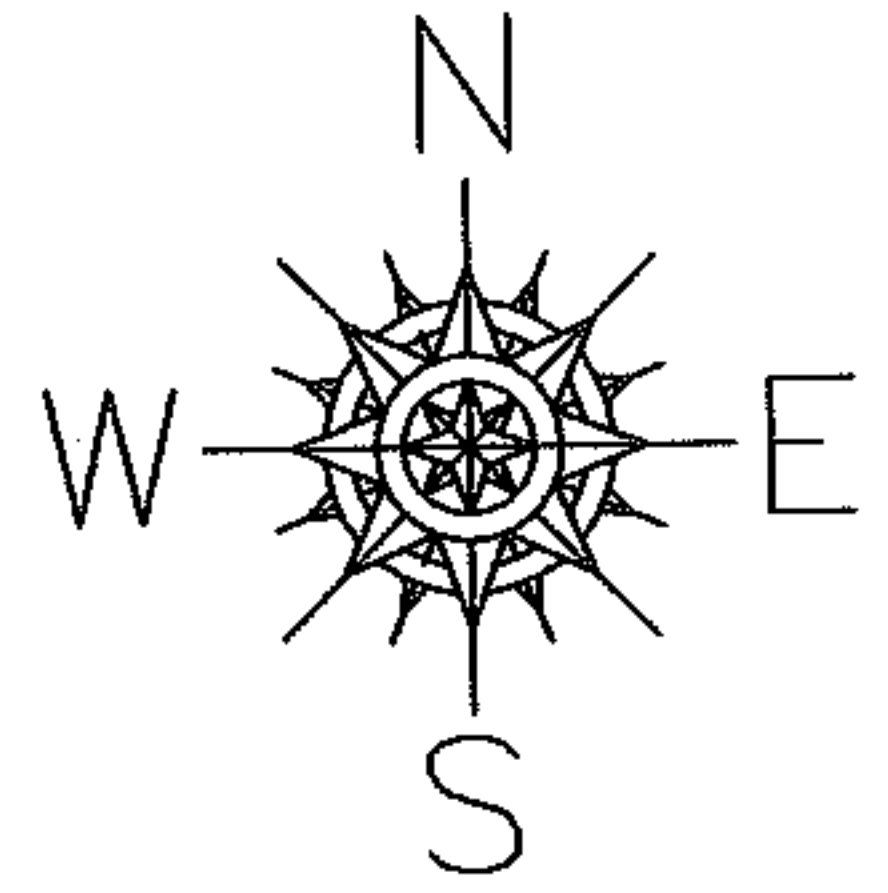

~~FACTORY STREETS~~

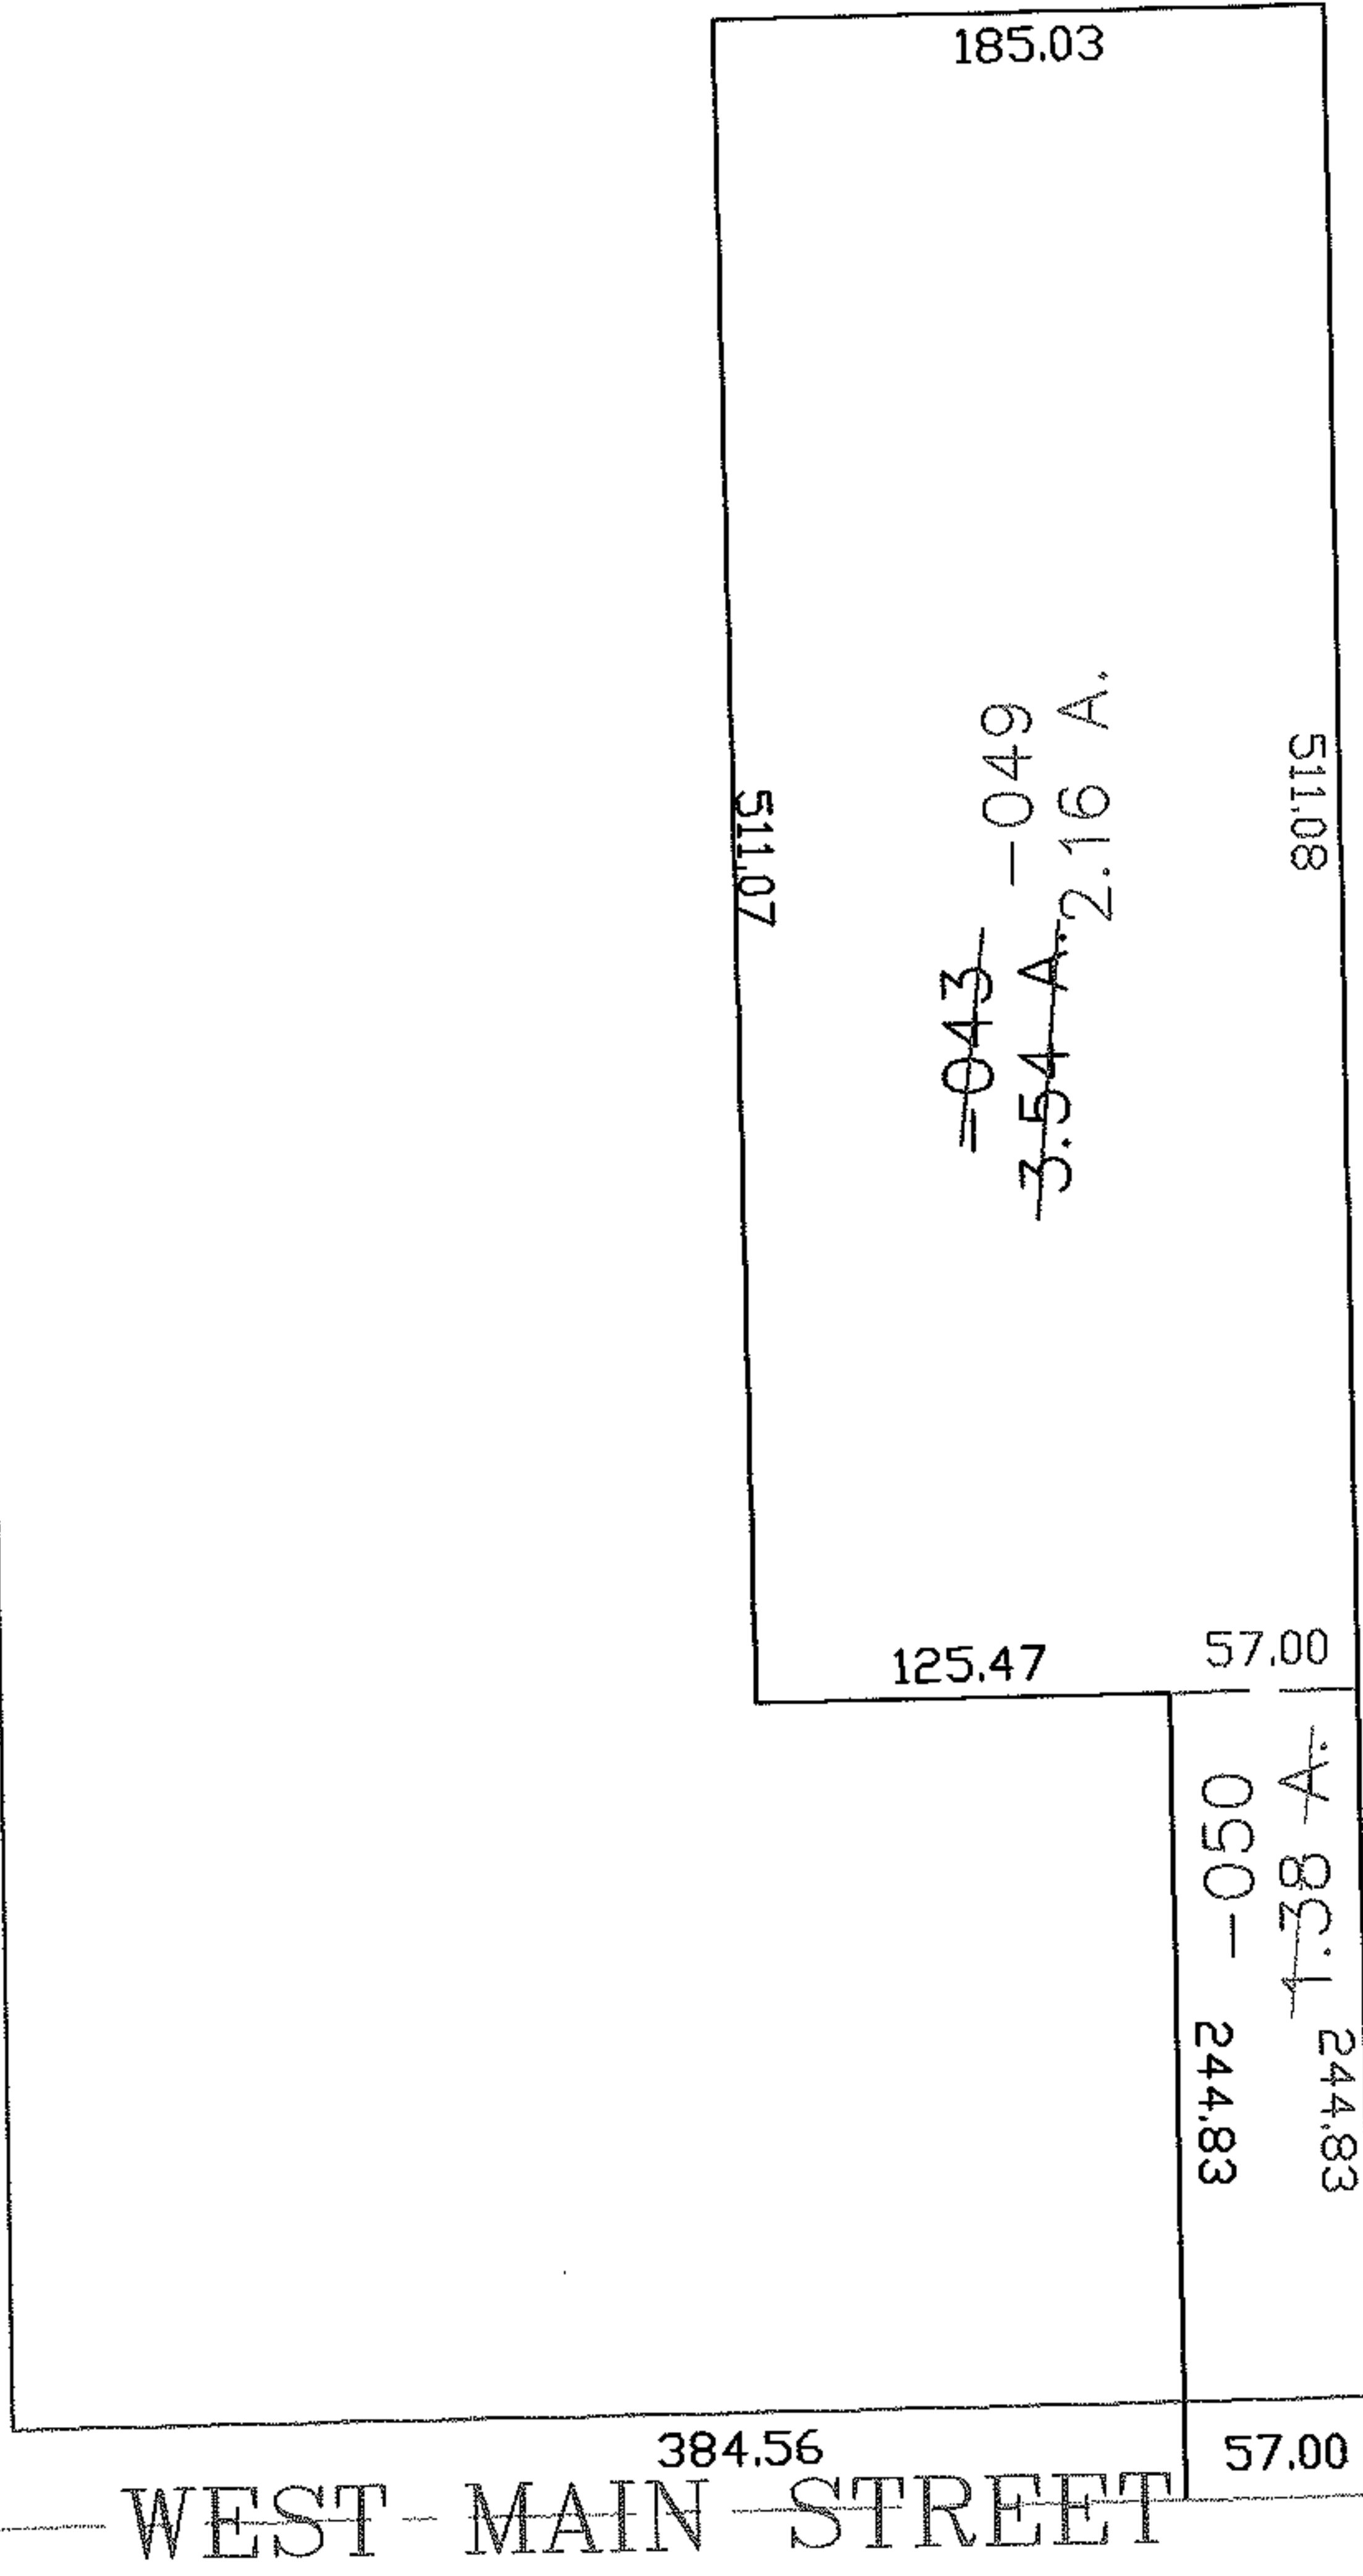

A. CORR PER SURVEY
PHILLIP ROSEBECK



SPLITS/DEEDS PROCESSED

LORAIN COUNTY TAX MAP DEPARTMENT
226 MIDDLE AVE. ELYRIA, OHIO

SURVEYED BY: PHILIP A ROSEBECK
 CLOSURE: 0.00 : 10,000
 MAP PAGE(S): 15-00-045-B
 APPROVED BY: JAH DATE: 11-22-05
 SCALE: 1" = 100 PRIOR INSTRUMENT: DV 1257/374