

RA-577X

PARENT PARCEL: 06-22-018-121-027 THRU -031

10-02051-C




CHILD PARCEL:

STARTING POINT: S/L 428 THRU 432 IN HENRY F. EILERTS CLEARVIEW SUB.(VOL.10 PG.8)

DEPTH CORRECTION

PER. COURT CASE NO. 10TX006165

06-22-018-121-027	30 X 120.70 30 X 113	06-22-018-121-030	30 X 120.70 30 X 113
06-22-018-121-028	30 X 120.70 30 X 113	06-22-018-121-031	30 X 120.70 30 X 113
06-22-018-121-029	30 X 120.70 30 X 113		

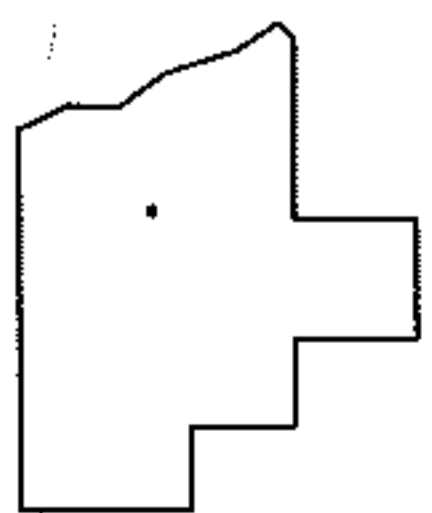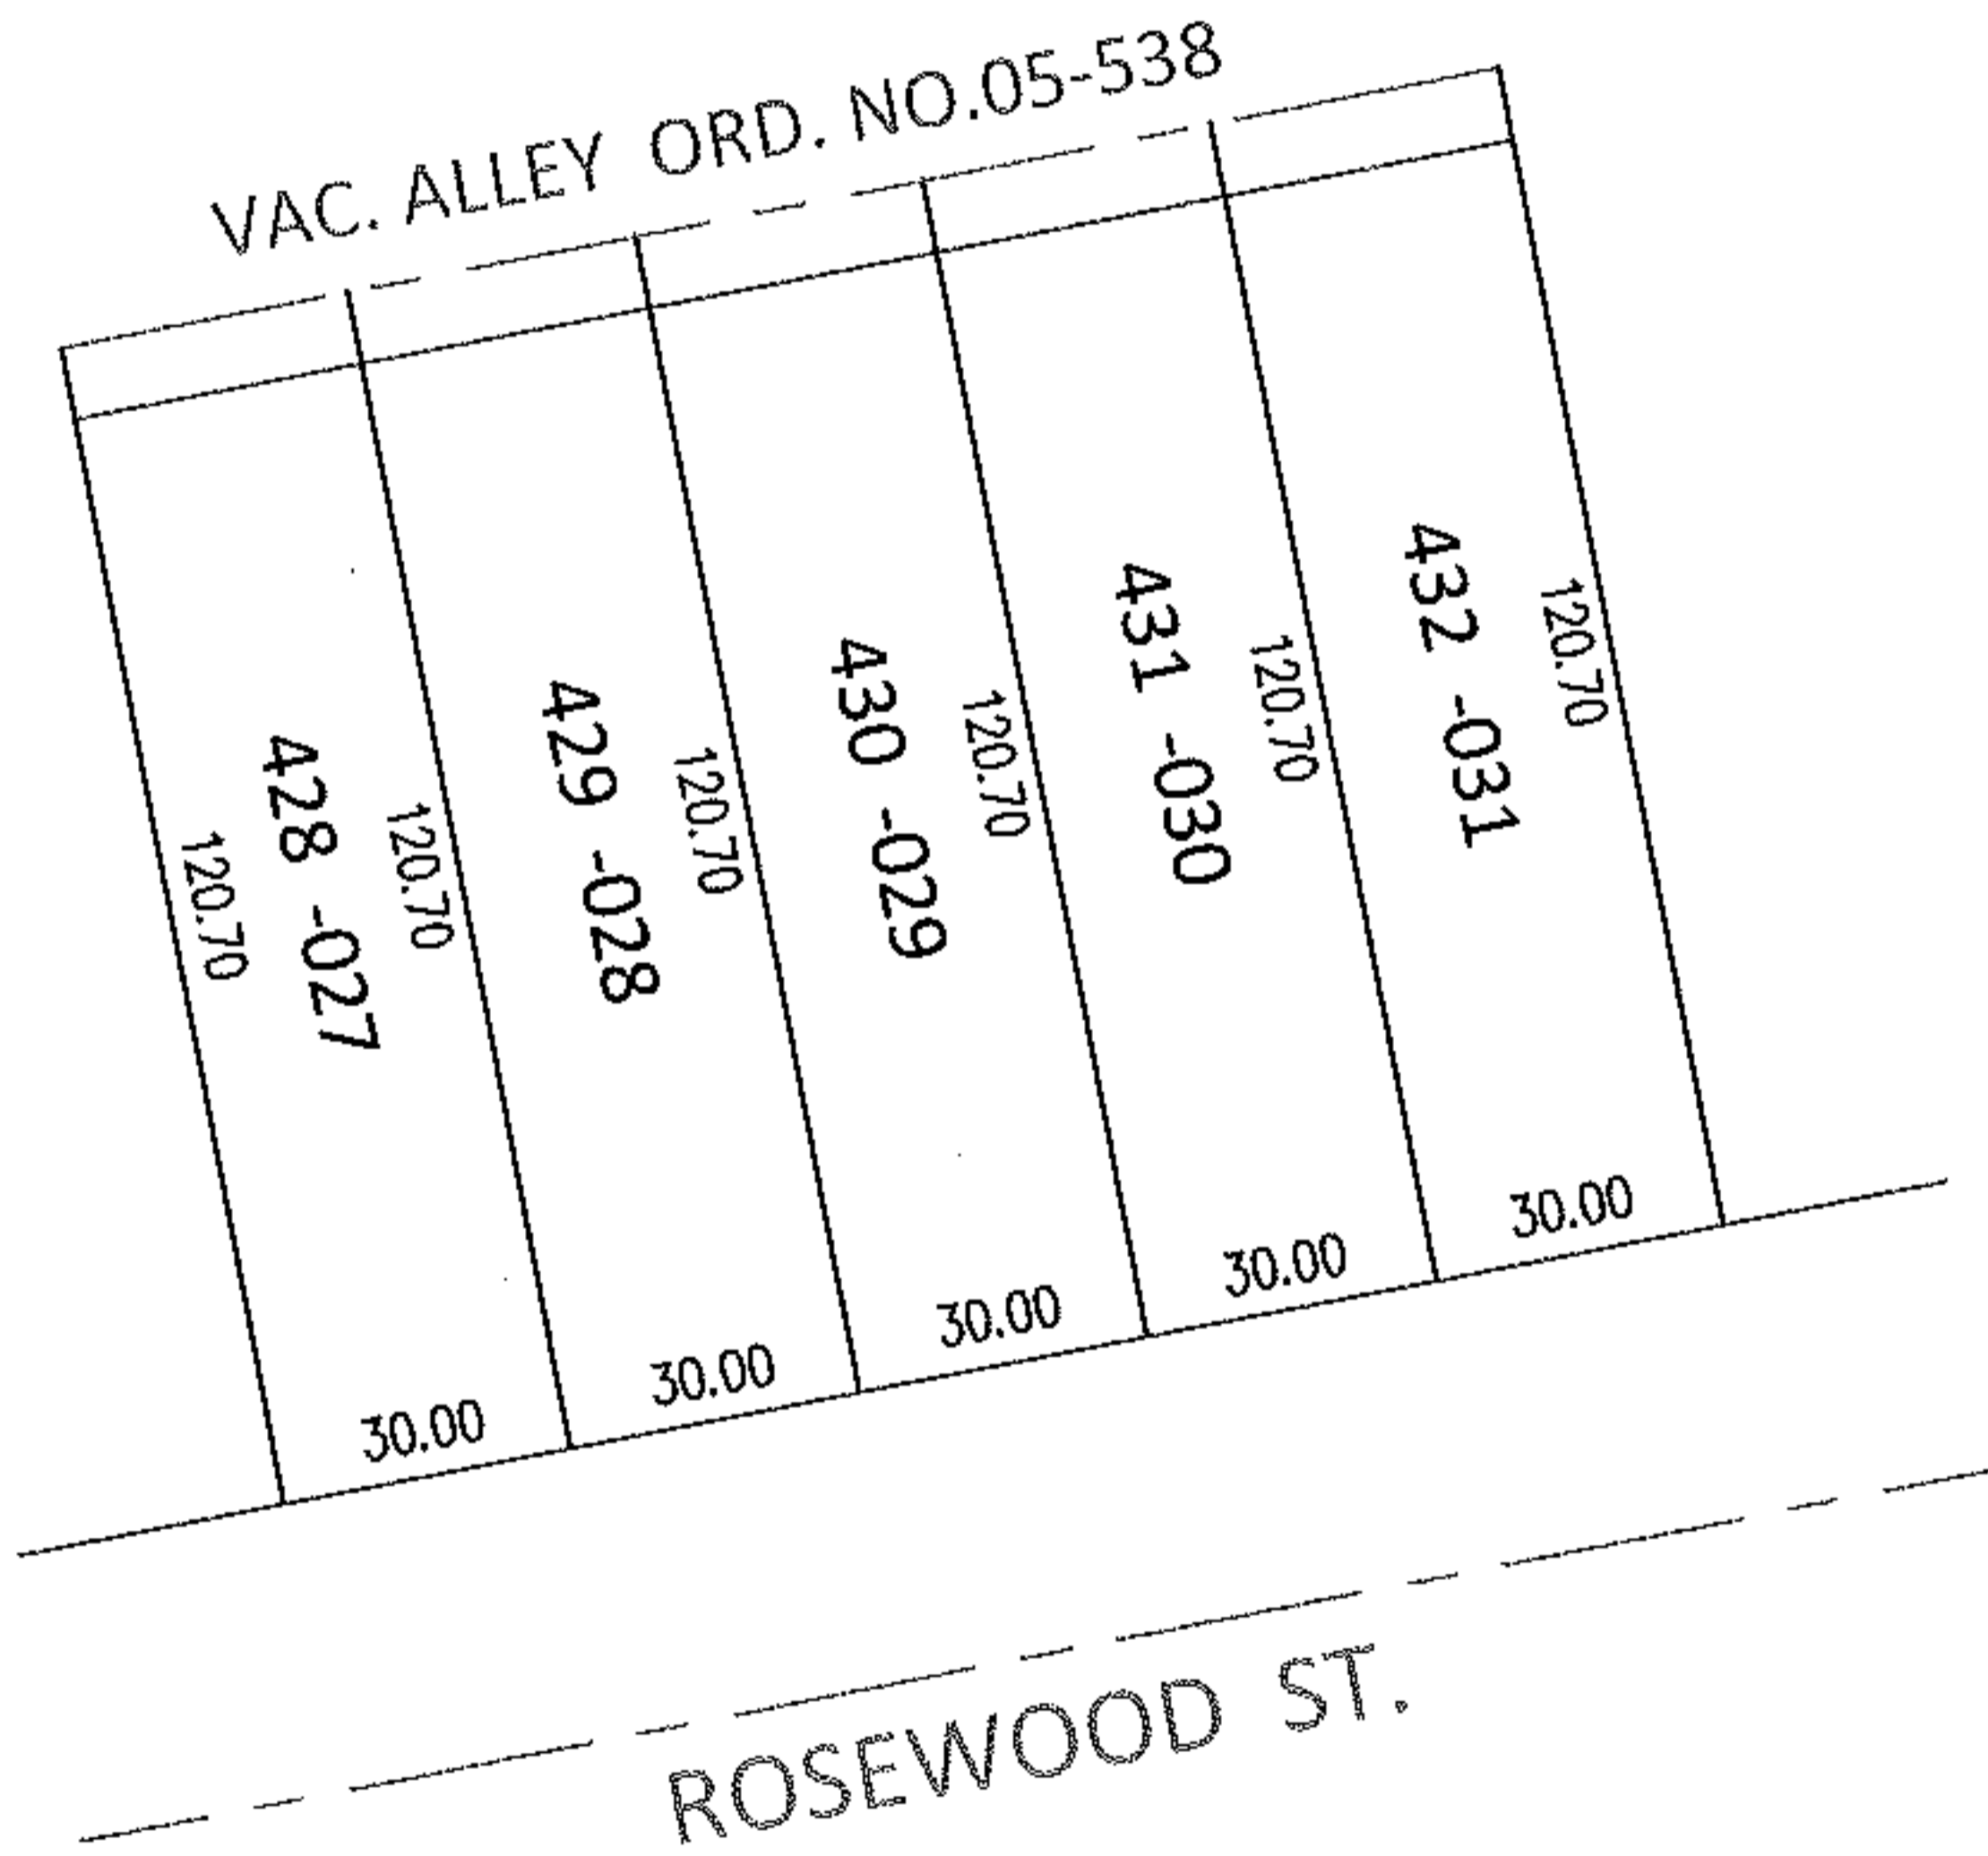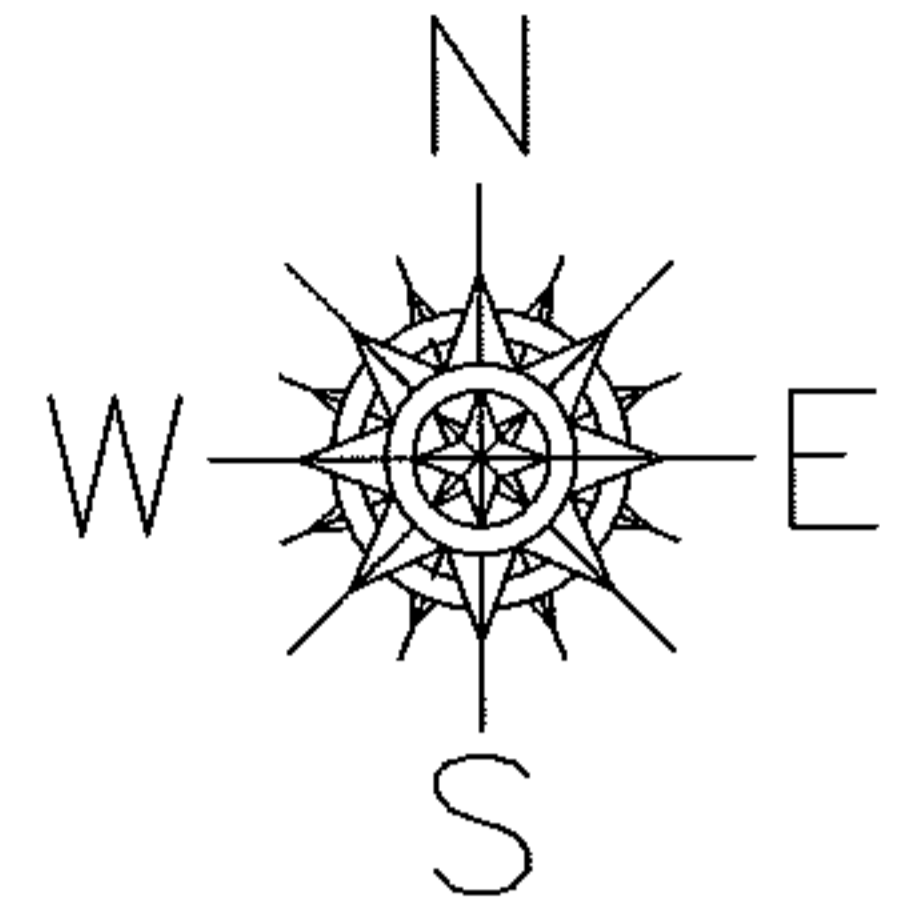

SPLITS/DEEDS PROCESSED

LORAIN COUNTY TAX MAP DEPARTMENT
226 MIDDLE AVE. ELYRIA, OHIO

SURVEYED BY: N/A

CLOSURE: N/A

MAP PAGE(S): 6-8

APPROVED BY: RRM DATE: 7-12-10

SCALE: 1"= 50' PRIOR INST.: OR 409/62