


REGISTER

PARENT PARCEL: 10-00-016-000-140

CHILD PARCEL: _____

10-02053-C

STARTING POINT: INTERSECTION OF C/L OF SLIFE RD. AND C/L OF INDIAN HOLLOW RD.

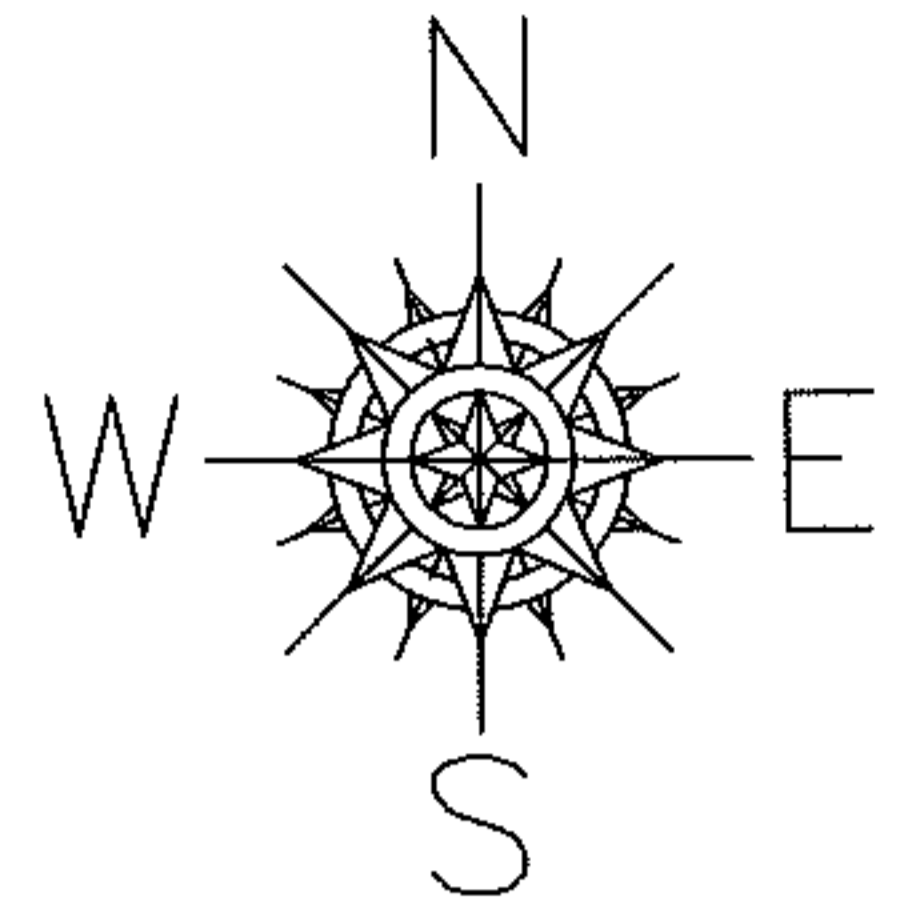

SLIFE RD.

INDIAN HOLLOW RD.

2039.91

81.15
39.
.01

230.00

102.44

910.64


-140

~~4.90 A.~~

4.94 A. AC. CORR. PER. SURV.
D. HAYWOOD

1105.24

206.94

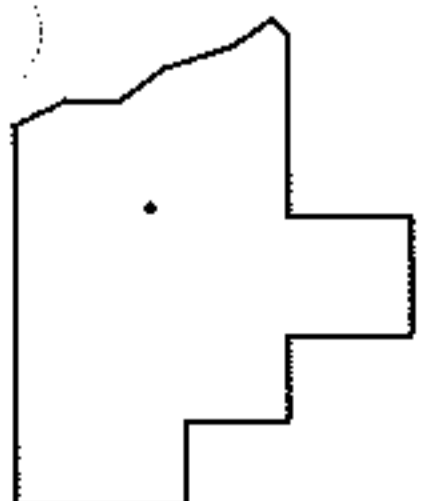

SPLITS/DEEDS PROCESSED

LORAIN COUNTY TAX MAP DEPARTMENT
226 MIDDLE AVE. ELYRIA, OHIO

SURVEYED BY: DALE R. HAYWOOD

CLOSURE: .01:10,000

MAP PAGE(S): 10-00-016-F

APPROVED BY: RRM DATE: 7-23-10

SCALE: 1"= 200 PRIOR INST.: OR 259/739