


RASSED

PARENT PARCEL: 09-00-005-000-005

10-02054-A

CHILD PARCEL: _____

STARTING POINT: INTERSECTION OF EAST LINE OF O.L. 5 AND SOUTH LINE OF LAND
CONVEYED TO L.J. NIXON(DV 264/150)

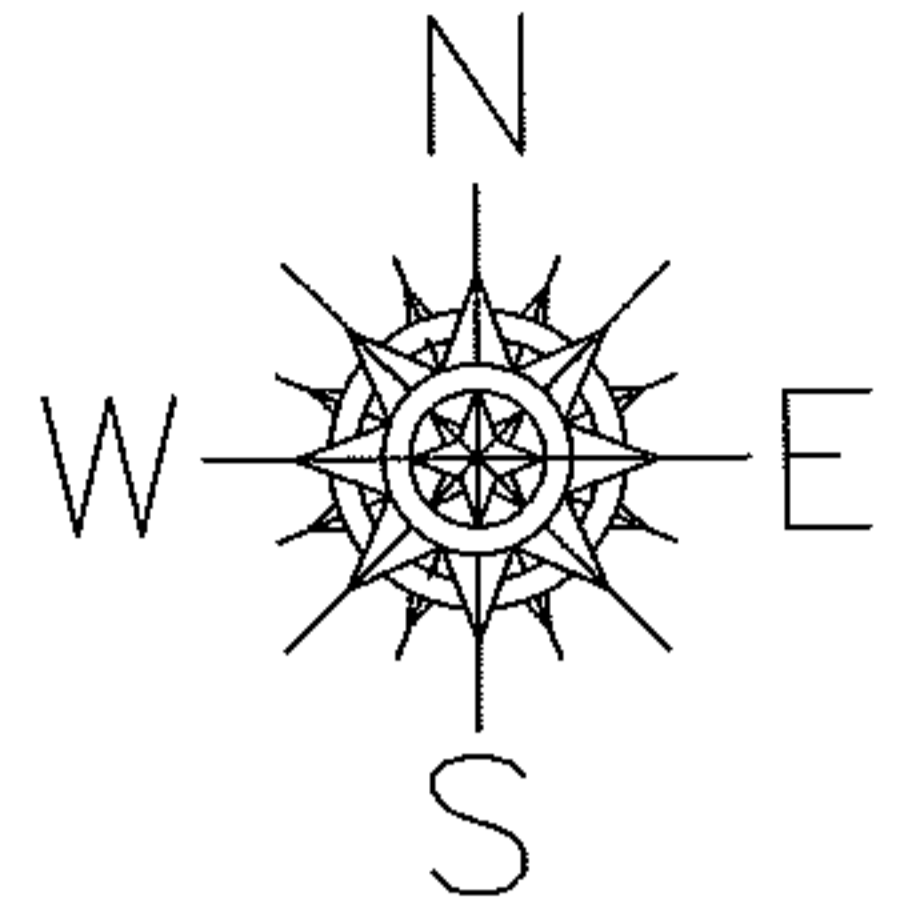

ACREAGE CORRECTION

09-00-005-000-005

19.46 A.


~~19.50 A.~~

PER PRIOR DEEDS

DV 291/431

DV 1383/731

OR 898/739

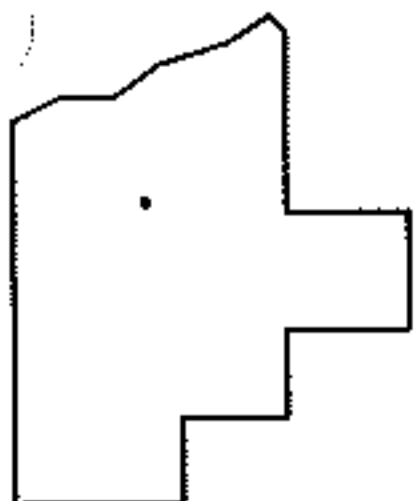

SPLITS/DEEDS PROCESSED

LORAIN COUNTY TAX MAP DEPARTMENT
226 MIDDLE AVE. ELYRIA, OHIO

SURVEYED BY: N/A

CLOSURE: N/A

MAP PAGE(S): 9-B

APPROVED BY: RRM DATE: 7/21/10

SCALE: 1" = 50' PRIOR INST.: SEE ABOVE