


RASTER 8/25/10

PARENT PARCEL: 01-00-006-101-037

10-02055-D

CHILD PARCEL:

STARTING POINT: SOUTHEAST CORNER OF S/L 16 IN TERRACE BEACH ALLOT(VOL.10 PG.26)

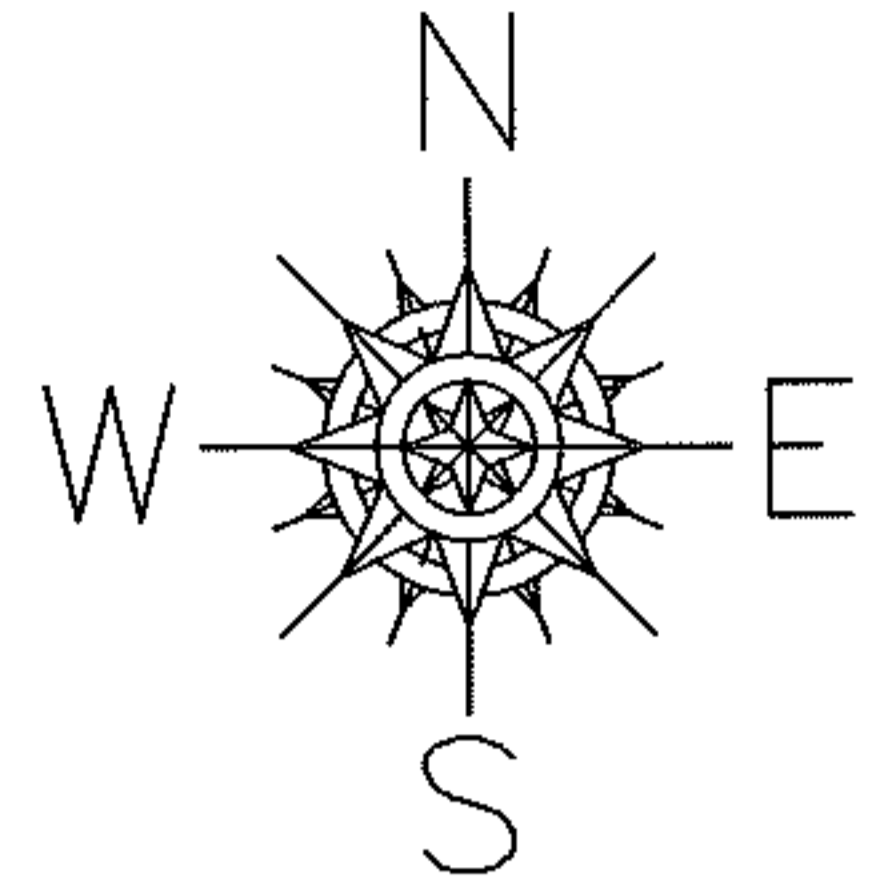

LAKE ERIE

251.76

S/L 16

80.00

S.L.5

O.L.6

-037

~~0.57 A.~~

0.52 A. AC.CORR.PER.SURV.  
D.HARTUNG JR.

65.00

EDGEWATER  
DR.


35.06

250.00

N.Y.C. R.R.

REMOVE UPDATE LEGAL

01-00-006-101-037

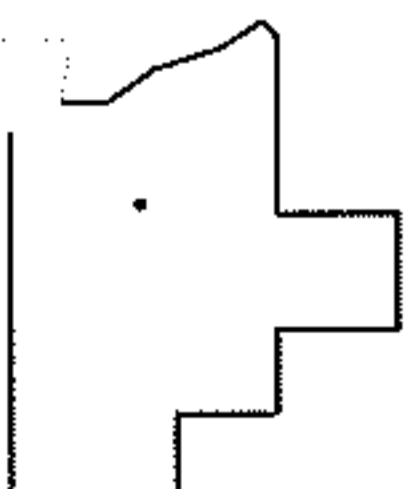

SPLITS/DEEDS PROCESSED

LORAIN COUNTY TAX MAP DEPARTMENT  
226 MIDDLE AVE. ELYRIA, OHIO

SURVEYED BY: DANIEL E. HARTUNG JR.

CLOSURE: .01:10,000

MAP PAGE(S): 1-00-006-A

APPROVED BY: RRM DATE: 7-21-10

SCALE: 1"= 50' PRIOR INST.: 20090299171