




RASTER

PARENT PARCEL: 10-00-023-101-036

CHILD PARCEL: 10-00-023-101-053, -054

STARTING POINT: CENTERLINE OF PARSONS RD. & O.L. 23

05-02055

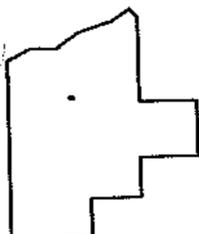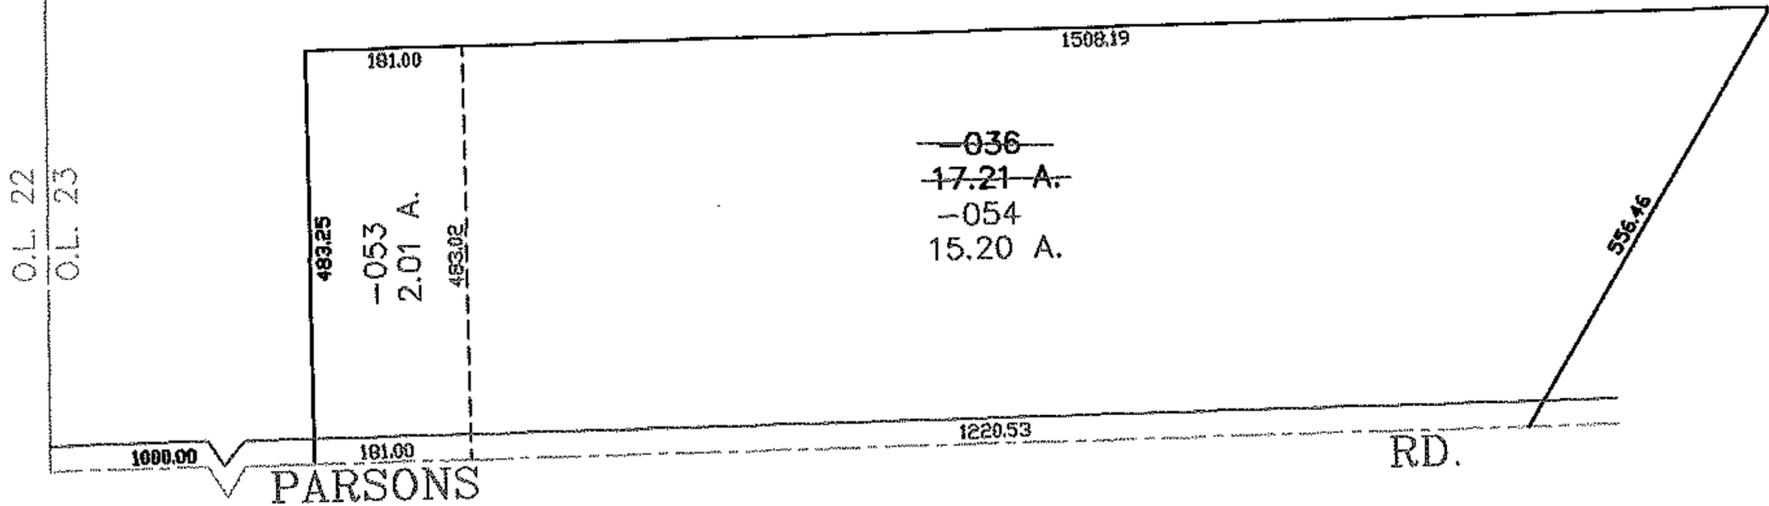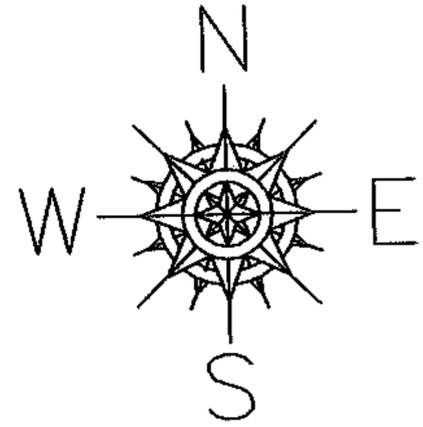

**SPLITS/DEEDS PROCESSED**

LORAIN COUNTY TAX MAP DEPARTMENT  
226 MIDDLE AVE. ELYRIA, OHIO

SURVEYED BY: THOMAS SIMON

CLOSURE: 0.00 ; 10.000

MAP PAGE(S): 10-00-023-F

APPROVED BY: JAH DATE: 12-8-05

SCALE: 1" = 300 PRIOR INSTRUMENT: OR 206/770