




RASTER

PARENT PARCEL: 07-00-028-103-105

CHILD PARCEL: 07-00-028-103-130, -131

STARTING POINT: CENTER LINE OF CENTER RIDGE RD. & AVON BELDEN RD.

05-02057

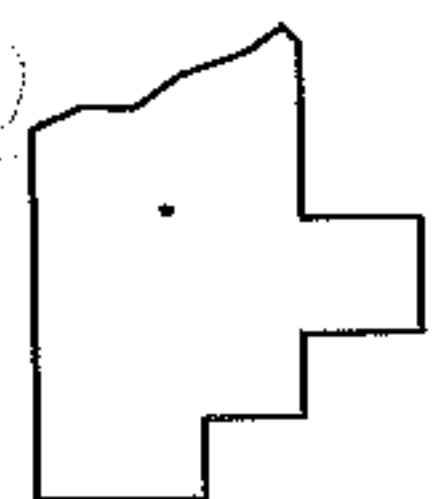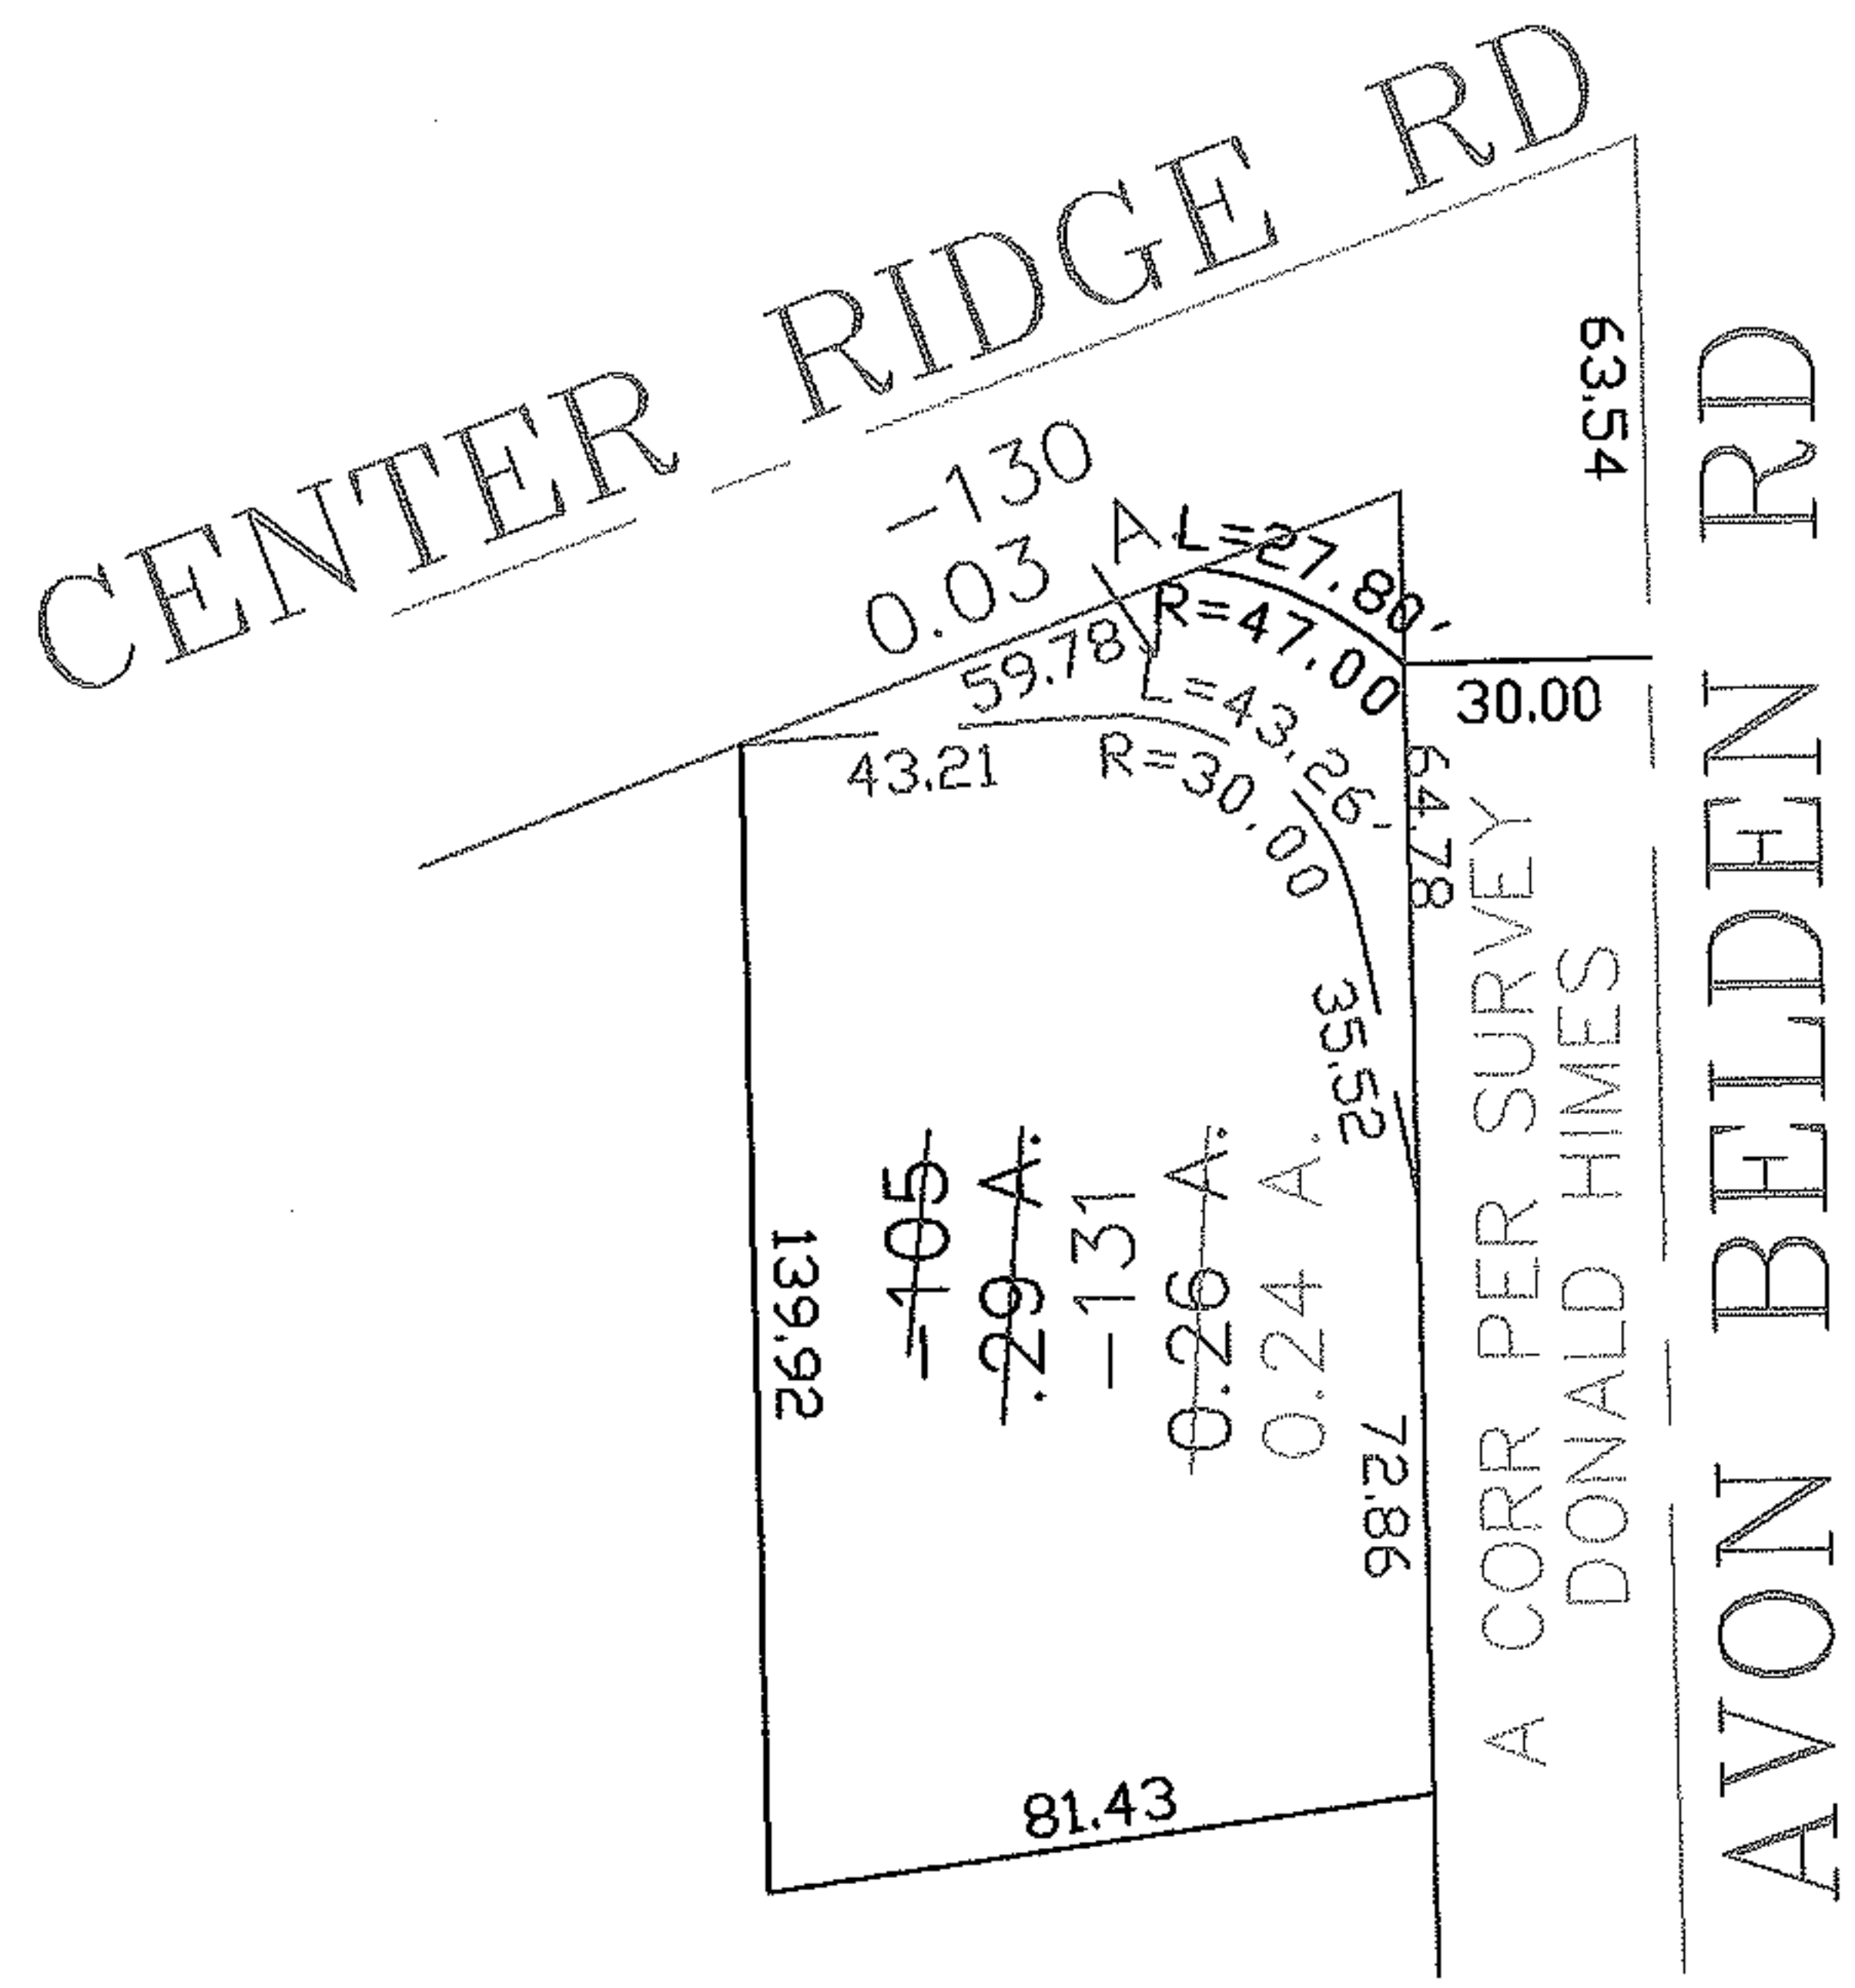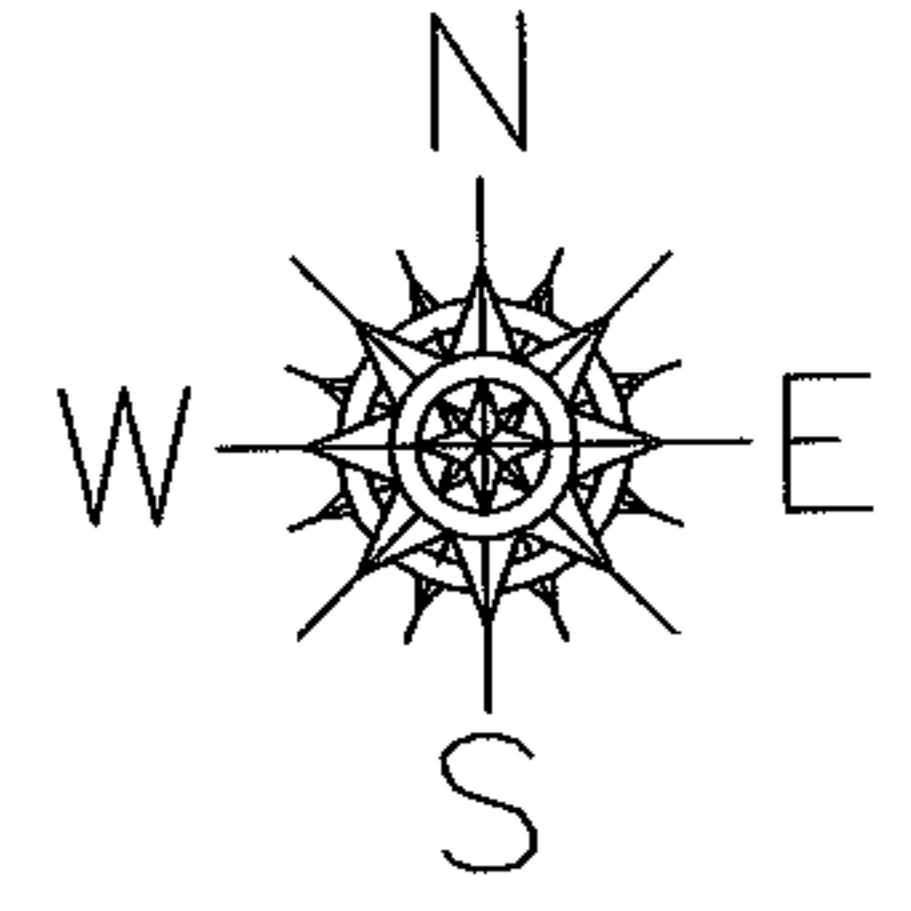

SPLITS/DEEDS PROCESSED

LORAIN COUNTY TAX MAP DEPARTMENT  
226 MIDDLE AVE. ELYRIA, OHIO

SURVEYED BY: DONALD HIMES  
 CLOSURE: 0.00 : 10,000  
 MAP PAGE(S): 07-00-028-D  
 APPROVED BY: JAH DATE: 12-12-05  
 SCALE: 1" = 100' PRIOR INSTRUMENT: DV 1257/752