




RASTER

PARENT PARCEL: 03-00-046-113-013, -014

CHILD PARCEL: 03-00-046-113-015 THU -019

STARTING POINT: CENTERLINE OF MCKINLEY ST. & ROOT RD.

05-02059

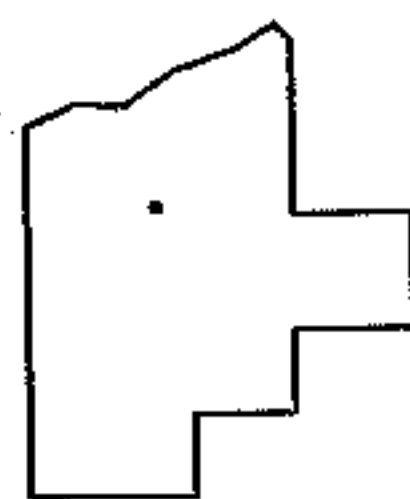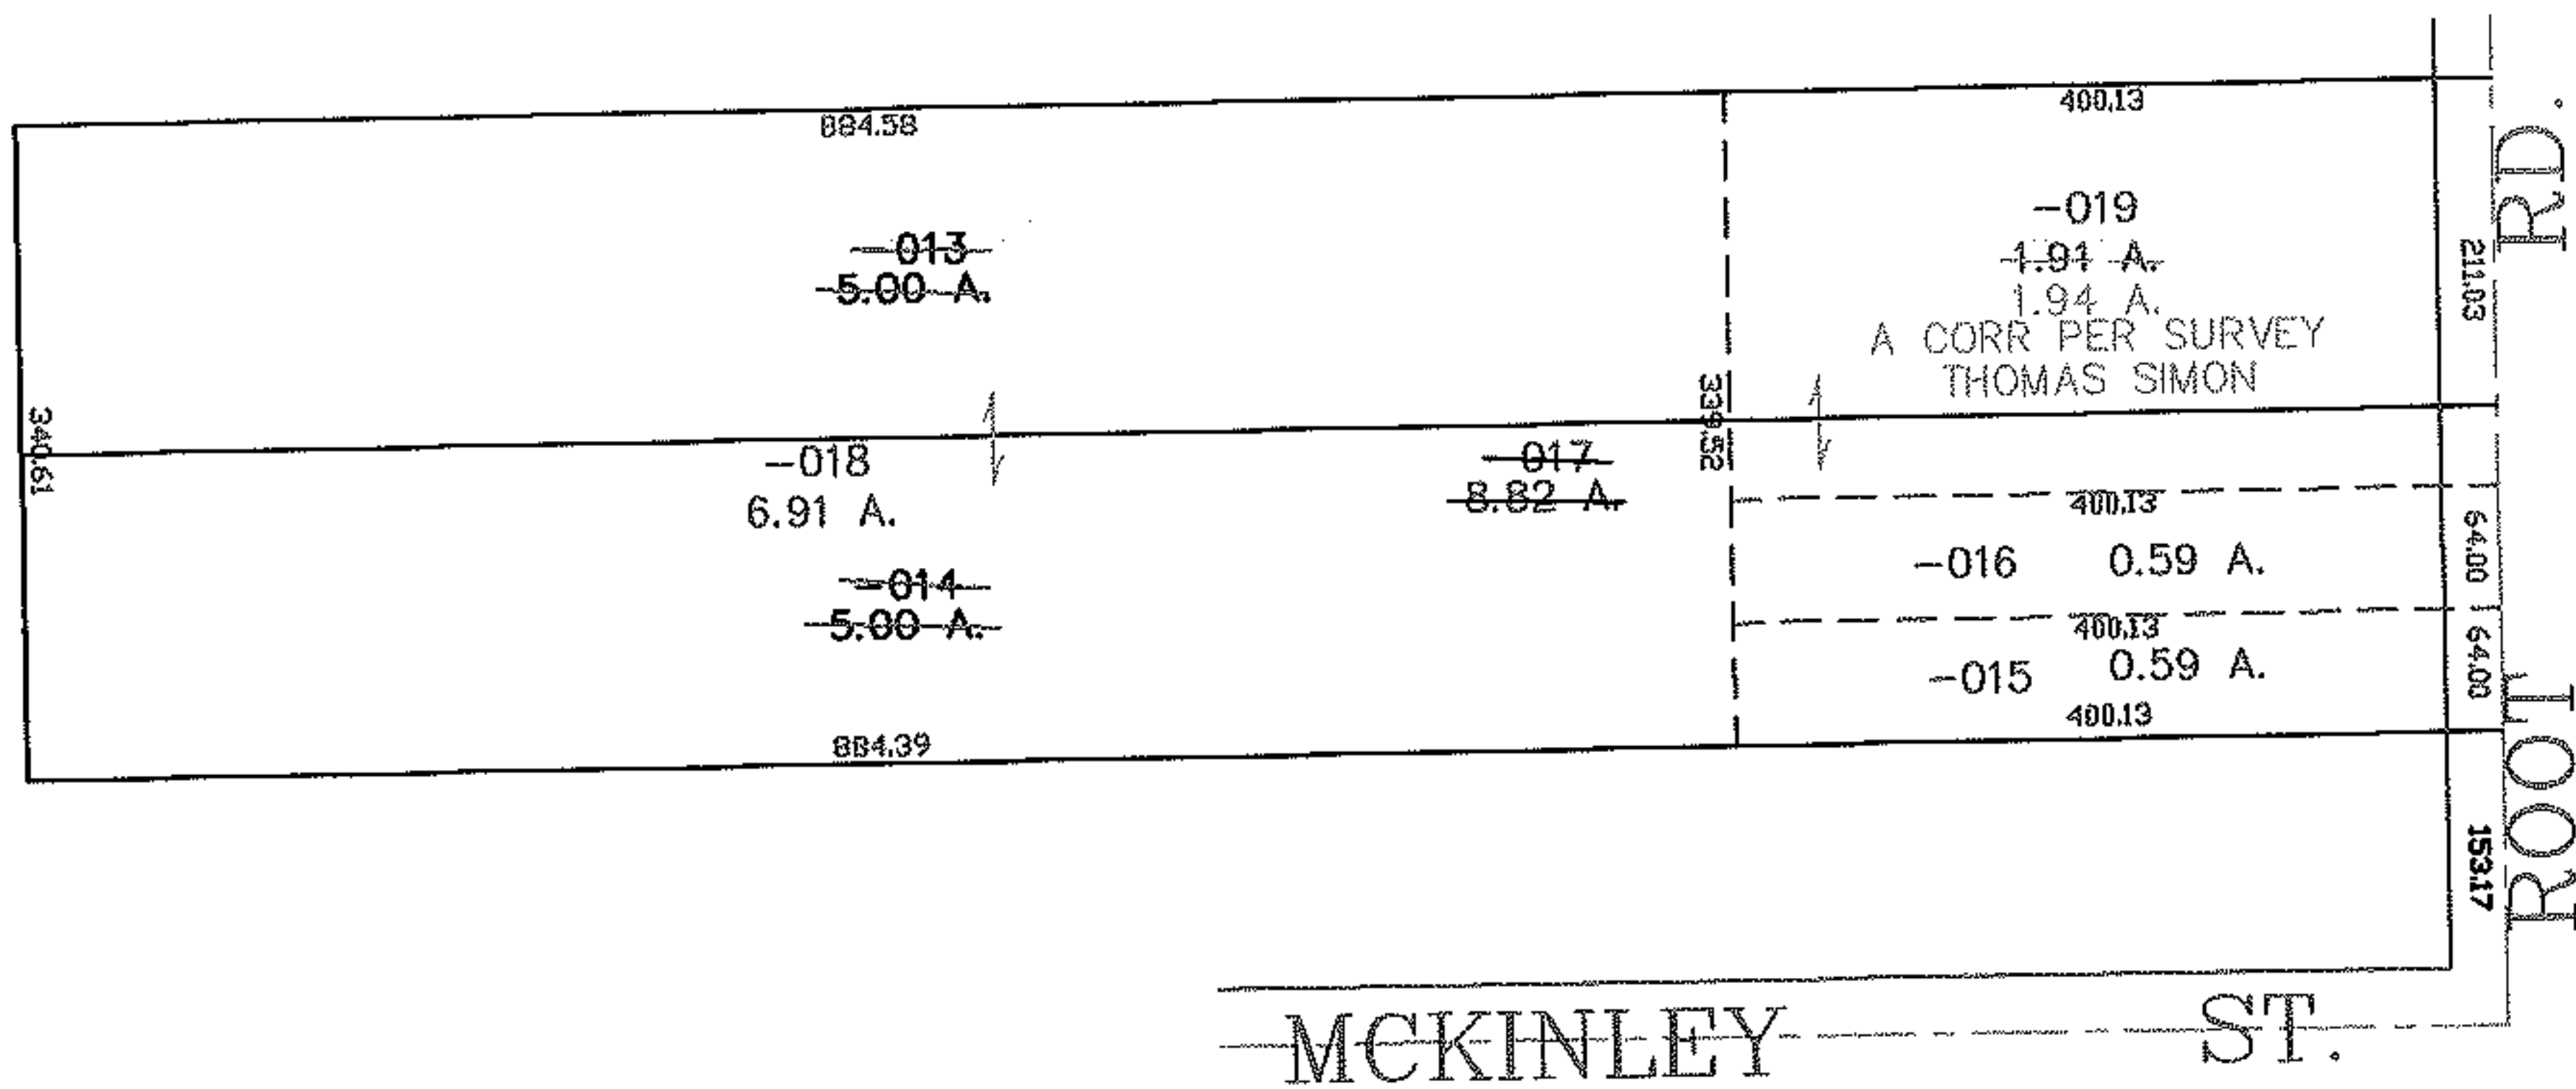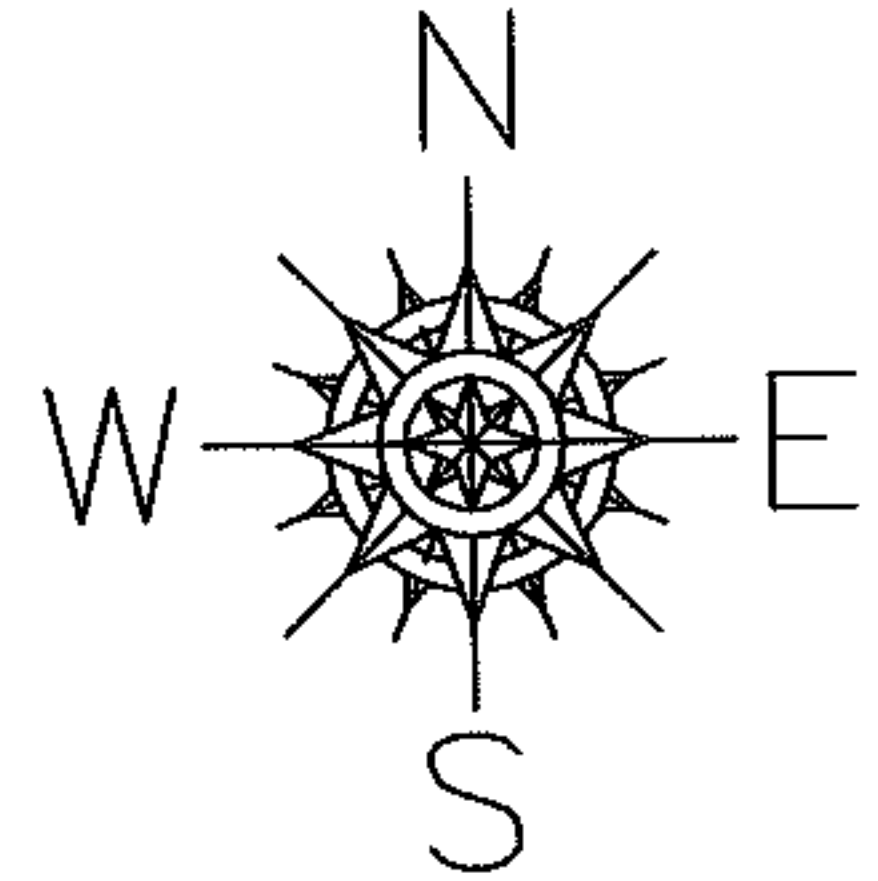

SPLITS/DEEDS PROCESSED
 LORAIN COUNTY TAX MAP DEPARTMENT
 226 MIDDLE AVE. ELYRIA, OHIO

SURVEYED BY: THOMAS SIMON
 CLOSURE: 0.00 : 10.000
 MAP PAGE(S): 03-00-046-B
 APPROVED BY: JAH DATE: 12-16-05
 SCALE: 1" = 200 PRIOR INSTRUMENT: 980567619