

PASTER

PARENT PARCEL: 20-05-024-000-001, -003, -005, -006, -013, -014, -018



CHILD PARCEL: XX-XX-XXX-XXX-XXX

STARTING POINT: XXXXXX

10-02061-C


MAP CORRECTION

LINES WERE INCORRECTLY DRAWN
ON THE 1896-1962 MAP,
PRESENT TAX MAP & GIS MAP

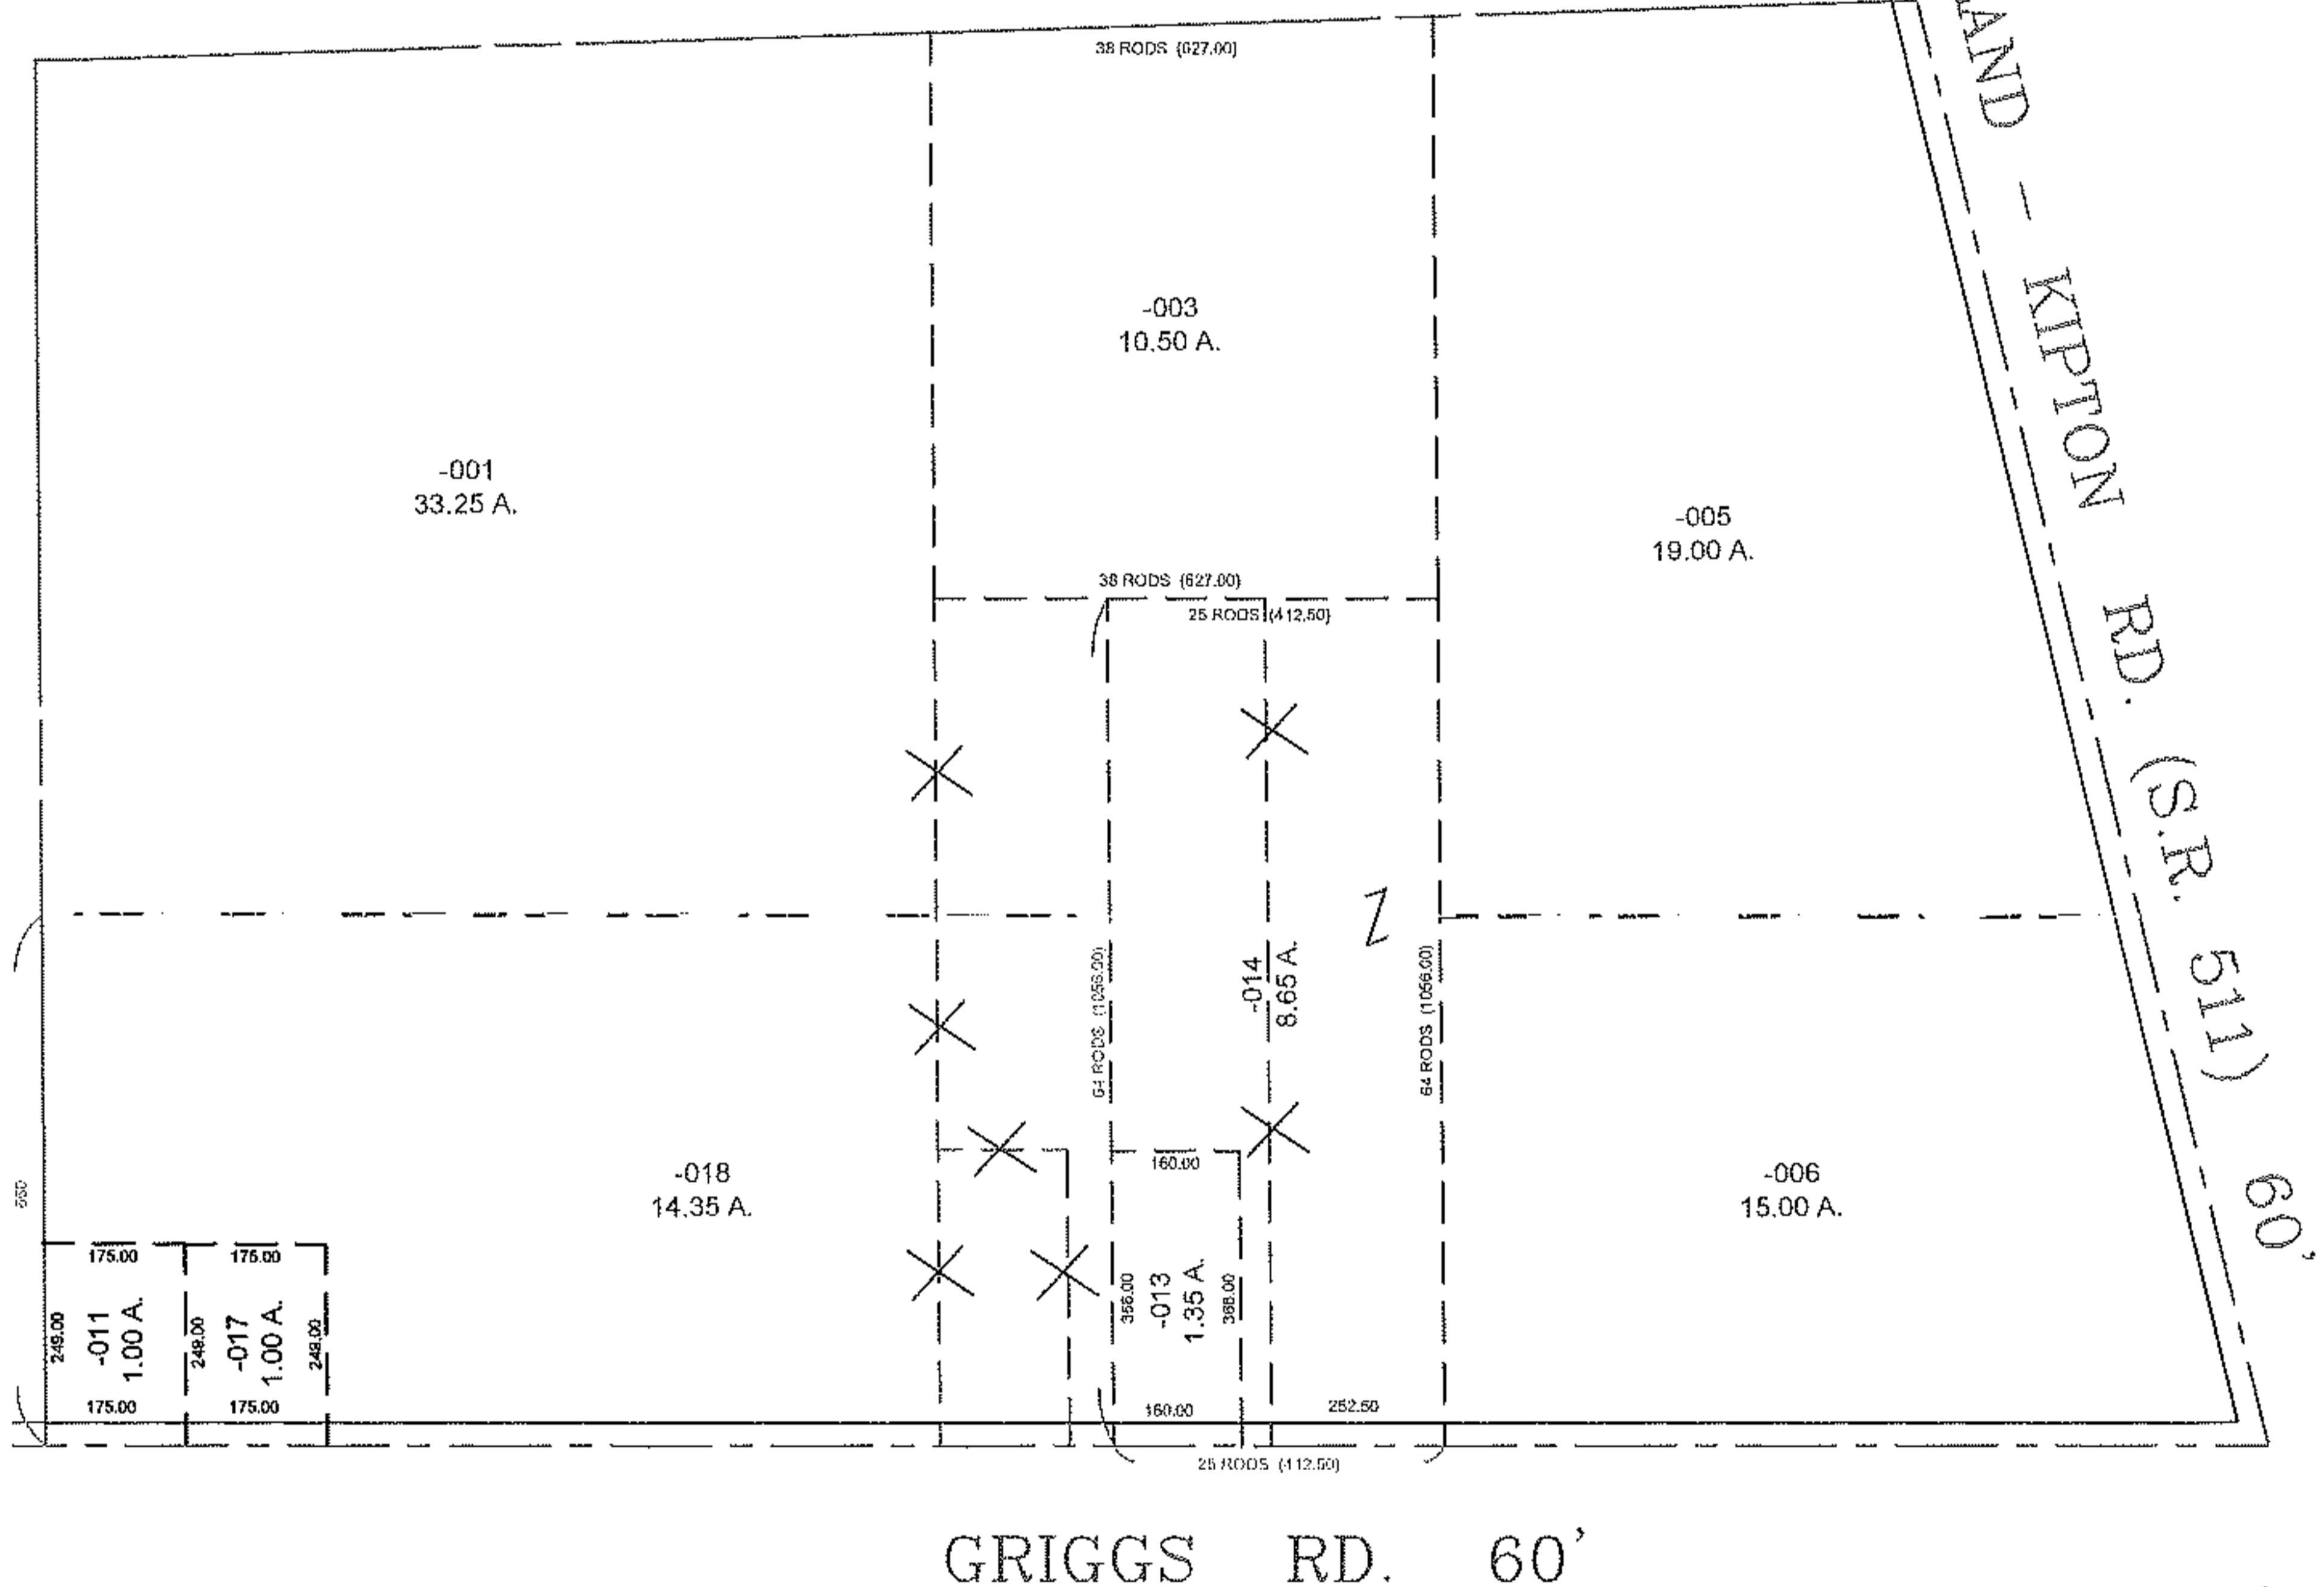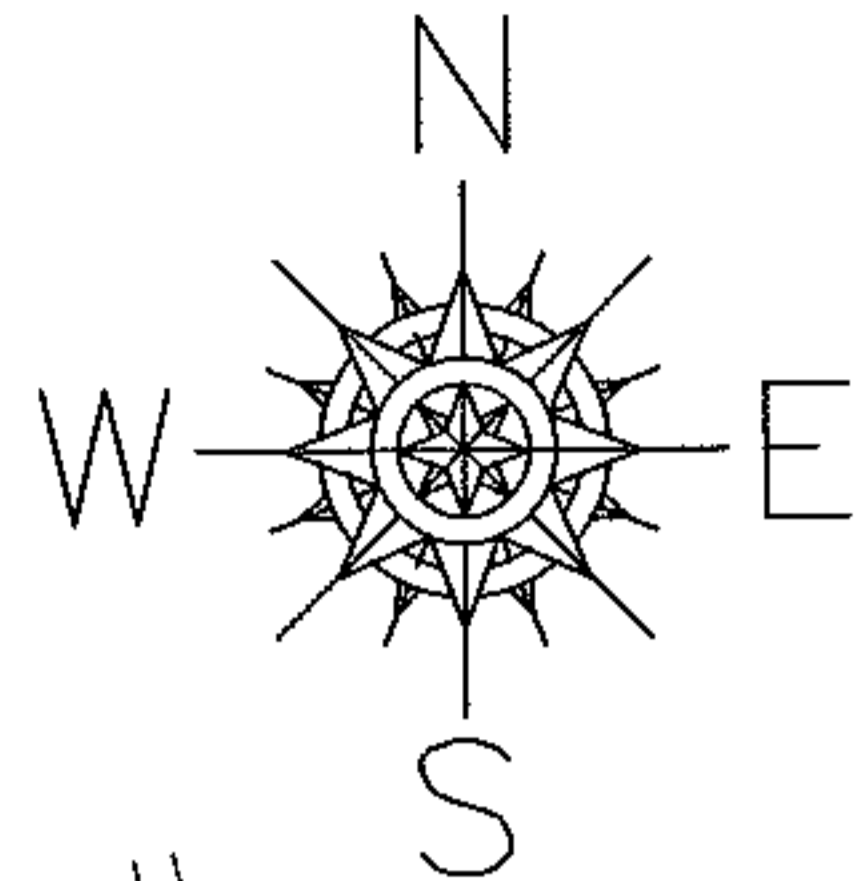

— X — INCORRECT LINE PLACEMENT
 - - - CORRECT LINE PLACEMENT

PRIOR INSTRUMENT: DV 1252/801
 PRIOR INSTRUMENT: DV 1018/553
 PRIOR INSTRUMENT: OR 1056/190
 PRIOR INSTRUMENT: DV 133/91
 PRIOR INSTRUMENT: DV 263/403

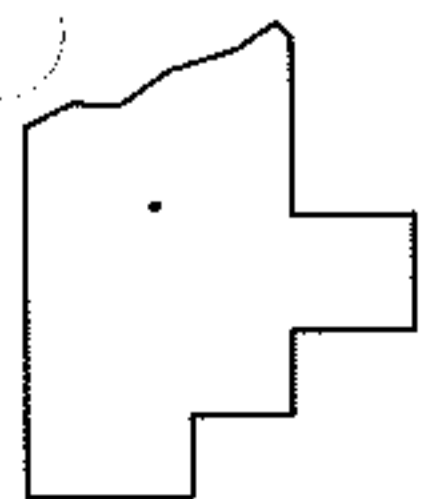

SPLITS/DEEDS PROCESSED
 LORAIN COUNTY TAX MAP DEPARTMENT
 226 MIDDLE AVE. ELYRIA, OHIO

SURVEYED BY: NONE
 CLOSURE: XXXXXX
 MAP PAGE(S): 20-C
 APPROVED BY: TJS DATE: 7/29/10
 SCALE: 1" = 400