




RASTAF...

PARENT PARCEL: 06-25-105-000-003 & -004  
CHILD PARCEL: XX-XX-XXX-XXX-XXX  
STARTING POINT: S.W. CORNER OF S/L 9 IN CHRISTIAN WENDT'S 2ND SUB. V. 6 PG. 47

10-02063-C

# MAP CORRECTION

LINE CORRECTION BETWEEN  
06-25-105-000-003 & -004

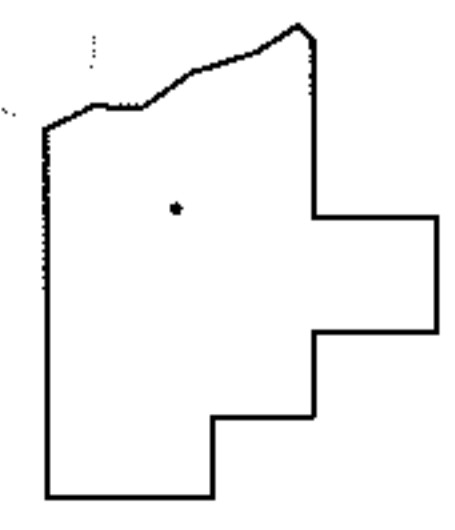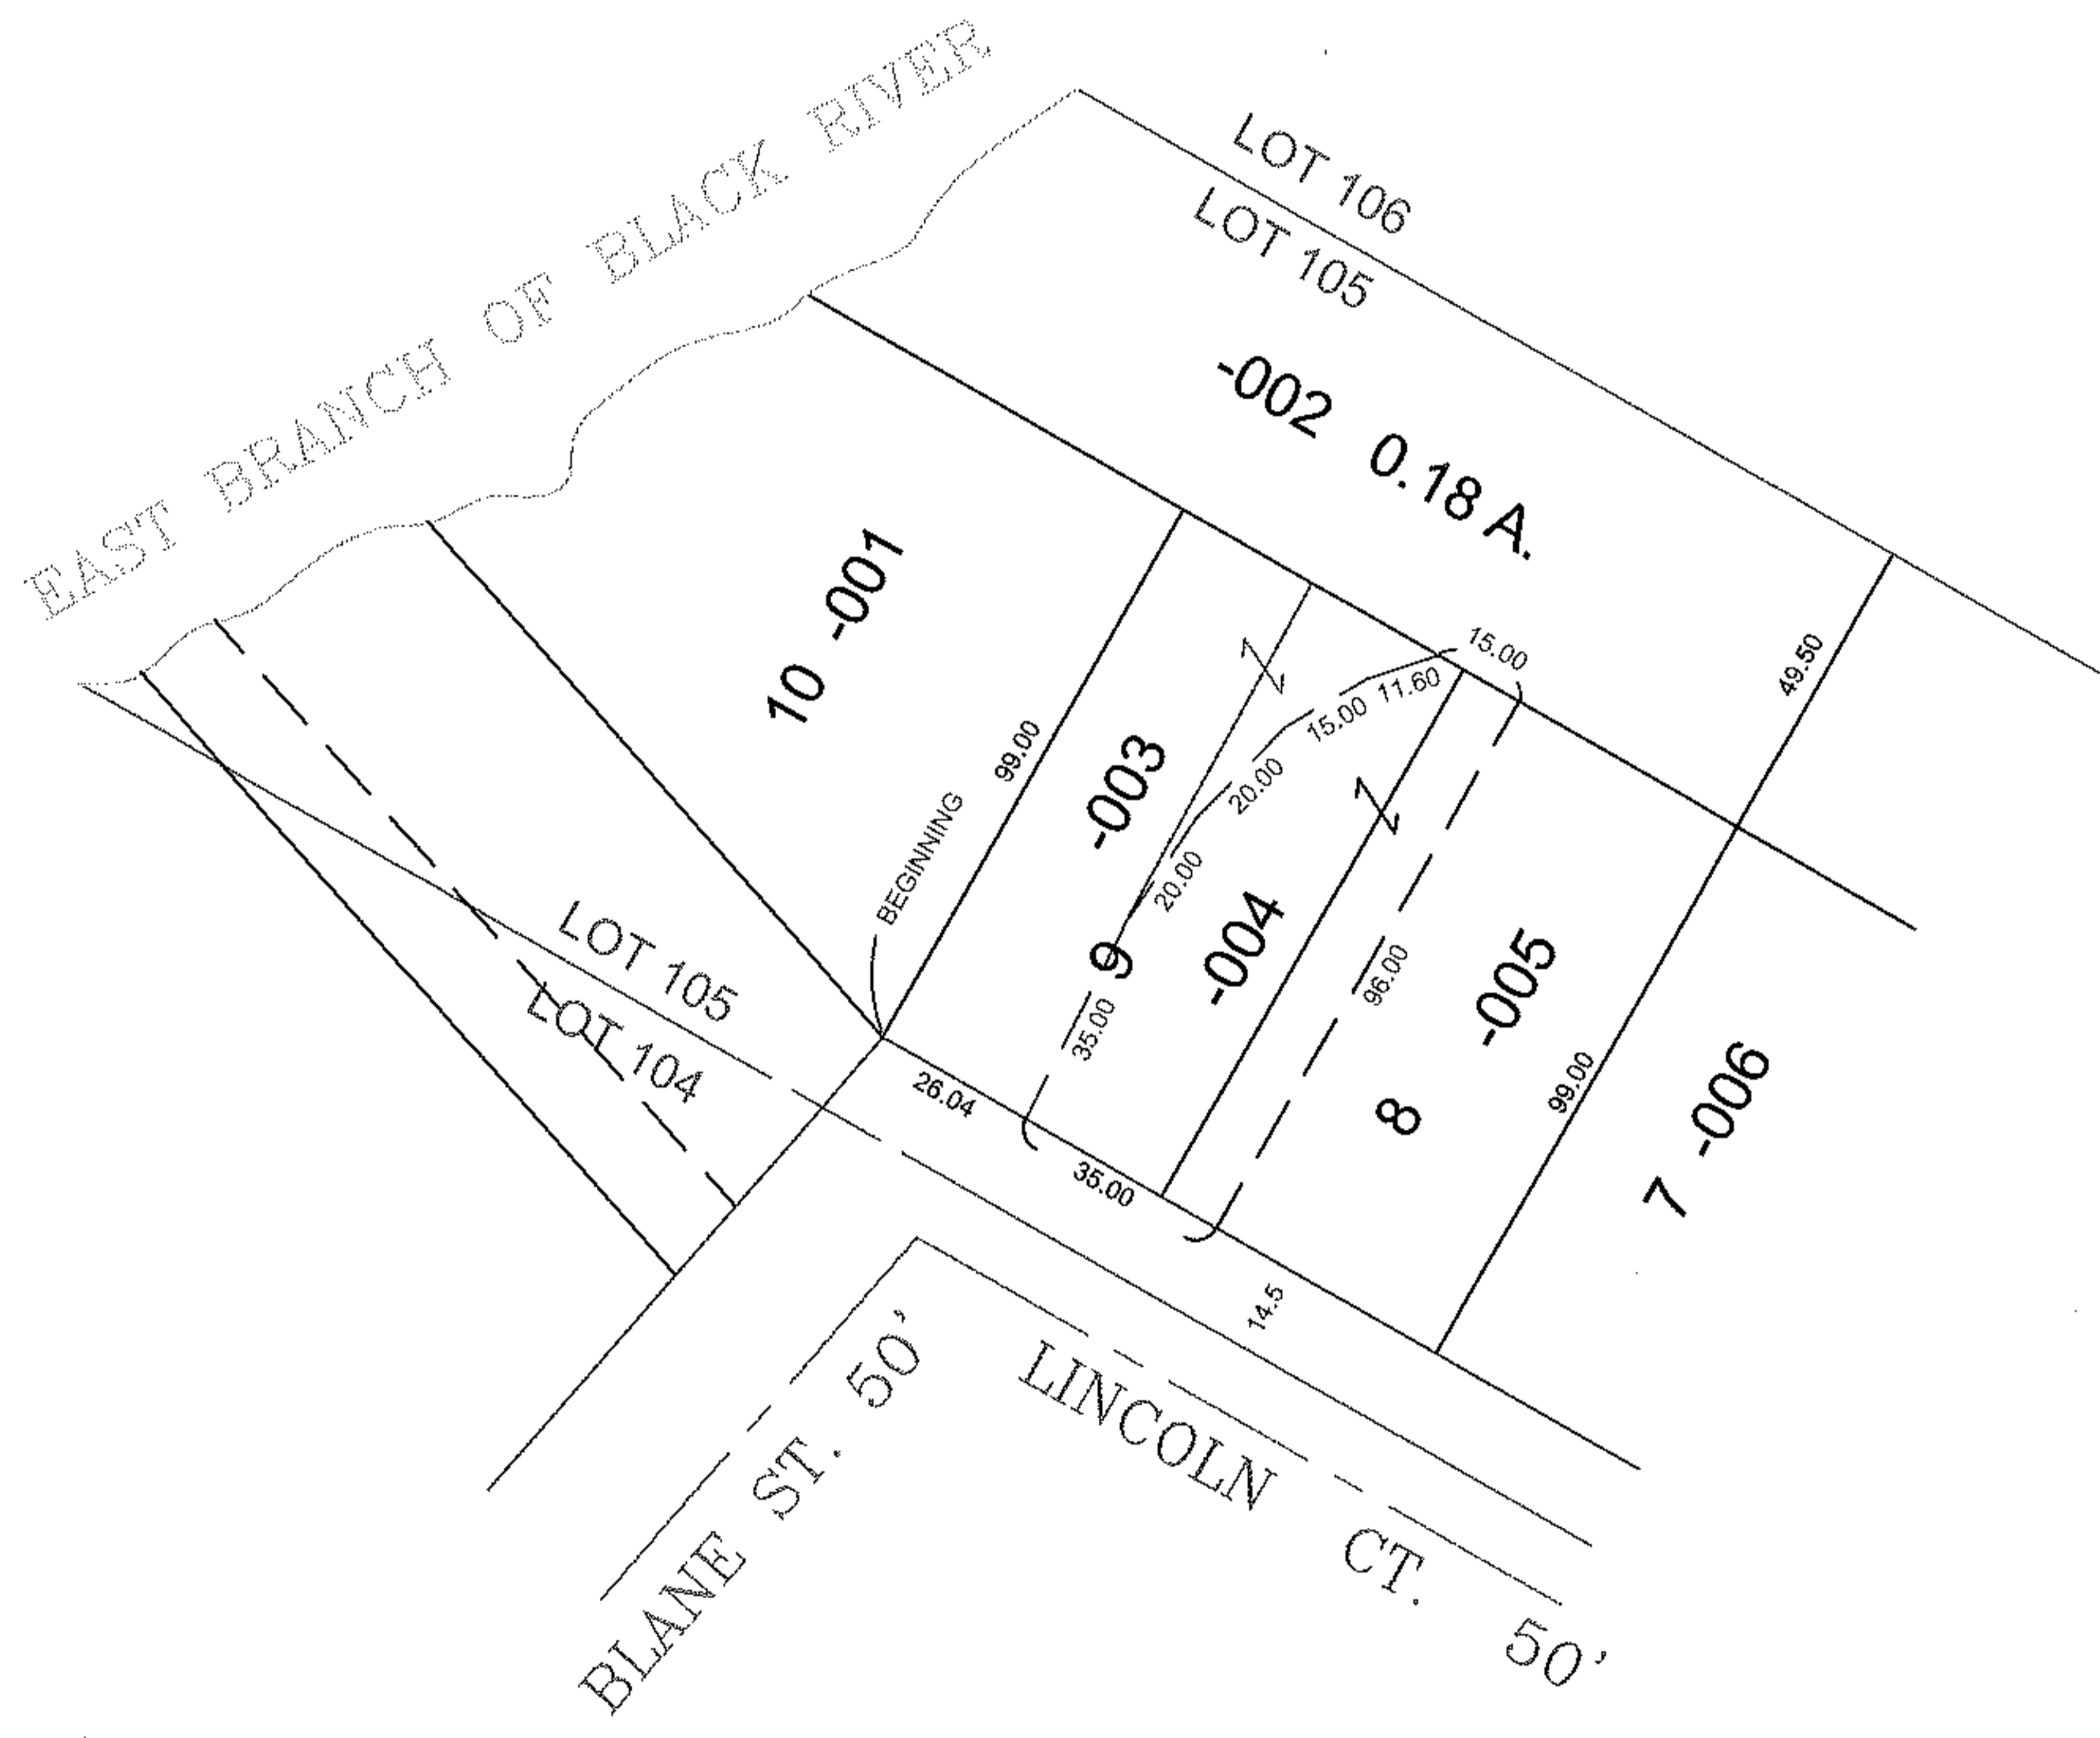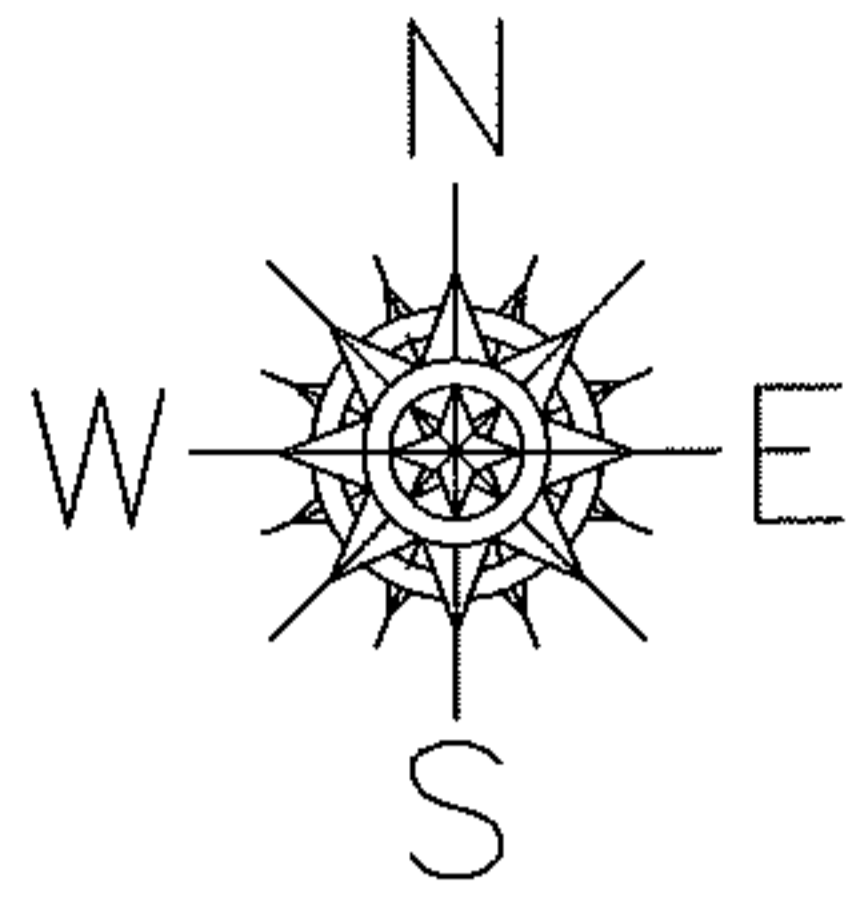

## SPLITS/DEEDS PROCESSED

LORAIN COUNTY TAX MAP DEPARTMENT  
226 MIDDLE AVE. ELYRIA, OHIO

SURVEYED BY:	NONE
CLOSURE:	NONE
MAP PAGE(S):	6-121
APPROVED BY:	TJS
DATE:	7/30/10
SCALE:	1" = 50'
PRIOR INST.:	