




RASTER

05-02063

PARENT PARCEL: 01-00-056-000-076

CHILD PARCEL: 01-00-056-000-082, -083

STARTING POINT: CENTERLINE OF RICE RD & O.L. 56

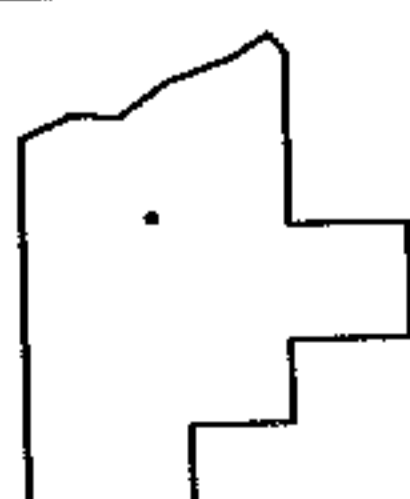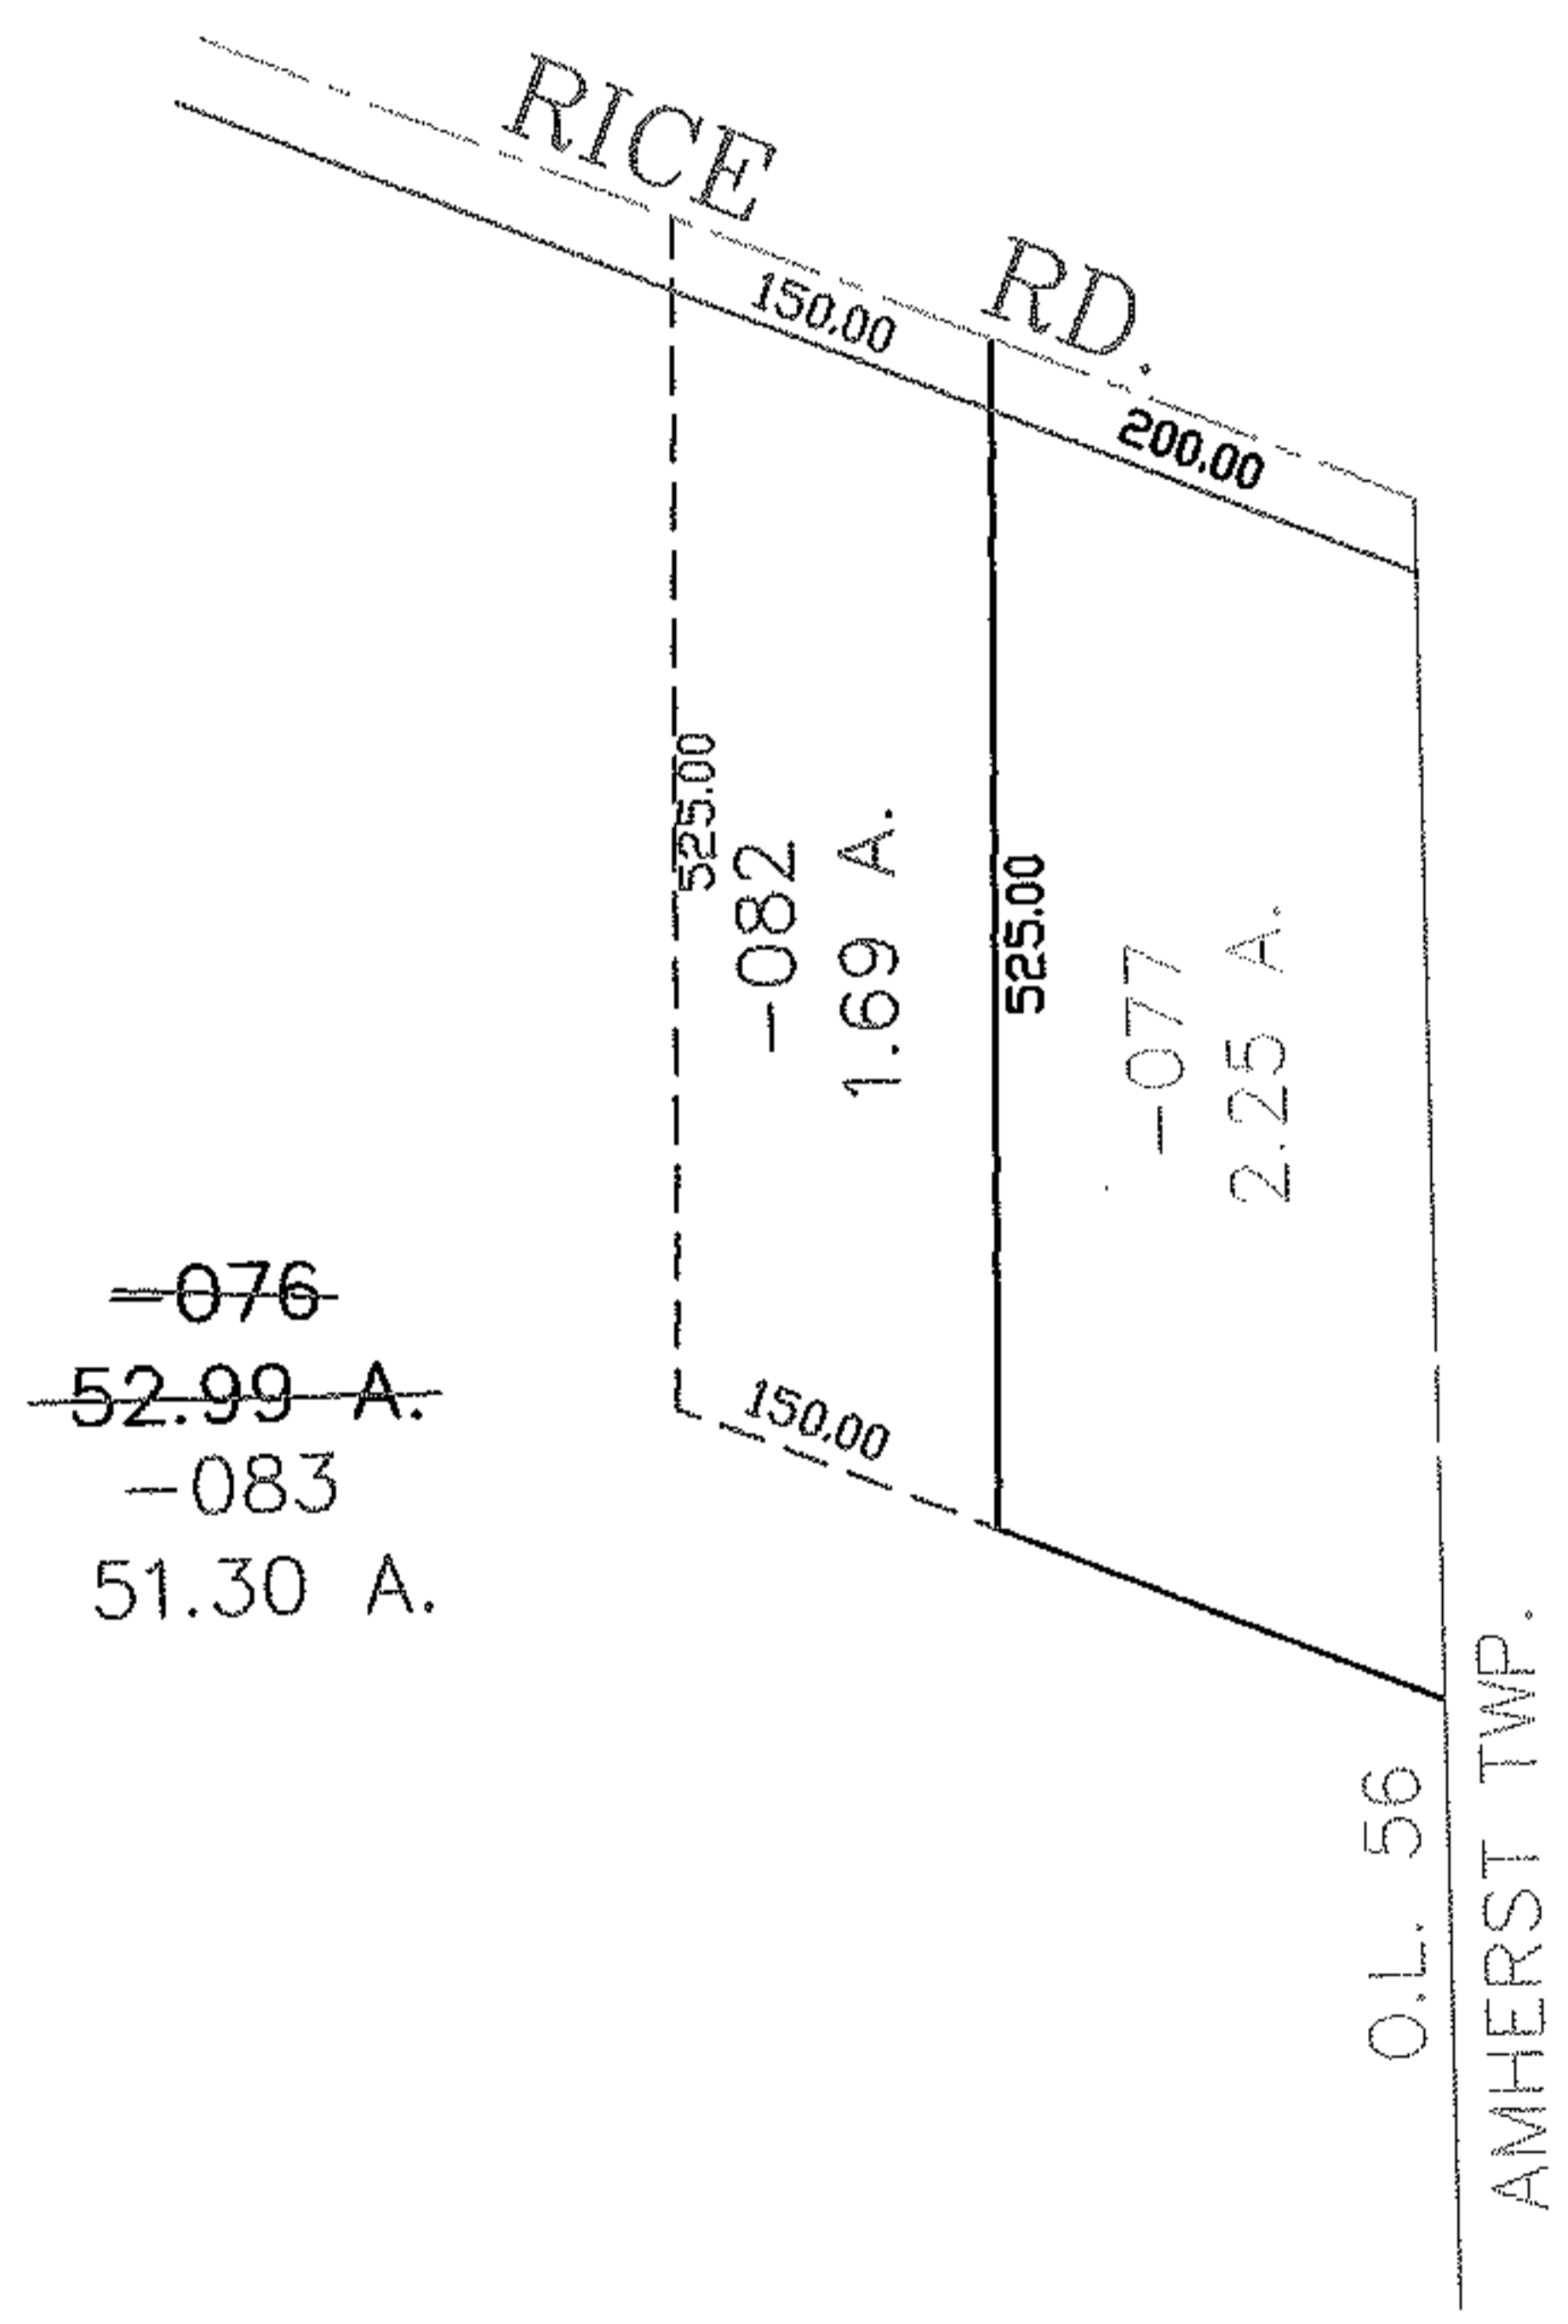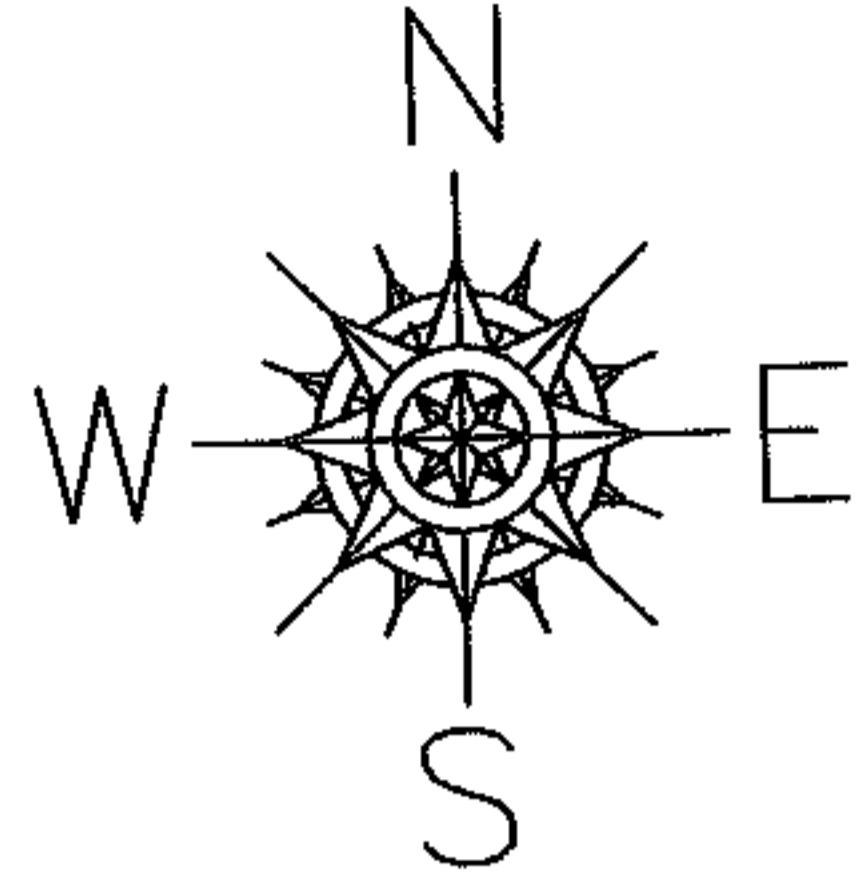

SPLITS/DEEDS PROCESSED
 LORAIN COUNTY TAX MAP DEPARTMENT
 226 MIDDLE AVE. ELYRIA, OHIO

SURVEYED BY: THOMAS SIMON
 CLOSURE: 0.00 : 10,000
 MAP PAGE(S): 1-1
 APPROVED BY: JAH DATE: 12-20-05
 SCALE: 1" = 200' PRIOR INSTRUMENT: 20030954748