
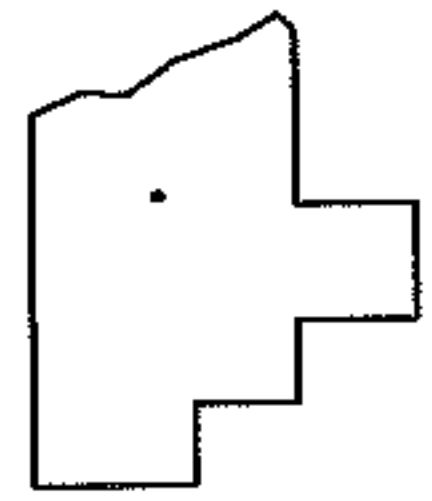
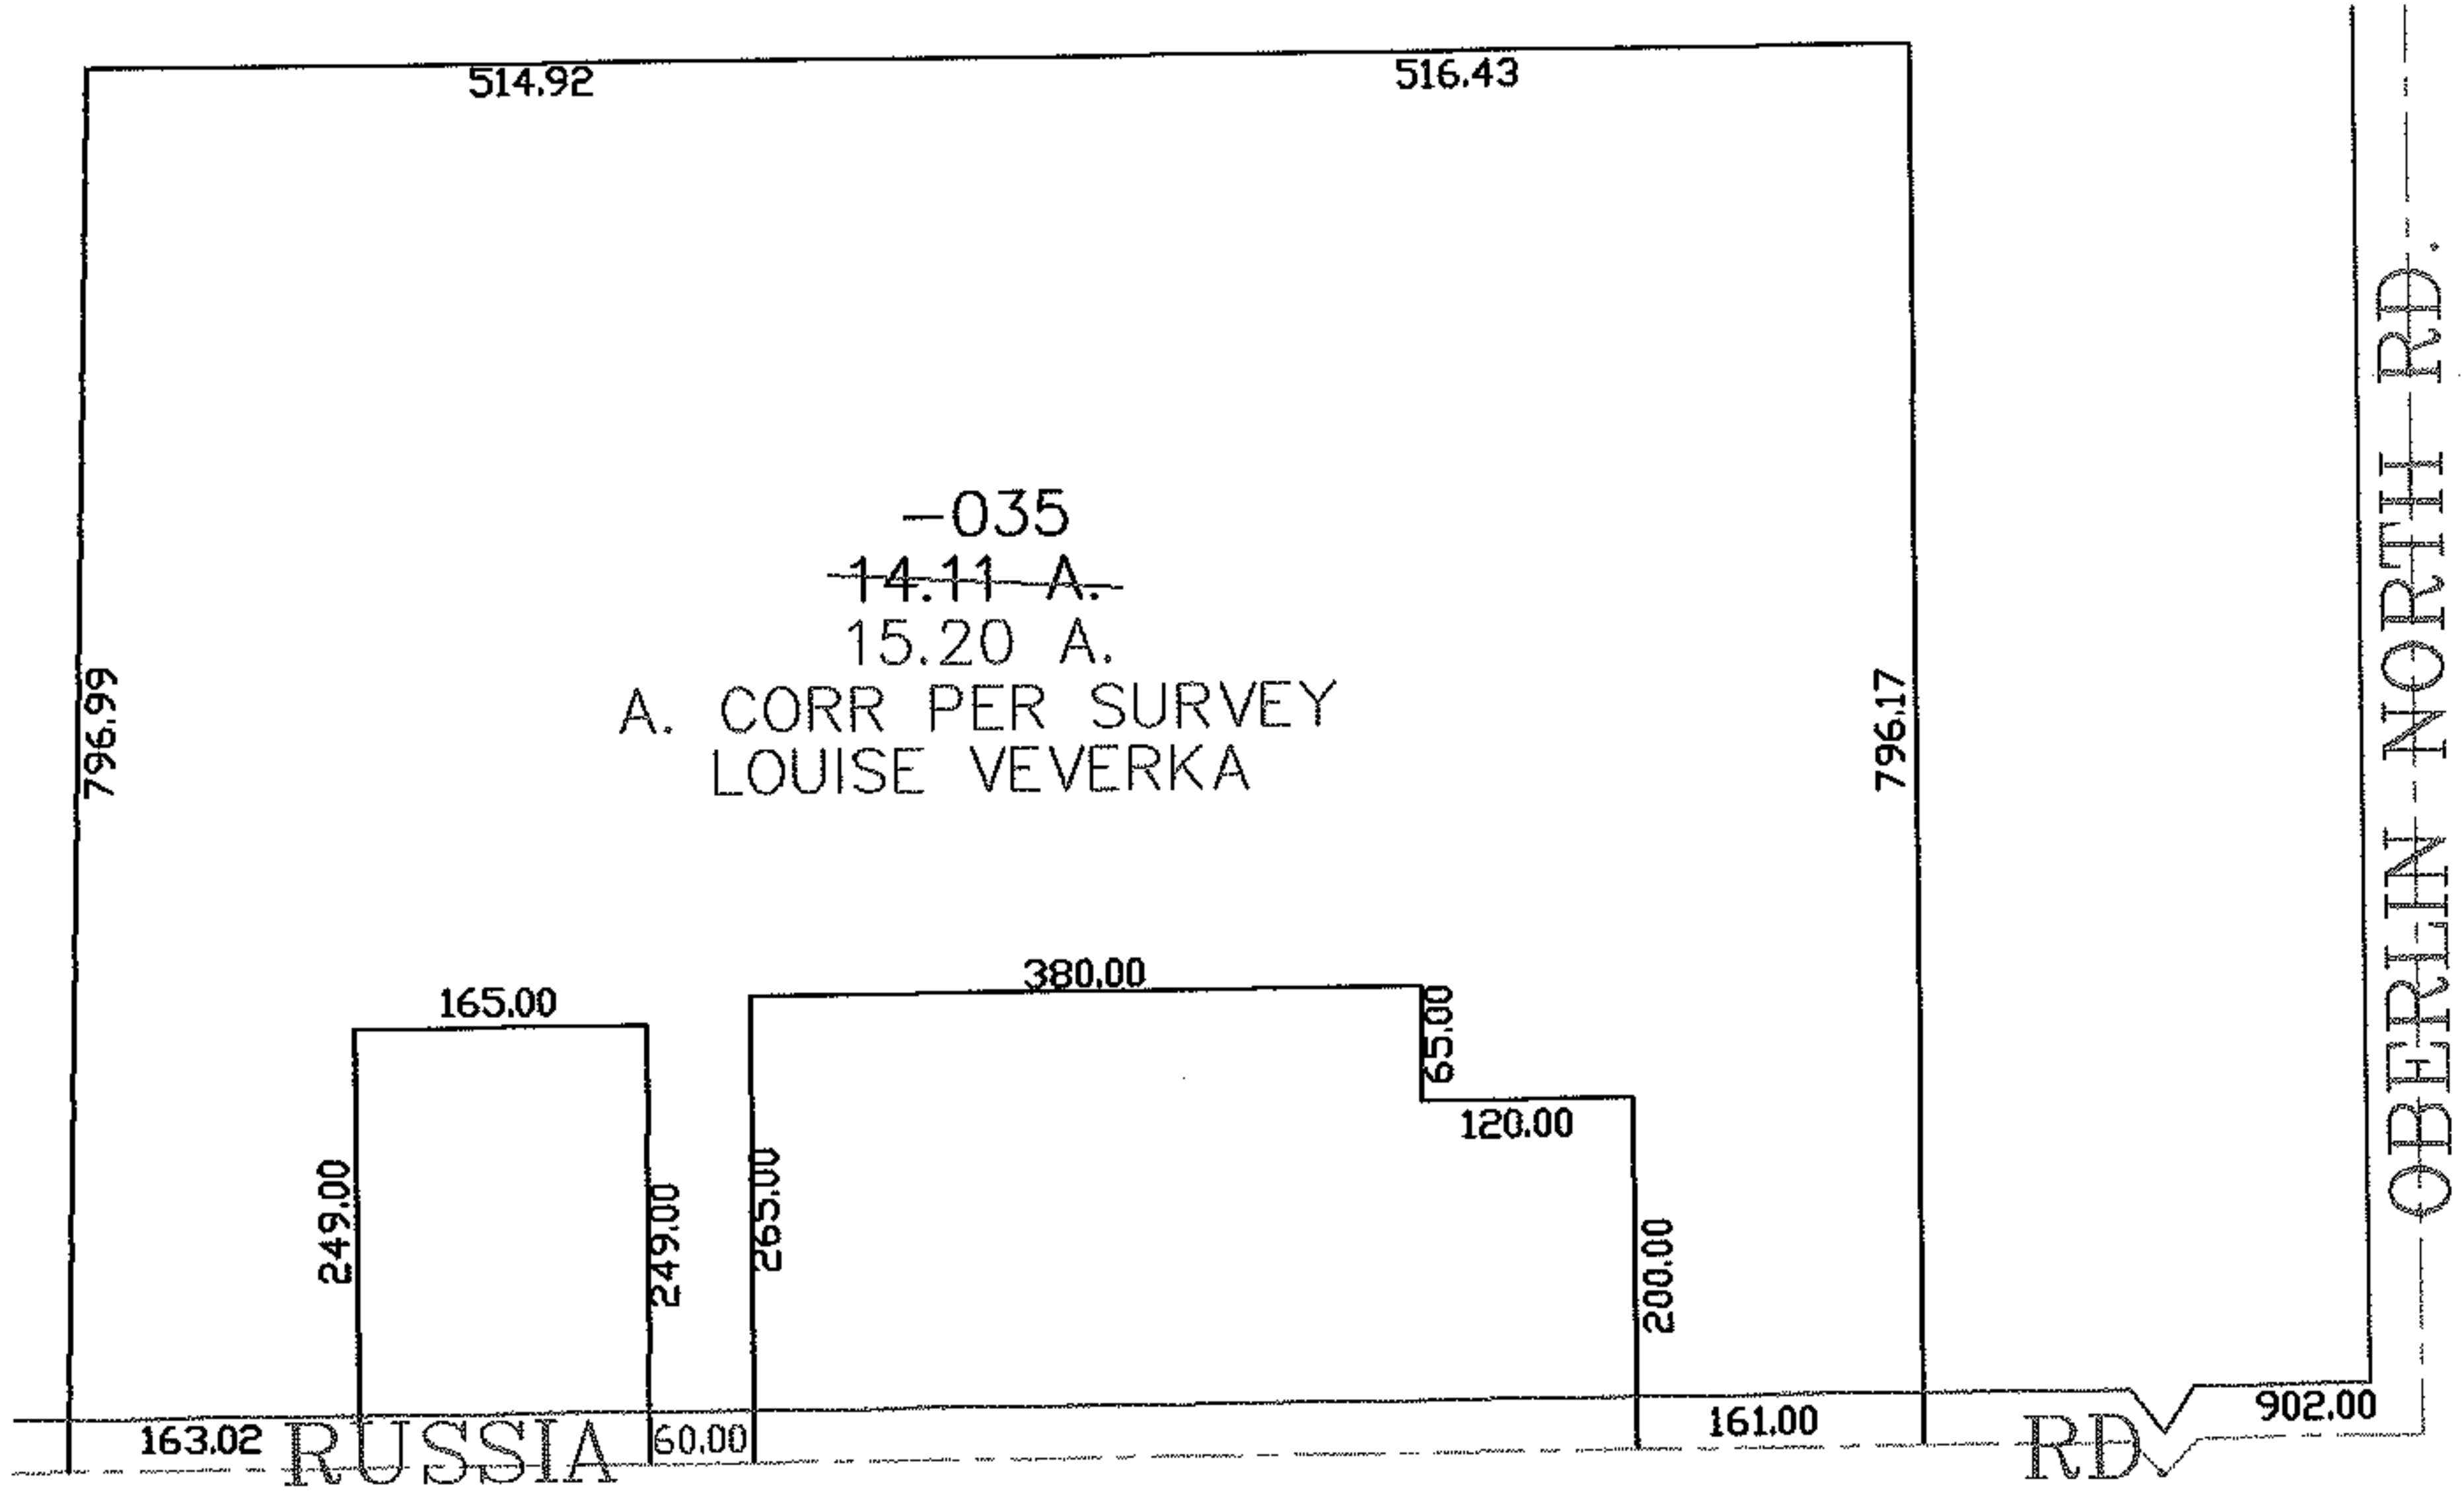


KASTER

PARENT PARCEL: 09-00-015-000-035
CHILD PARCEL: 09-00-015-000-035
STARTING POINT: CENTERLINE OF RUSSIA RD & OBERLIN NORTH RD.

05-02064

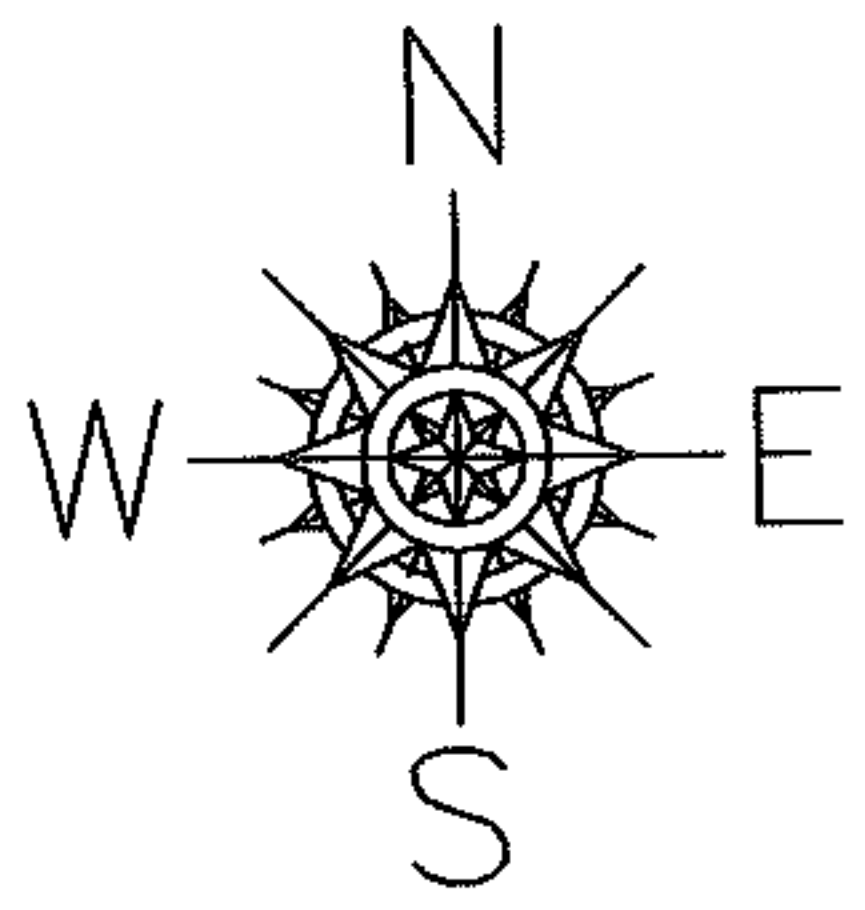

SPLITS/DEEDS PROCESSED
LORAIN COUNTY TAX MAP DEPARTMENT
226 MIDDLE AVE. ELYRIA, OHIO

SURVEYED BY: LOUISE VEVERKA
CLOSURE: 0.00 : 10,000
MAP PAGE(S): 9-B
APPROVED BY: JAH DATE: 12-20-05
SCALE: 1" = 200 PRIOR INSTRUMENT: 200000672769