




RASTER

PARENT PARCEL: 10-00-008-112-039

CHILD PARCEL: 10-00-008-112-040, -041

STARTING POINT: CL OF LAGRANGE RD

05-02067

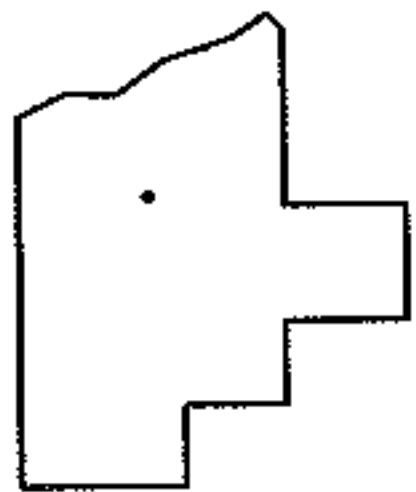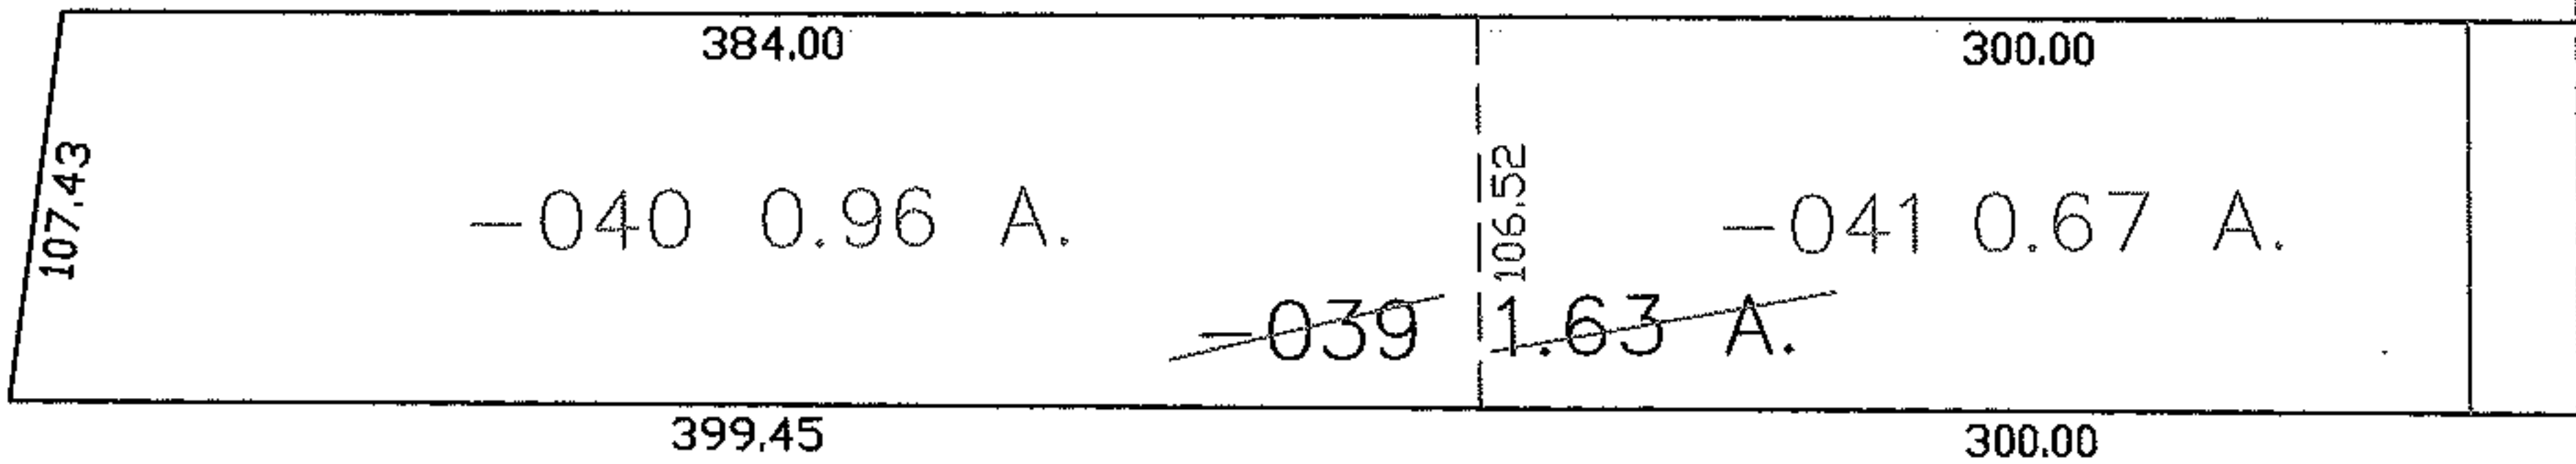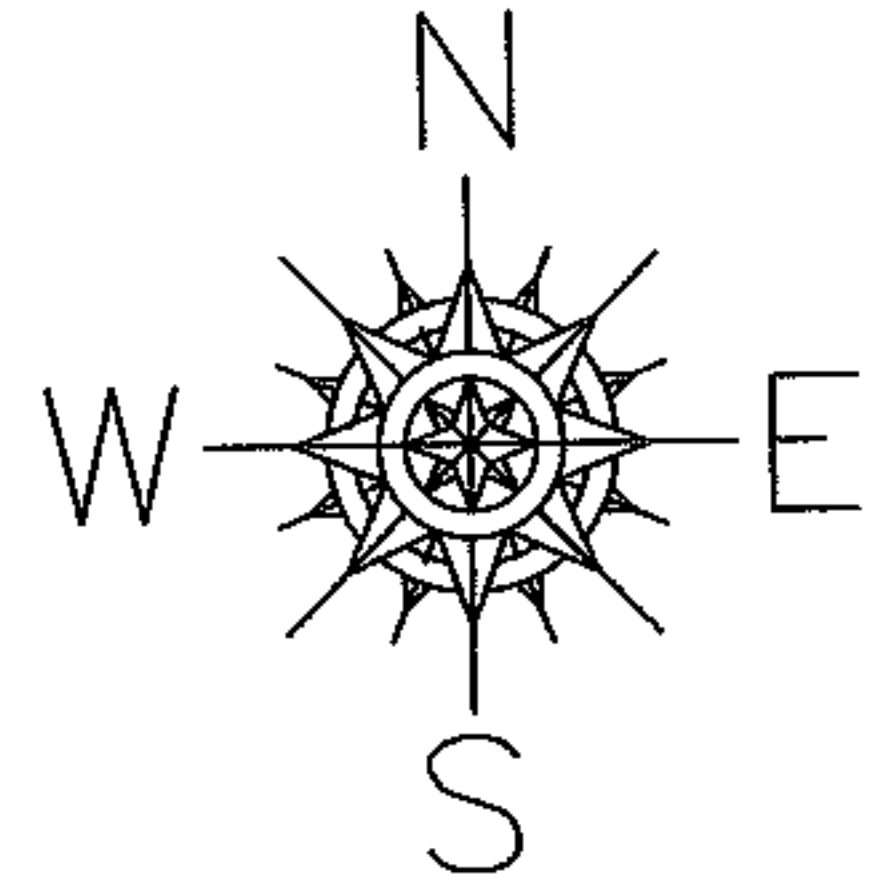

**SPLITS/DEEDS PROCESSED**

LORAIN COUNTY TAX MAP DEPARTMENT  
226 MIDDLE AVE. ELYRIA, OHIO

SURVEYED BY: KS

CLOSURE: 1:10,000

MAP PAGE(S): 10-00-008-F

APPROVED BY: DRH DATE: 12/21/2005

SCALE: 1" = 100' PRIOR INSTRUMENT: 20050089992