


RASER

PARENT PARCEL: 07-00-042-103-075
CHILD PARCEL: 07-00-043-103-075
ARTING POINT: BLOCK "III" IN MEADOW LAKES SUB. NO. 2 (VOL.72 PGS.72-78)


10-02071-C

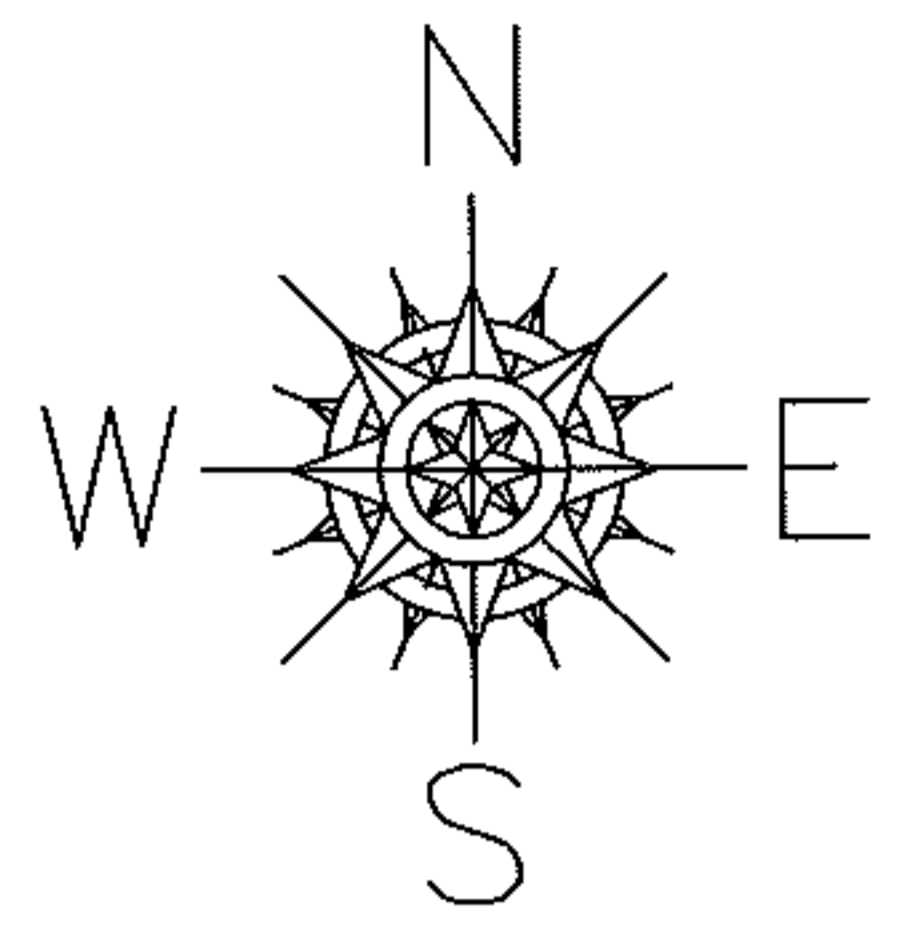

PARCEL NUMBER CORRECTION
ON BLUE SHEET AND DEVNET ONLY
CORRECT ON MAPS AND REGISTER

BLOCK "III"
07-00-043-103-075
~~07-00-042-103-075~~
0.18 A.

BLOCK "CC"
07-00-043-103-069
~~07-00-042-103-069~~
0.05 A.

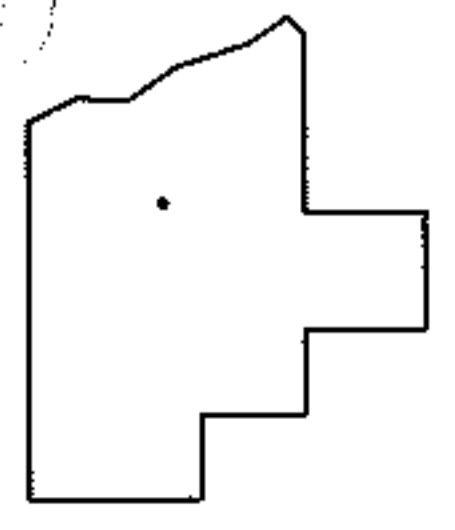

SPLITS/DEEDS PROCESSED
LORAIN COUNTY TAX MAP DEPARTMENT
226 MIDDLE AVE. ELYRIA, OHIO

SURVEYED BY: DAVID L. ELWELL
CLOSURE: .01:10,000
MAP PAGE(S): 7-00-043-D
APPROVED BY: RRM DATE: 8-20-10
SCALE: 1"= 100 PRIOR INST.: VOL.72 PGS.72-78