




EASTER

PARENT PARCEL: 02-02-003-102-088

CHILD PARCEL: 02-02-003-102-089, -090

STARTING POINT: CENTERLINE OF LEAVITT RD & NANTUCKET DR.

05-02072

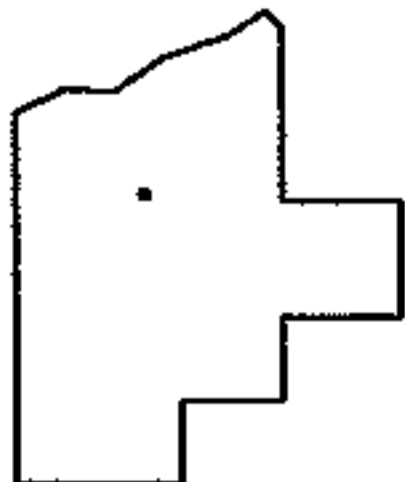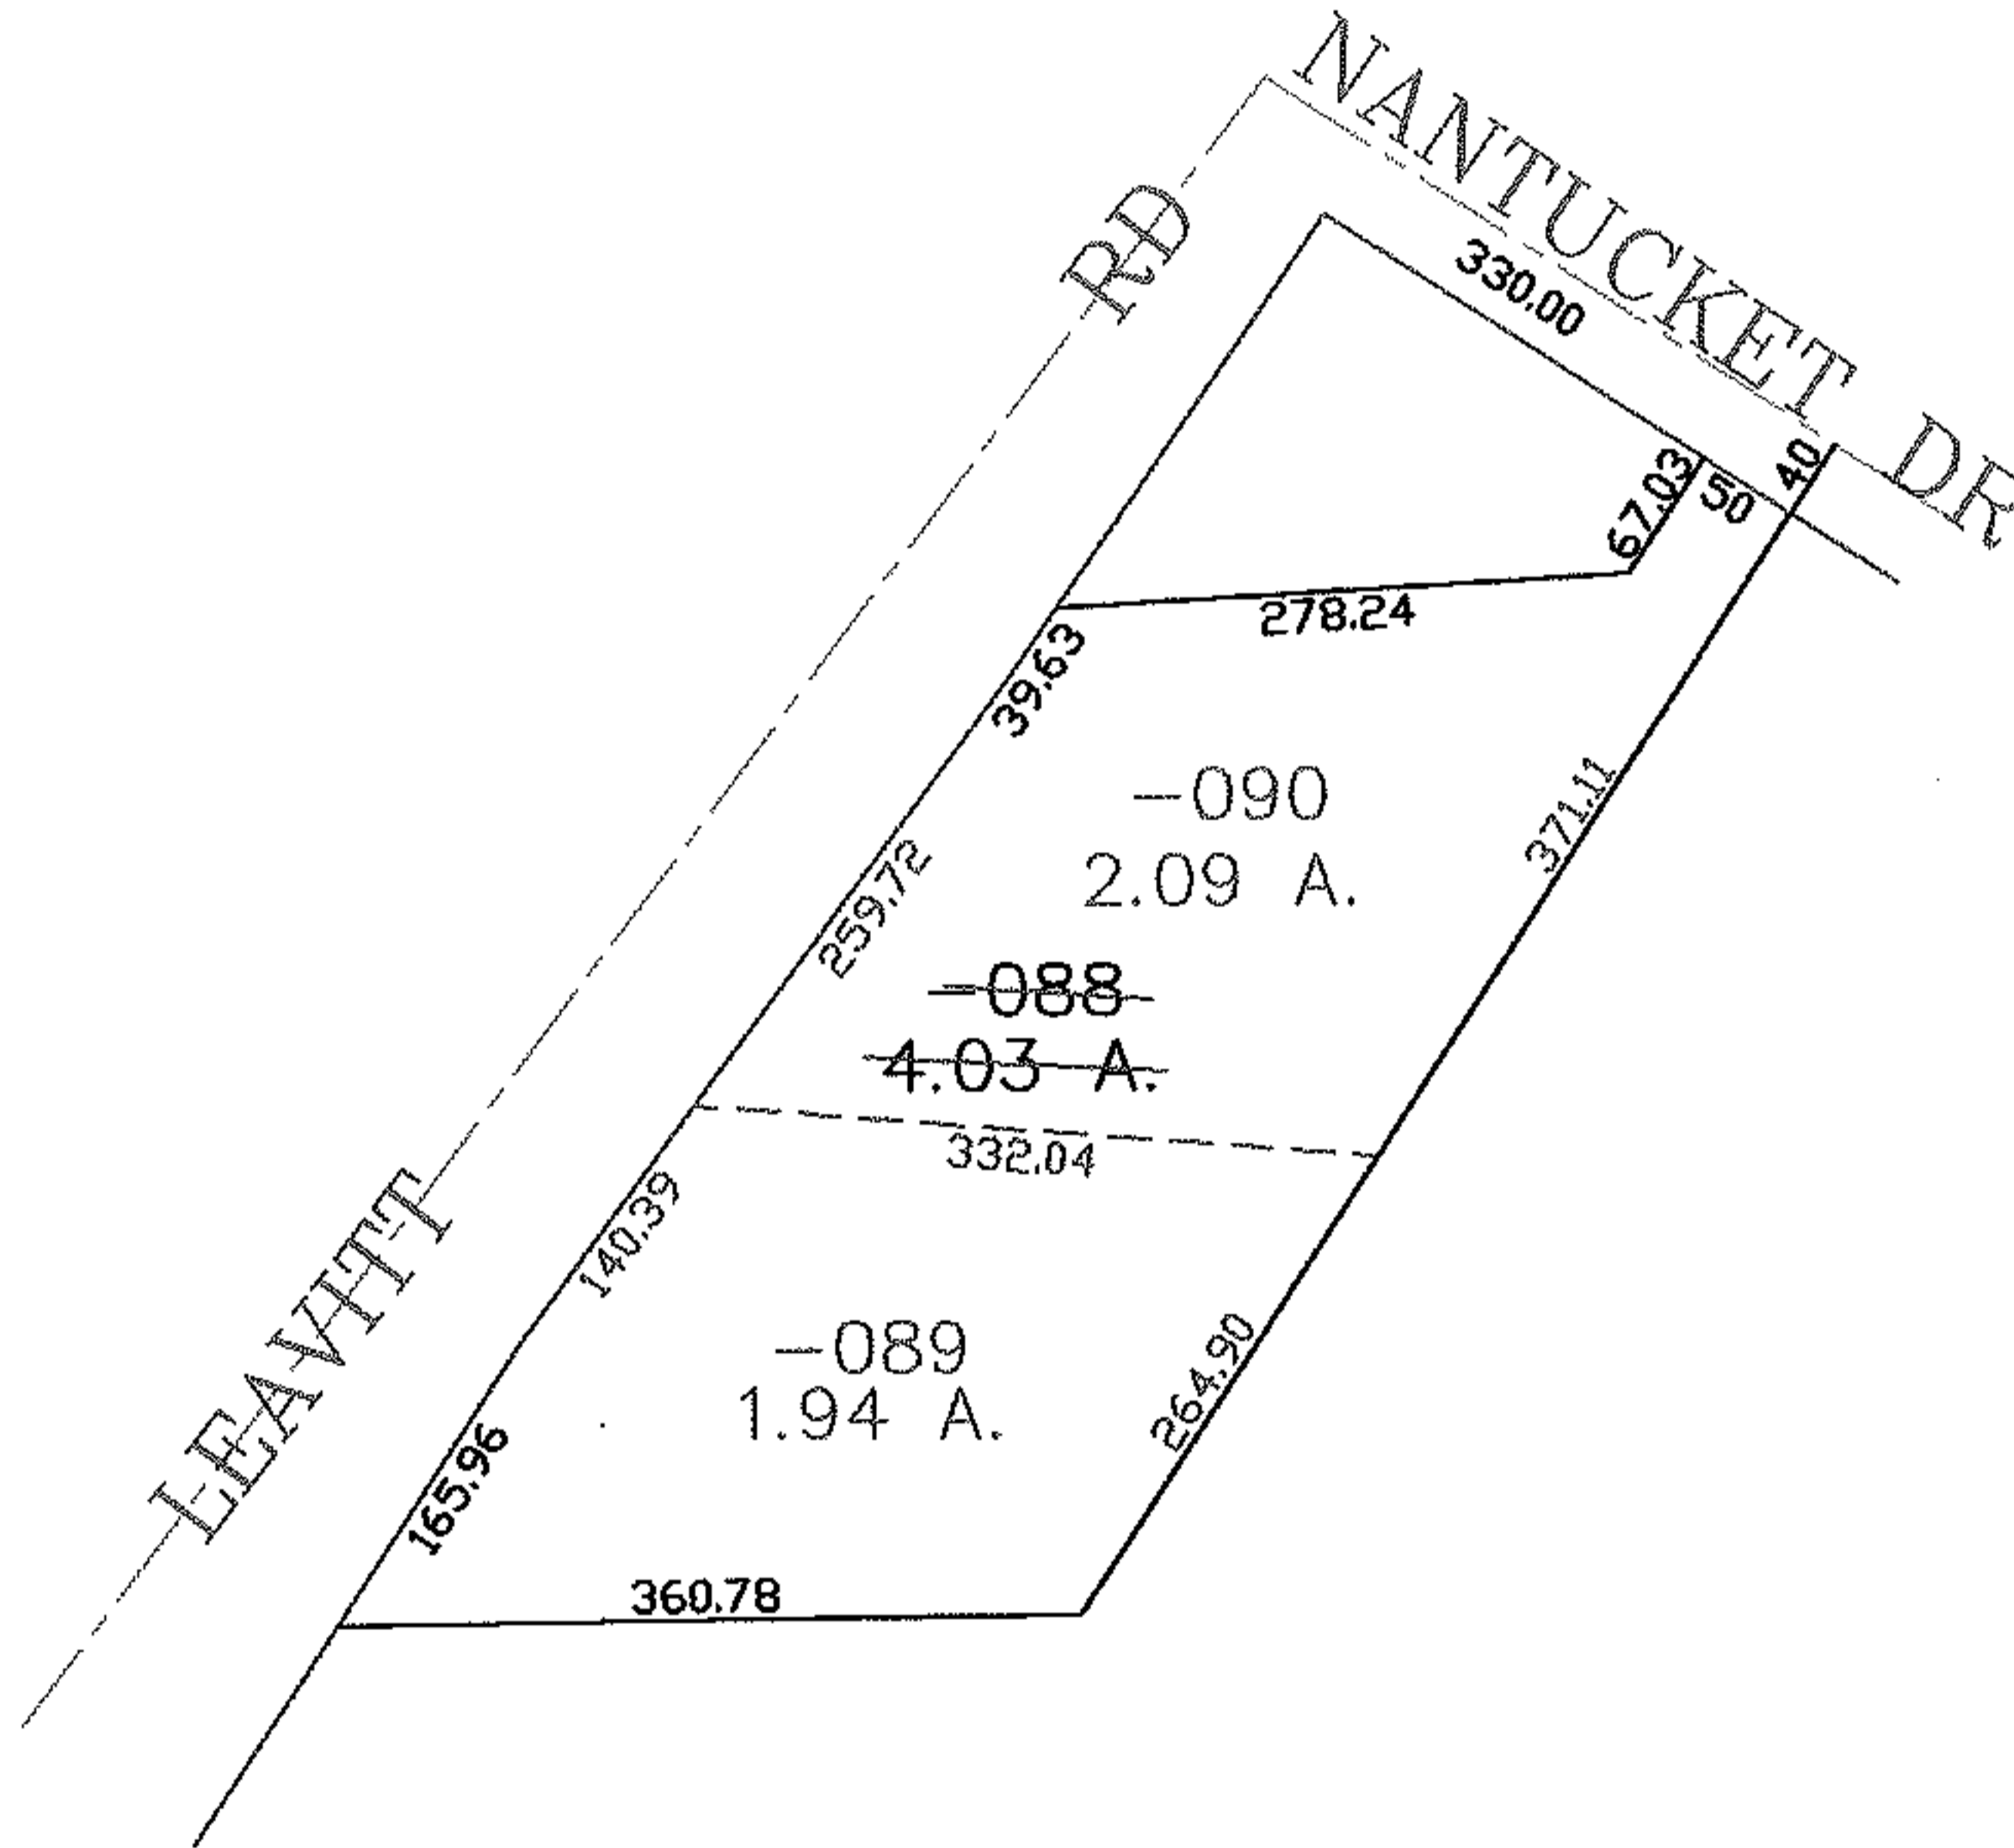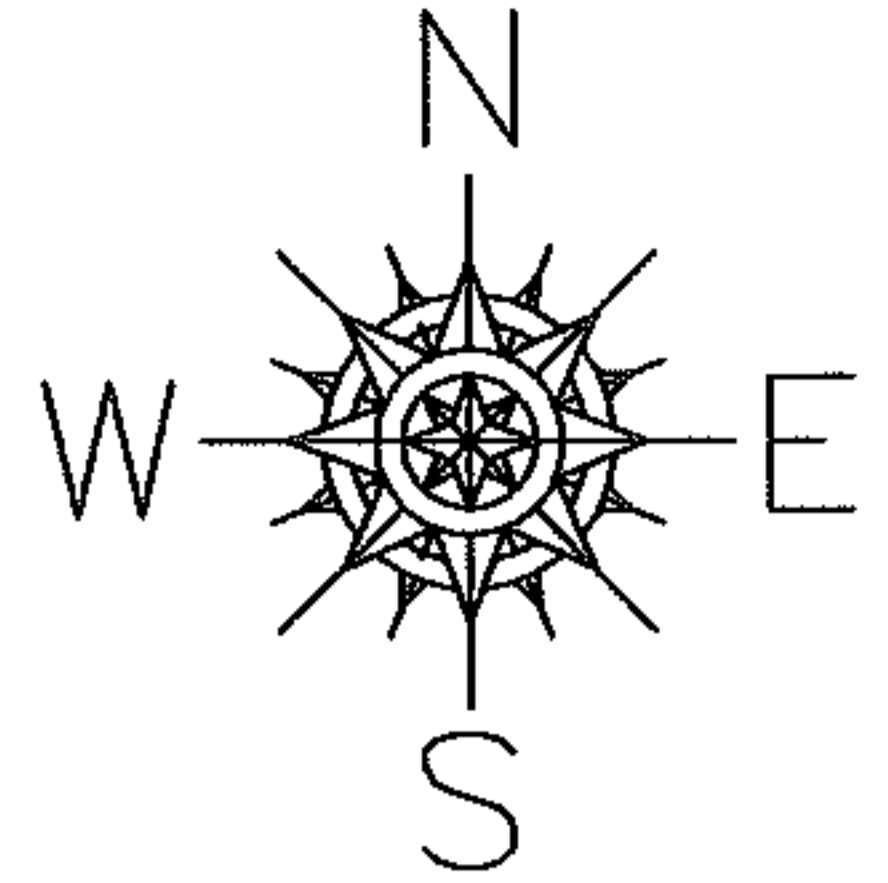

SPLITS/DEEDS PROCESSED

LORAIN COUNTY TAX MAP DEPARTMENT
226 MIDDLE AVE. ELYRIA, OHIO

SURVEYED BY: DAVE ELWELL

CLOSURE: 0.00 : 10.000

MAP PAGE(S): 02-02-003-B

APPROVED BY: JAH DATE: 12-28-05

SCALE: 1" = 200 PRIOR INSTRUMENT: 20030888415