



EASTER

PARENT PARCEL: 14-00-054-000-006

CHILD PARCEL: 14-00-054-000-007, -008

STARTING POINT: CENTERLINE OF HUGHES RD. & O.L. 54

05-02075

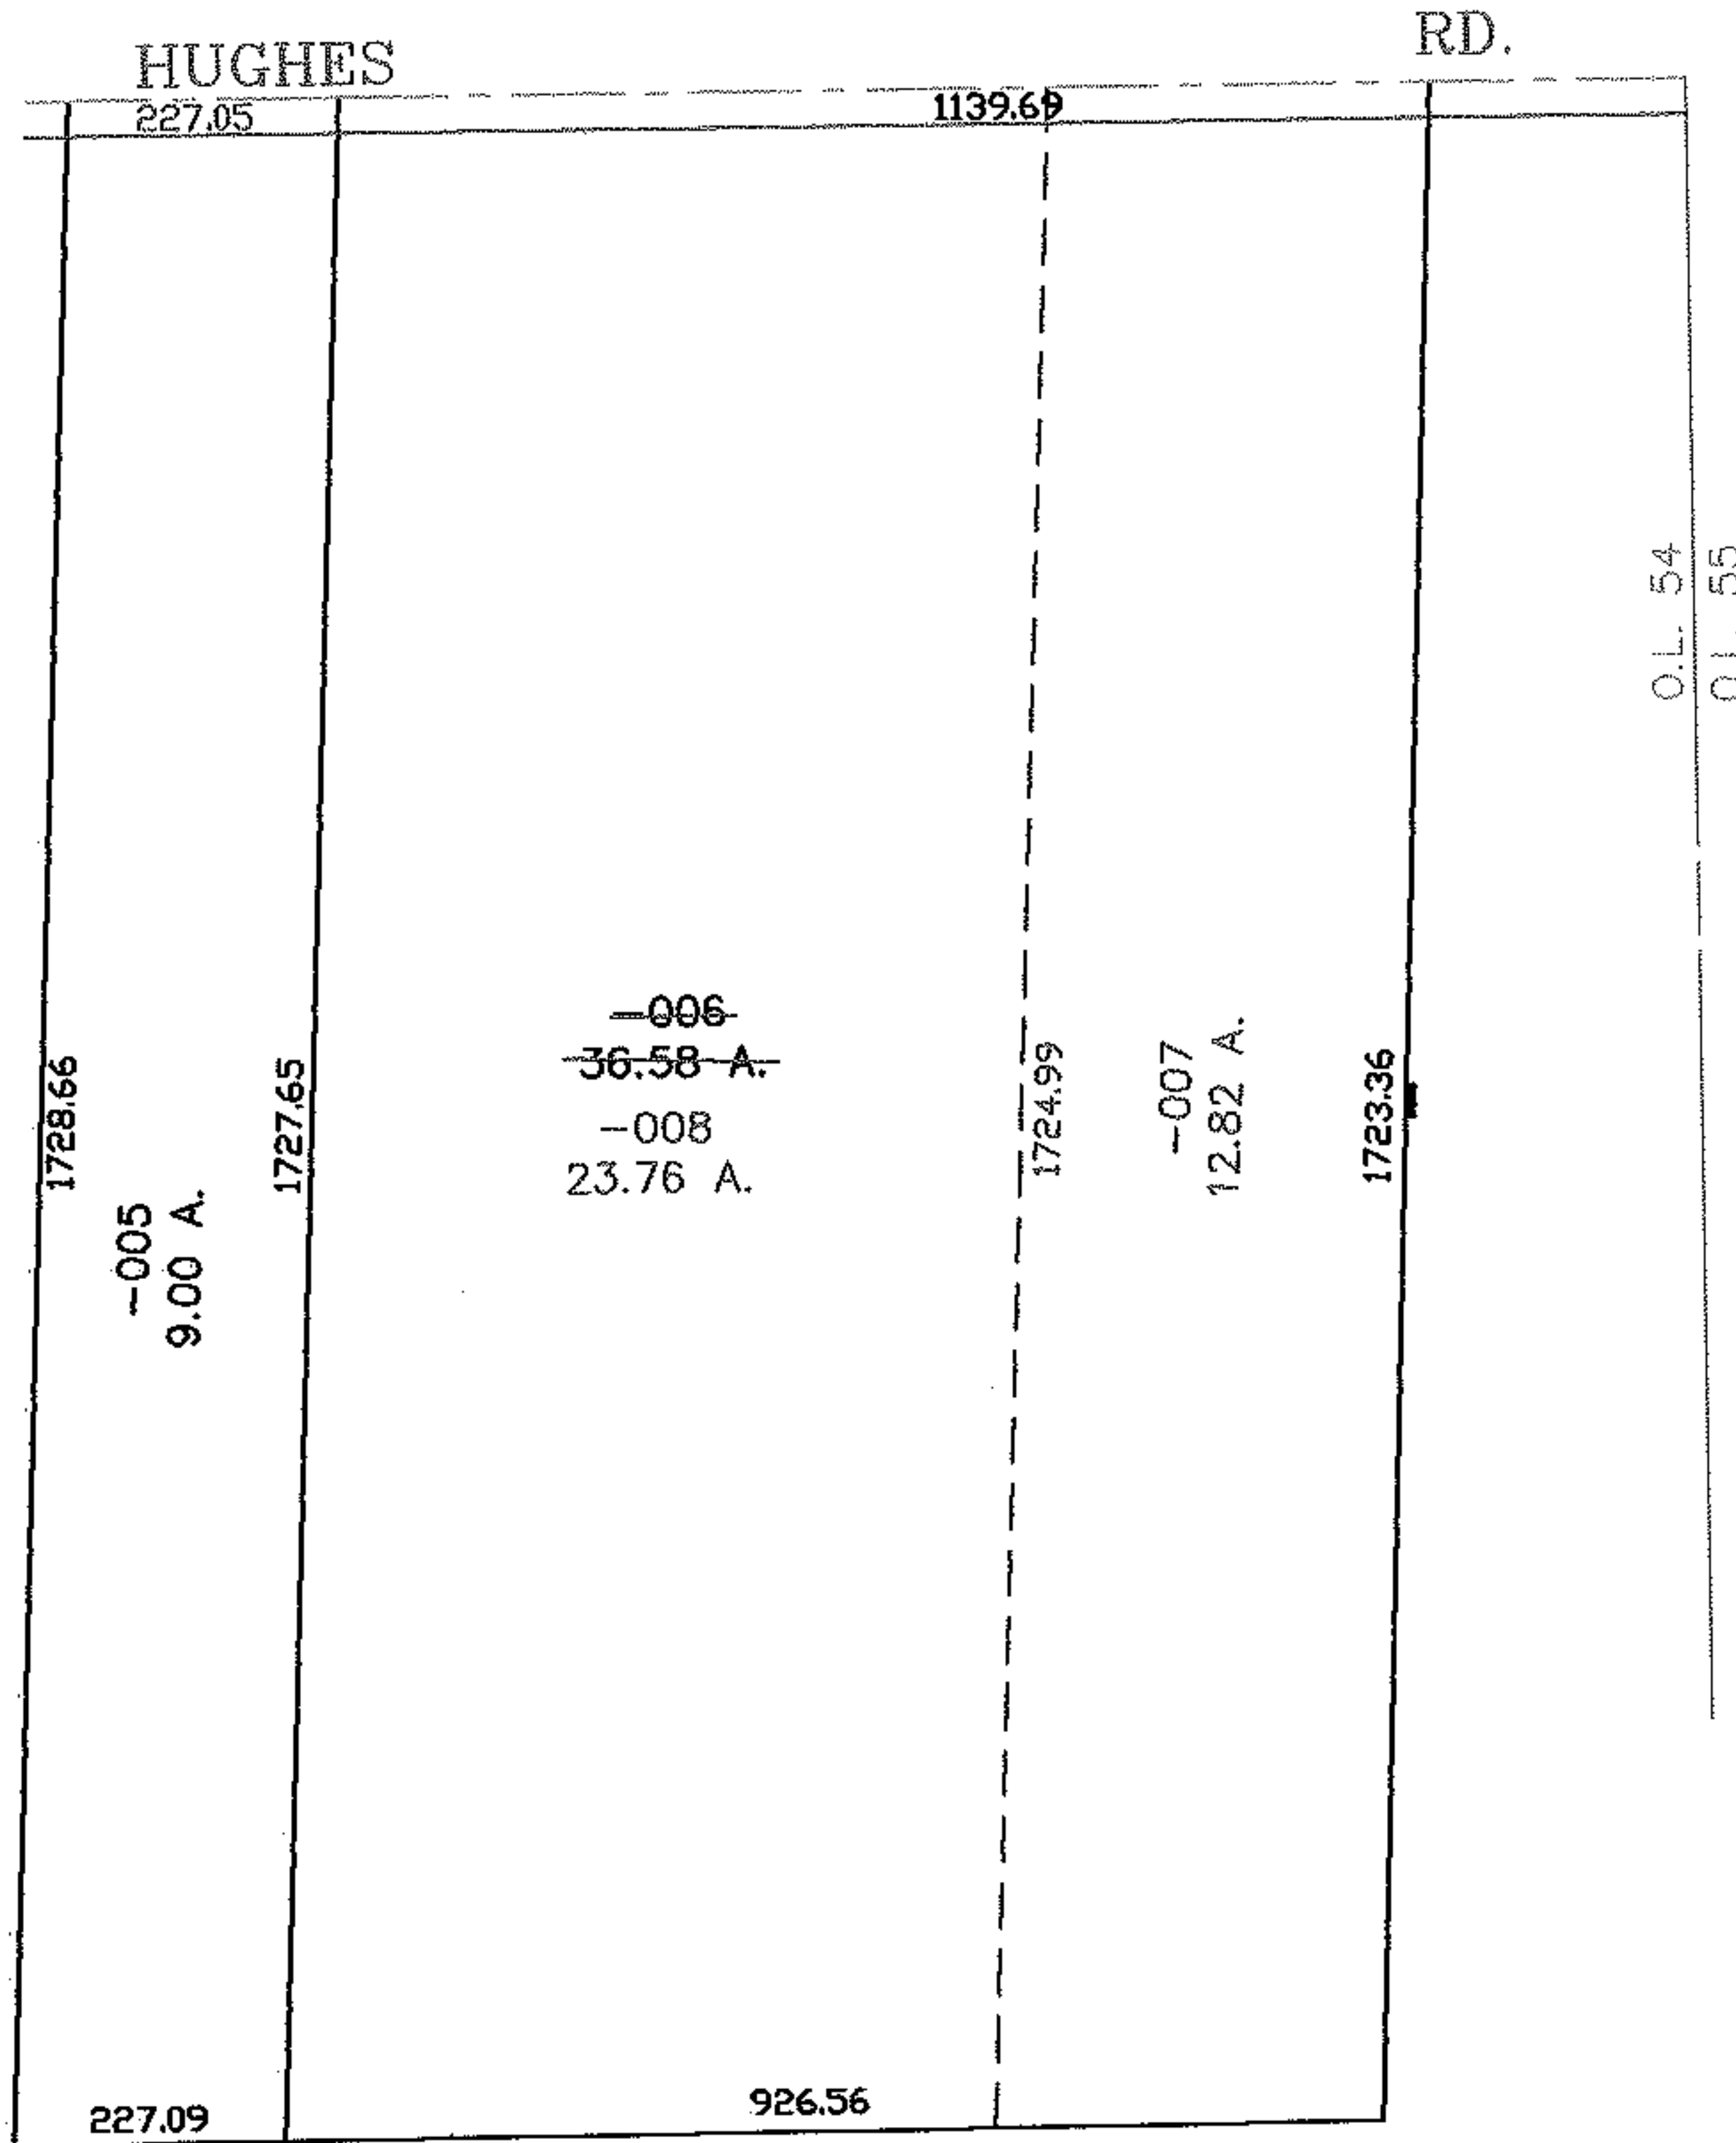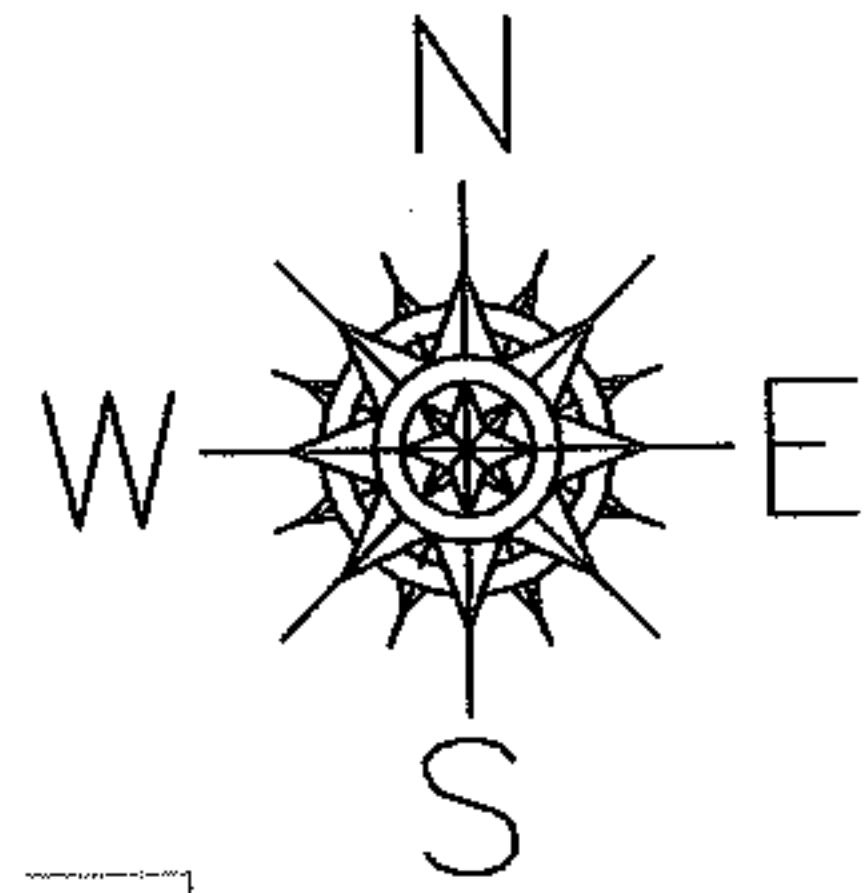

**SPLITS/DEEDS PROCESSED**  
**LORAIN COUNTY TAX MAP DEPARTMENT**  
 226 MIDDLE AVE. ELYRIA, OHIO

SURVEYED BY: RICHARD CARLSON  
 CLOSURE: 0.00 : 10.000  
 MAP PAGE(S): 14-00-054-B  
 APPROVED BY: JAH DATE: 1-4-06  
 SCALE: 1" = 300' PRIOR INSTRUMENT: 20050061024