


RASTER

PARENT PARCEL: 02-02-013-101-001

10-02078-A

CHILD PARCEL:

STARTING POINT: INTERSECTION OF THE WEST LINE OF O.L.13 AND C/L OF MEISTER RD.

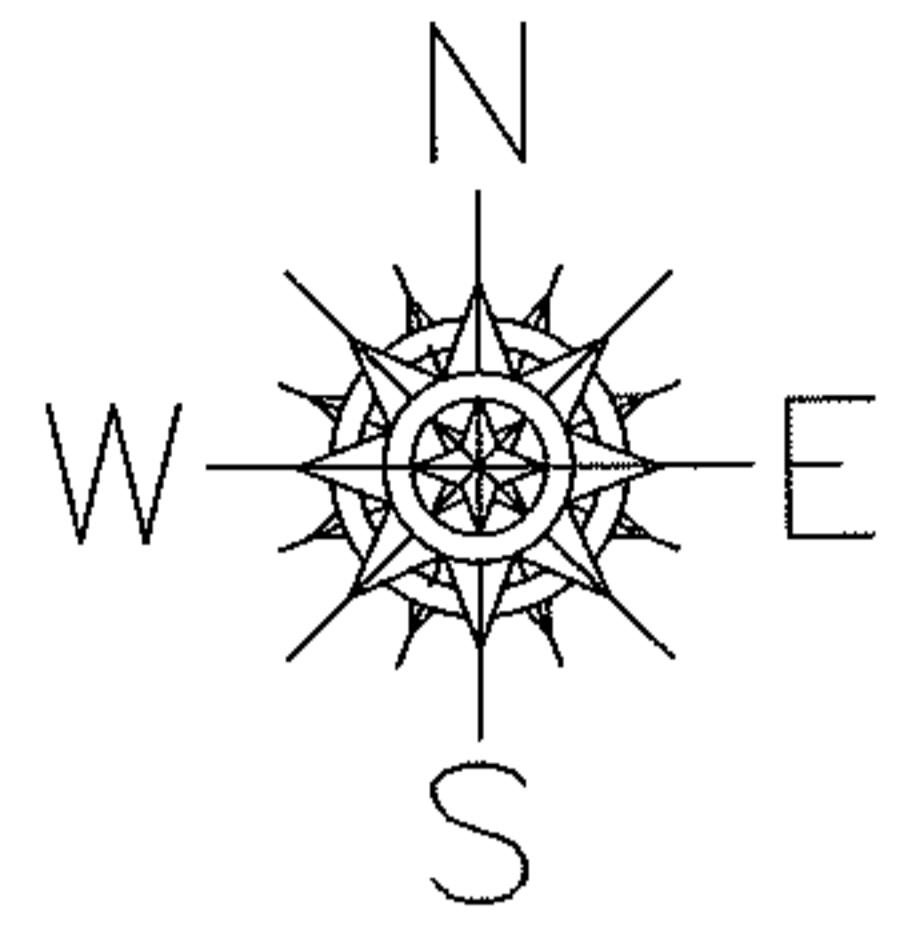


ADD SURVEY BEFORE NEXT TRANSFER

02-02-013-101-001

11.42 A.
~~11.33 A.~~

AC.CORR.PER.PRIOR DEEDS
DV 697/95
20100344671

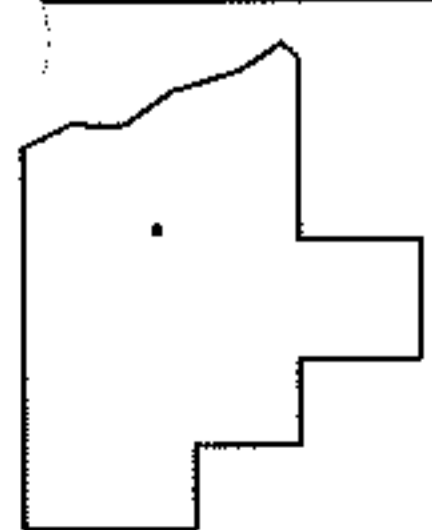

SPLITS/DEEDS PROCESSED

LORAIN COUNTY TAX MAP DEPARTMENT
226 MIDDLE AVE. ELYRIA, OHIO

SURVEYED BY:	RAY E. HOLLIS
CLOSURE:	DOESN'T CLOSE
MAP PAGE(S):	2-02-013-A
APPROVED BY:	RRM DATE: 8-30-10
SCALE:	1" = 200 PRIOR INST.: SEE ABOVE