
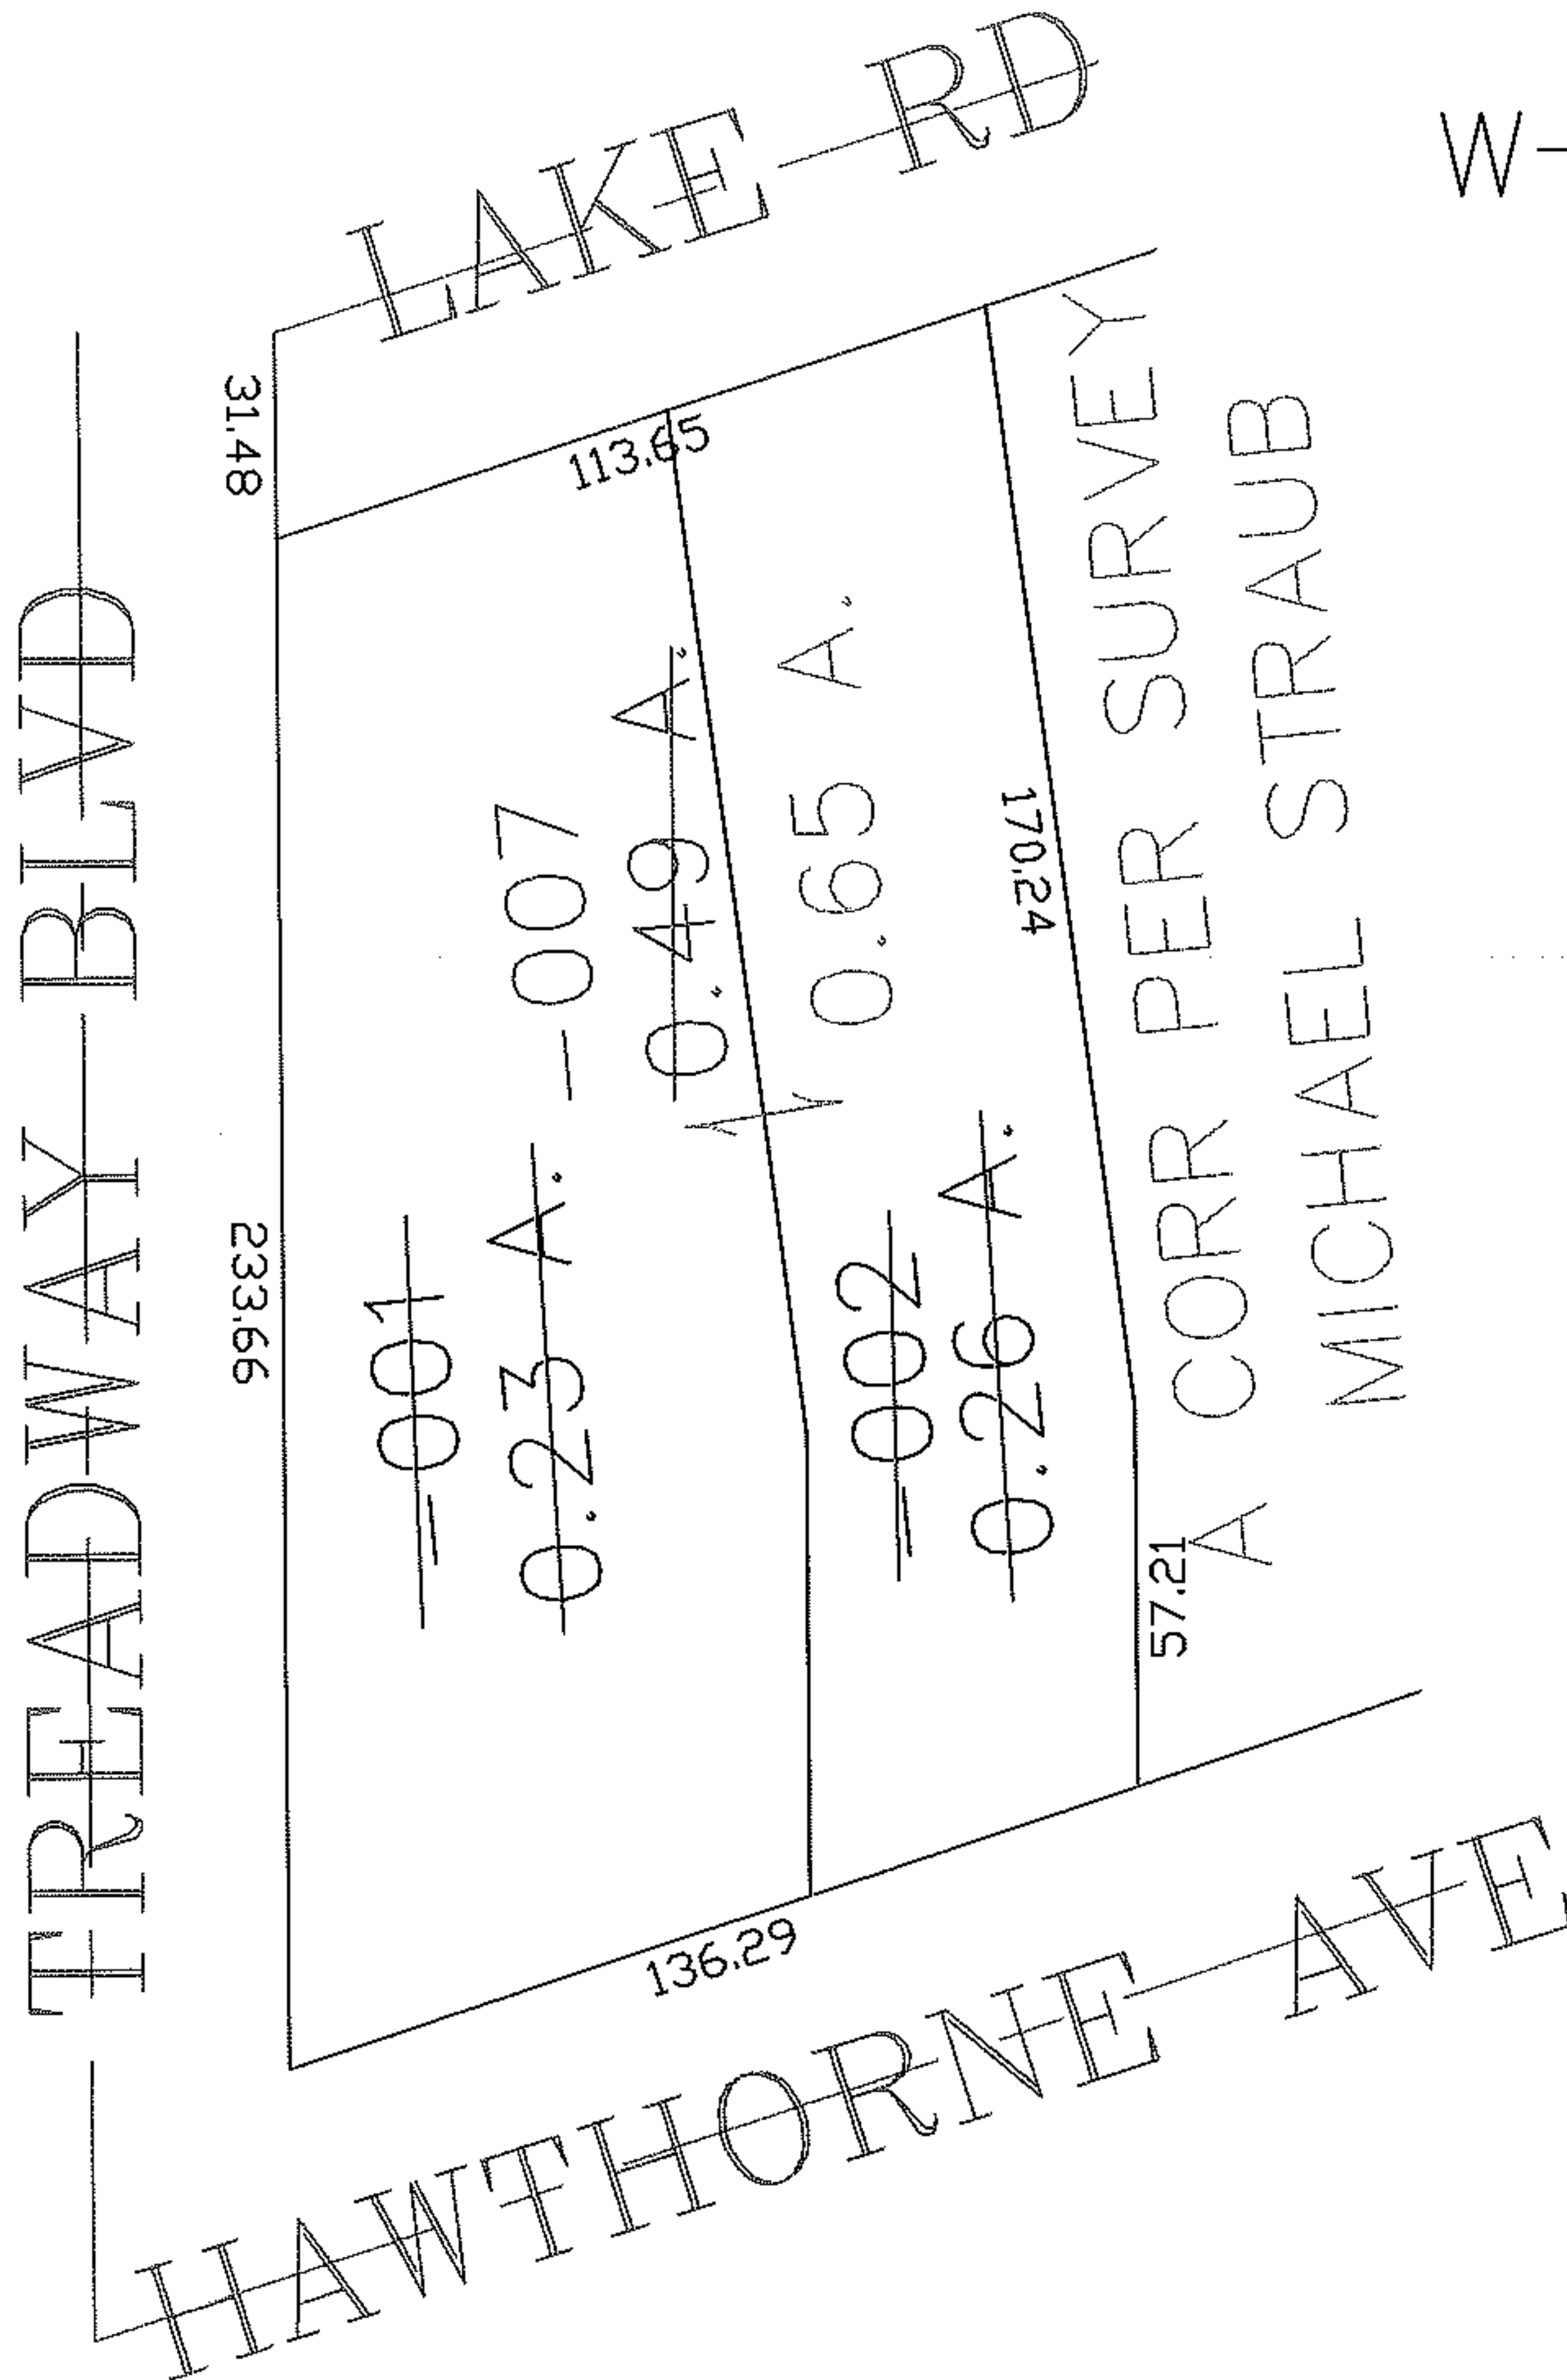


PARENT PARCEL: 03-00-037-104-001, -002

CHILD PARCEL: 03-00-037-104-007

STARTING POINT: CENTERLINE OF LAKE RD & SIDELINE OF TREADWAY BLVD

06-02078

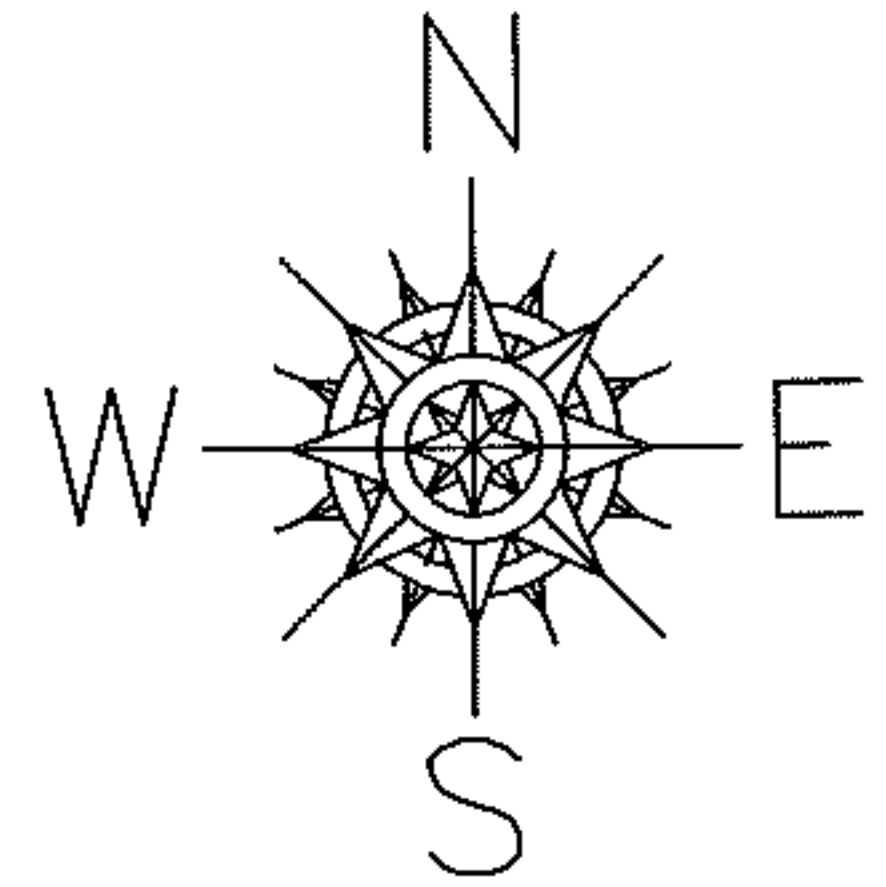

SPLITS/DEEDS PROCESSED

LORAIN COUNTY TAX MAP DEPARTMENT  
226 MIDDLE AVE. ELYRIA, OHIO

SURVEYED BY: MICHAEL STRAUB

CLOSURE: 0.00 : 10.000

MAP PAGE(S): 03-00-037-A

APPROVED BY: JAH DATE: 1-9-06

SCALE: 1" = 100 PRIOR INSTRUMENT: 20030920125