


*RASTER*

PARENT PARCEL: 03-00-085-101-015 & 03-00-088-101-023  
CHILD PARCEL: XX-XX-XXX-XXX-XXX  
STARTING POINT: XXXXXX

**10-02079-C**

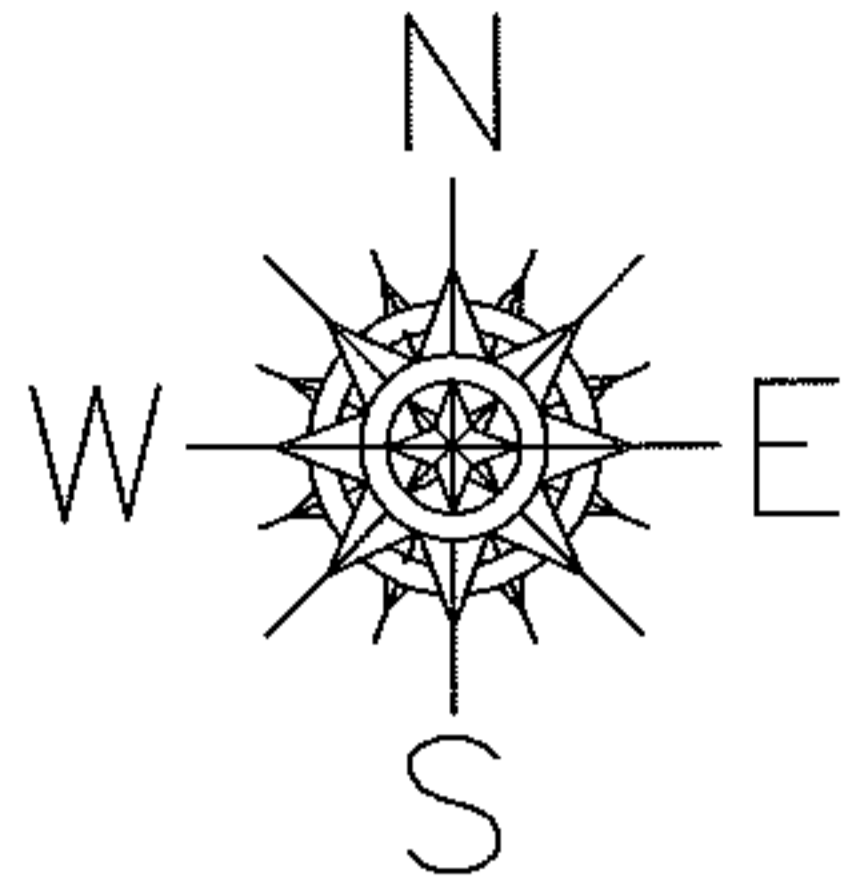

DROP FROM DUPLICATE


~~03-00-085-101-015~~  
~~0.21 A.~~

WENT INTO  
03-00-084-000-014  
219.73 A.

DROP FROM DUPLICATE

~~03-00-088-101-023~~  
~~342.86 A.~~

WENT INTO  
03-00-084-000-018  
113.06 A.  
&  
03-00-084-000-020  
15.52 A.  
&  
03-00-084-000-021  
176.59 A.

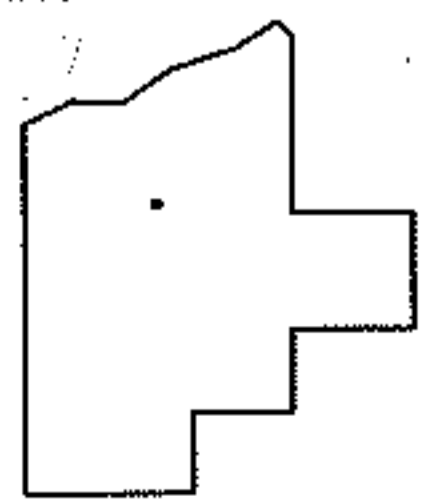

SPLITS/DEEDS PROCESSED

LORAIN COUNTY TAX MAP DEPARTMENT  
226 MIDDLE AVE. ELYRIA, OHIO

SURVEYED BY: XXXXXXXXXX  
CLOSURE: XXXXXX  
MAP PAGE(S): 3-F  
APPROVED BY: TJS DATE: 8/27/10  
SCALE: 1"= 100 PRIOR INST.: DV XXXX/XXX