
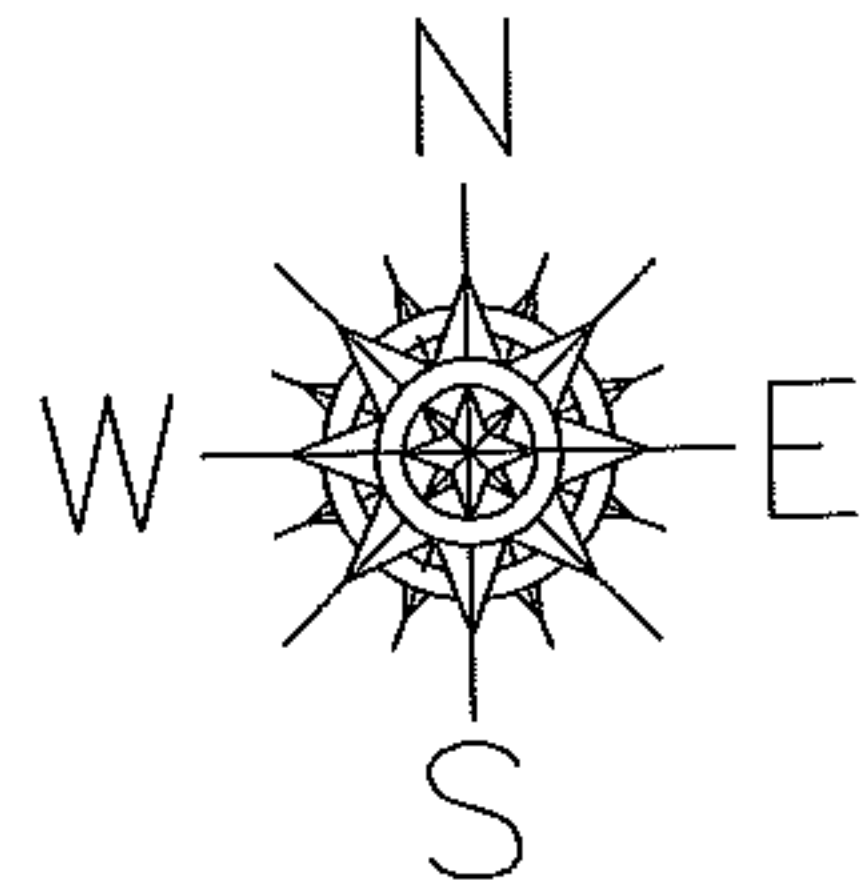


PARENT PARCEL: 04-00-019-104-012. -013
 CHILD PARCEL: 04-00-019-104-023 THRU -025
 STARTING POINT: CENTERLINE OF LAKE RD & NORTH POINT DR

06-02079

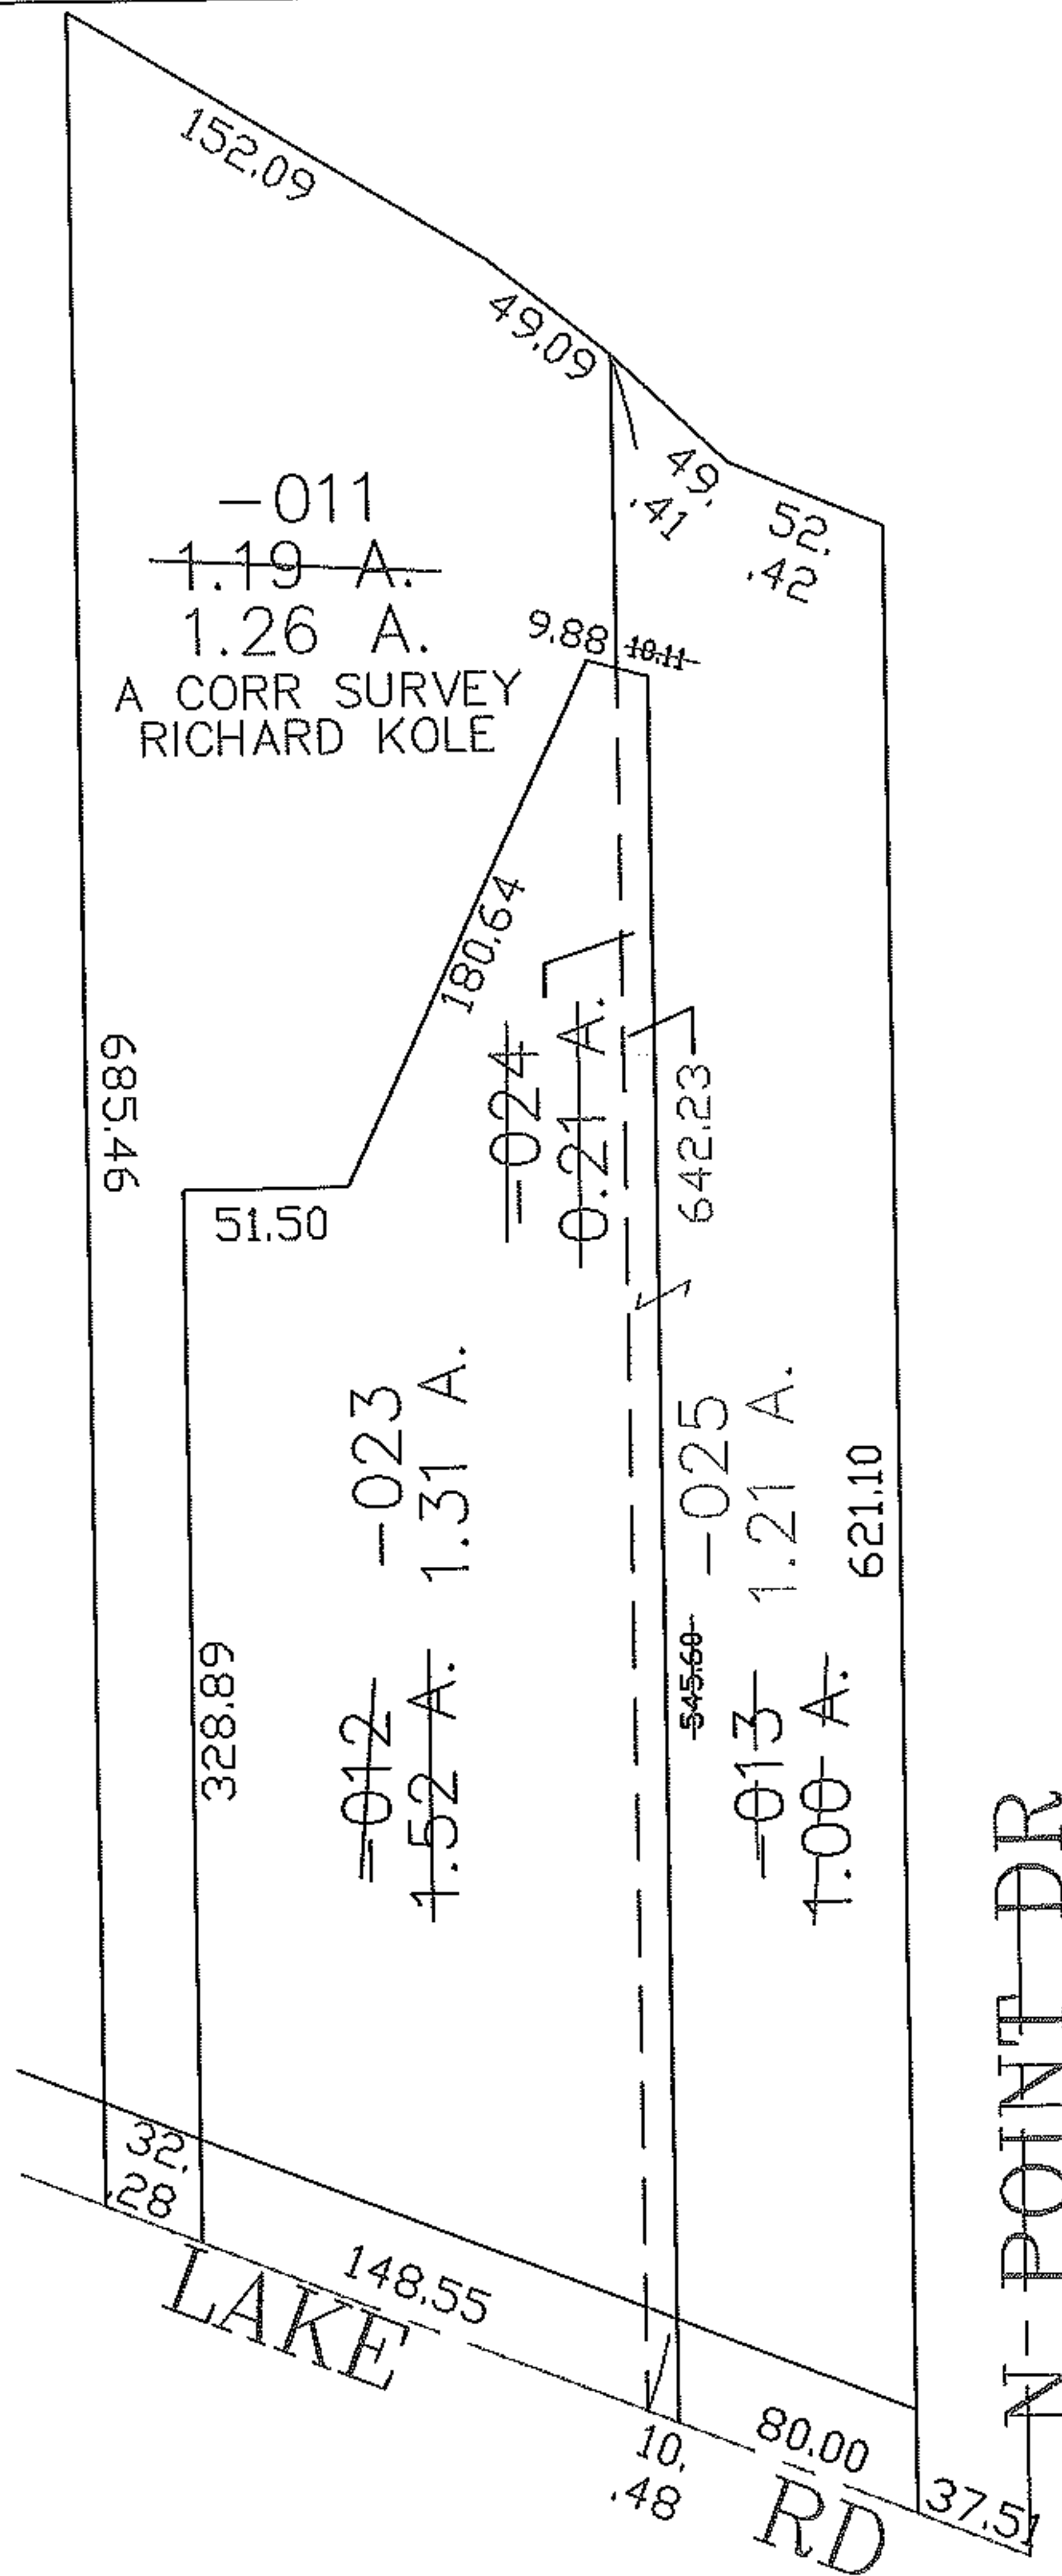

N-POINT DR

SPLITS/DEEDS PROCESSED

LORAIN COUNTY TAX MAP DEPARTMENT
 226 MIDDLE AVE. ELYRIA, OHIO

SURVEYED BY: RICHARD M KOLE
 CLOSURE: 0.00 : 10.000
 MAP PAGE(S): 04-00-019-D
 APPROVED BY: JAH DATE: 1-17-06
 SCALE: 1" = 100 PRIOR INSTRUMENT: 20050104256