
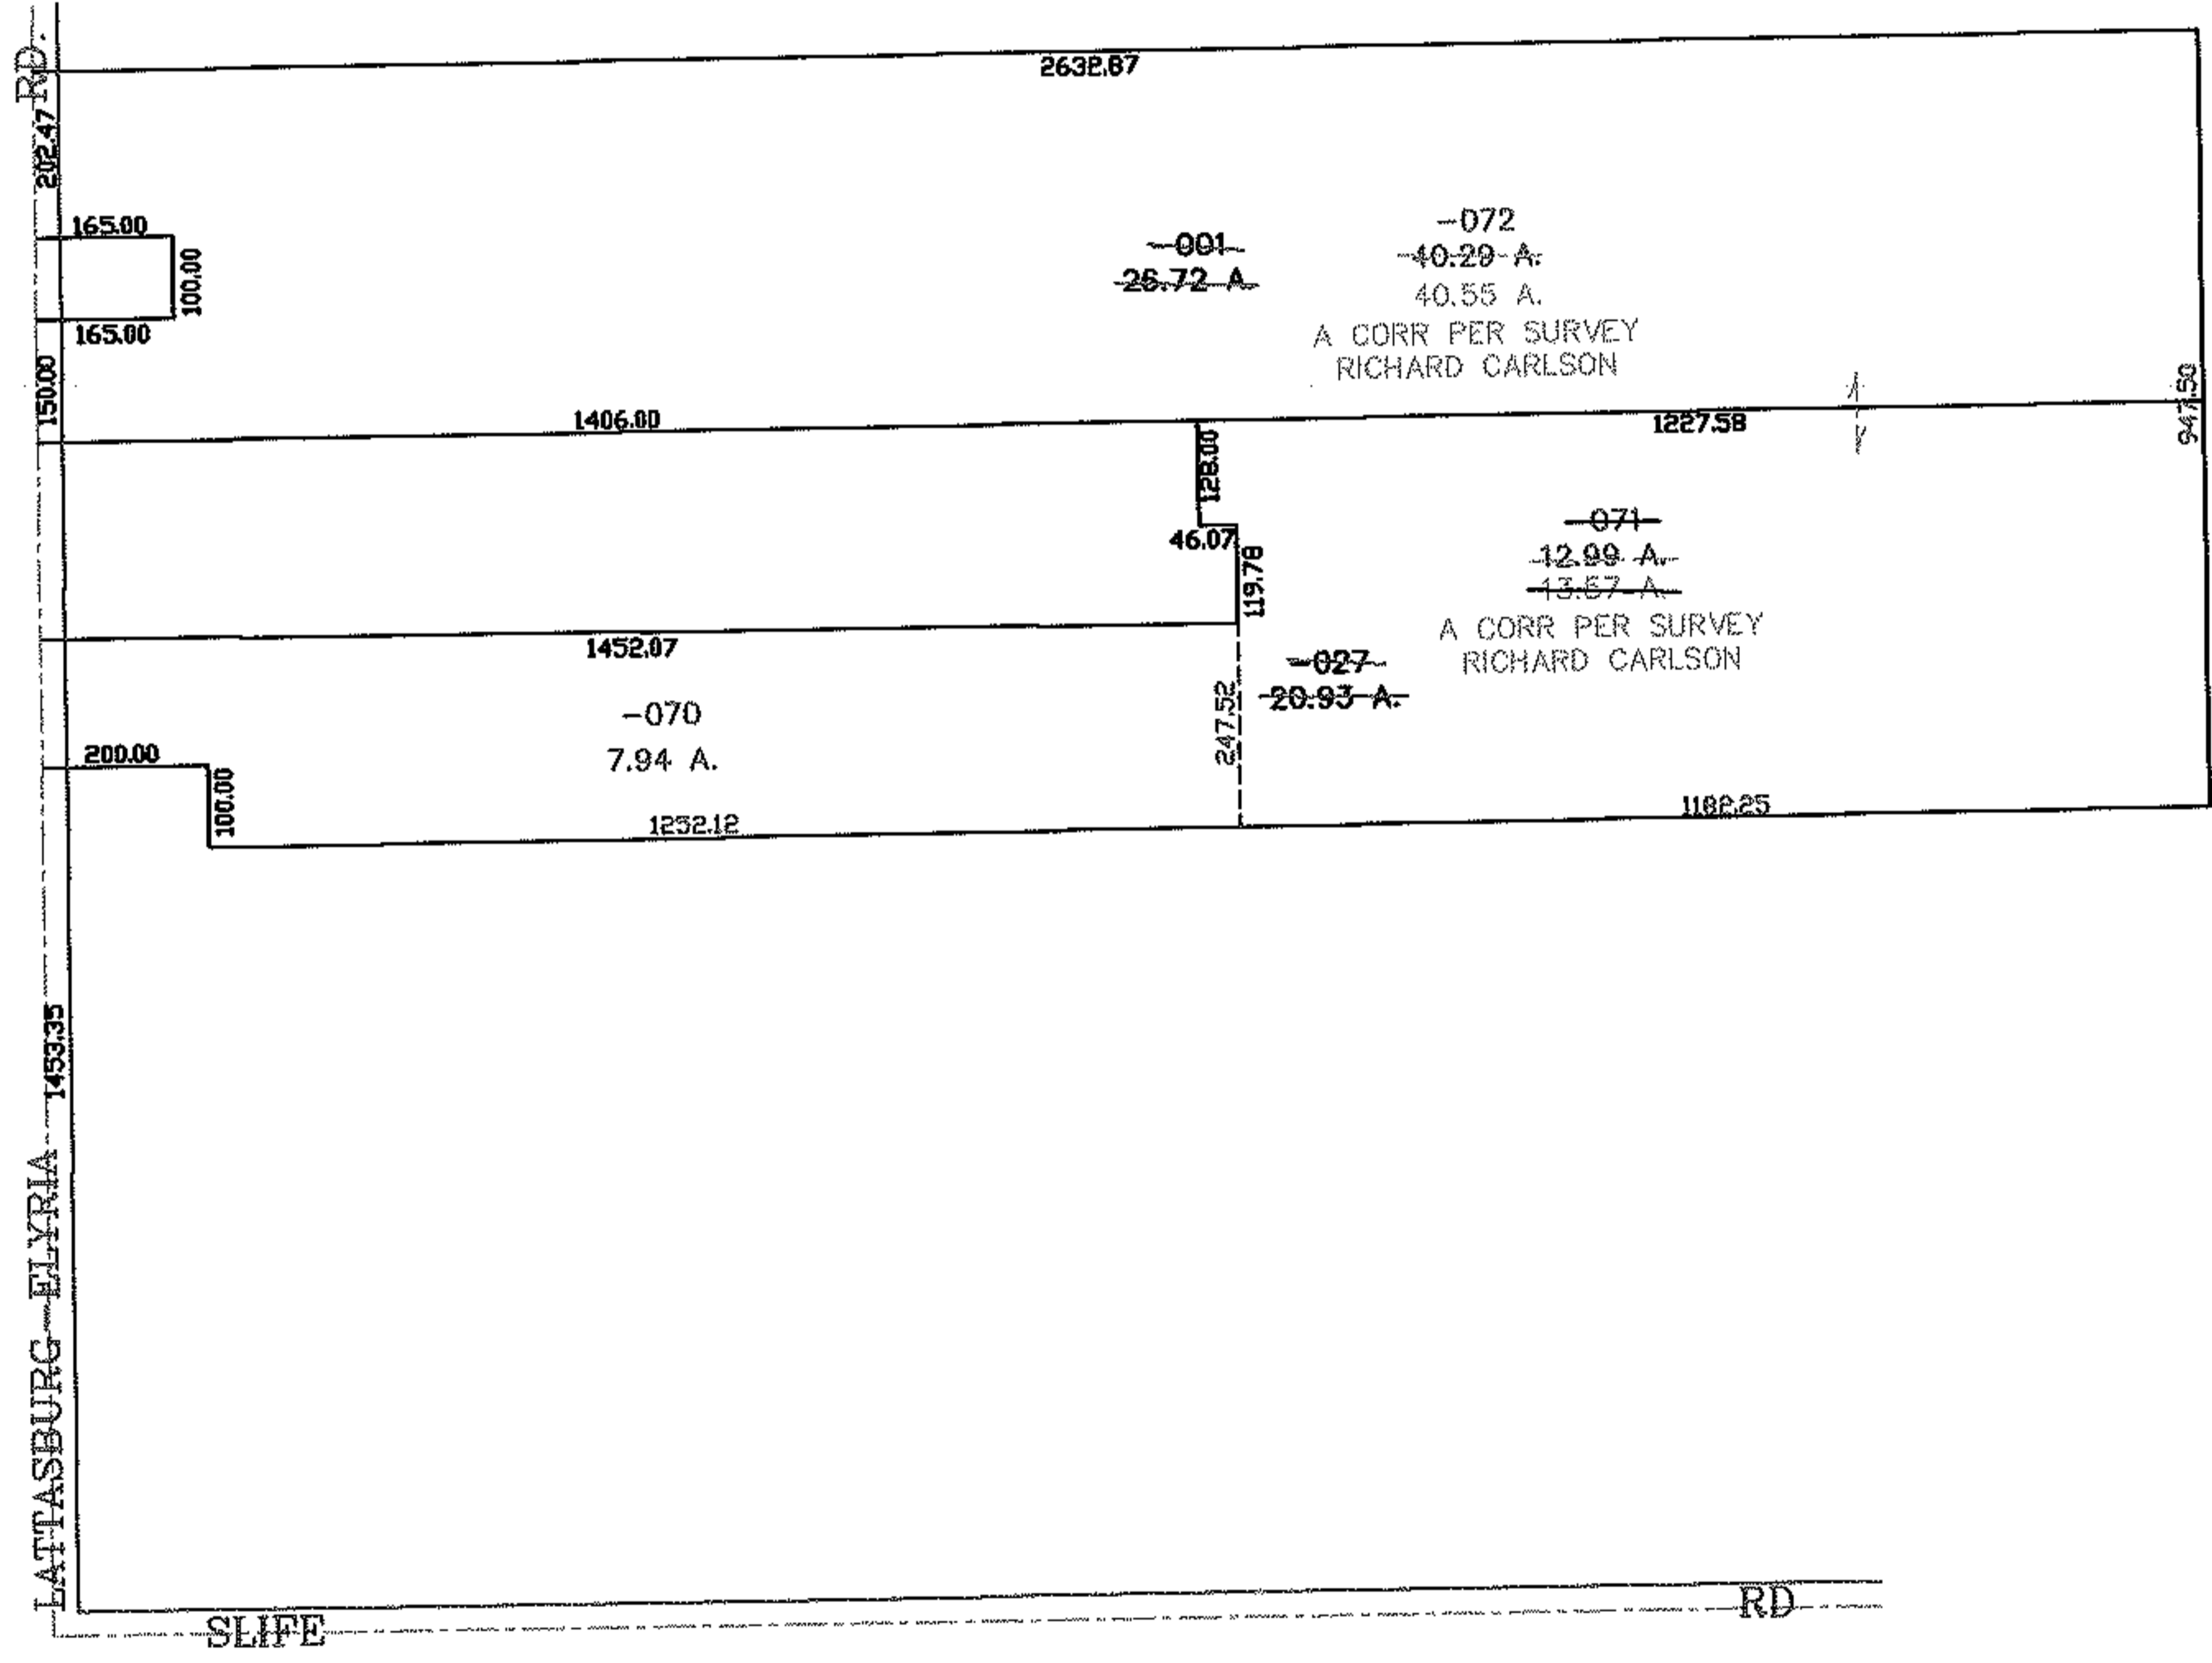


RASTER

PARENT PARCEL: 10-00-018-102-027, -001
CHILD PARCEL: 10-00-018-102-070 THRU -072
STARTING POINT: CENTERLINE OF SLIFE RD & LATTASBURG-ELYRIA RD

05-02083

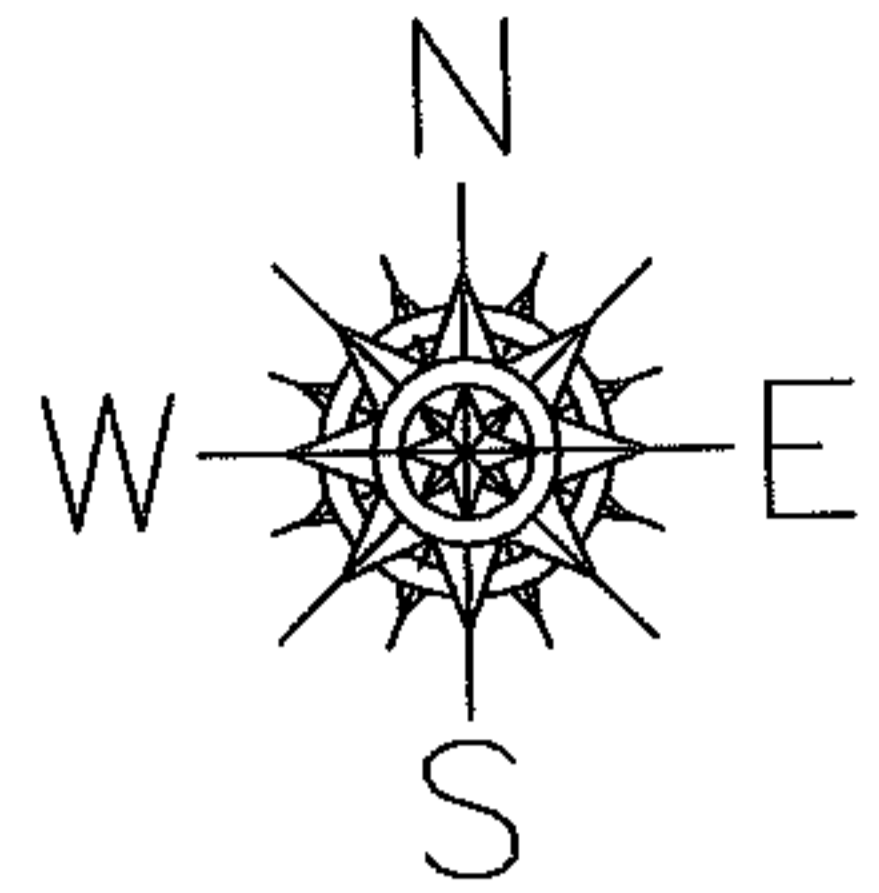

SPLITS/DEEDS PROCESSED
LORAIN COUNTY TAX MAP DEPARTMENT
226 MIDDLE AVE. ELYRIA, OHIO

SURVEYED BY: RICHARD CARLSON
CLOSURE: 0.00 : 10.000
MAP PAGE(S): 10-00-018-D
APPROVED BY: JAH DATE: 1-19-06
SCALE: 1" = 400 PRIOR INSTRUMENT: 20060120497