



RASTER

PARENT PARCEL: 04-00-015-109-060  
CHILD PARCEL: XX-XX-XXX-XXX-XXX  
STARTING POINT: MON. BOX, CL OF DETROIT RD. & CL OF CENTER RD.

10-02086-C

DIMENSION CORRECTION

04-00-015-109-060  
0.55 A.

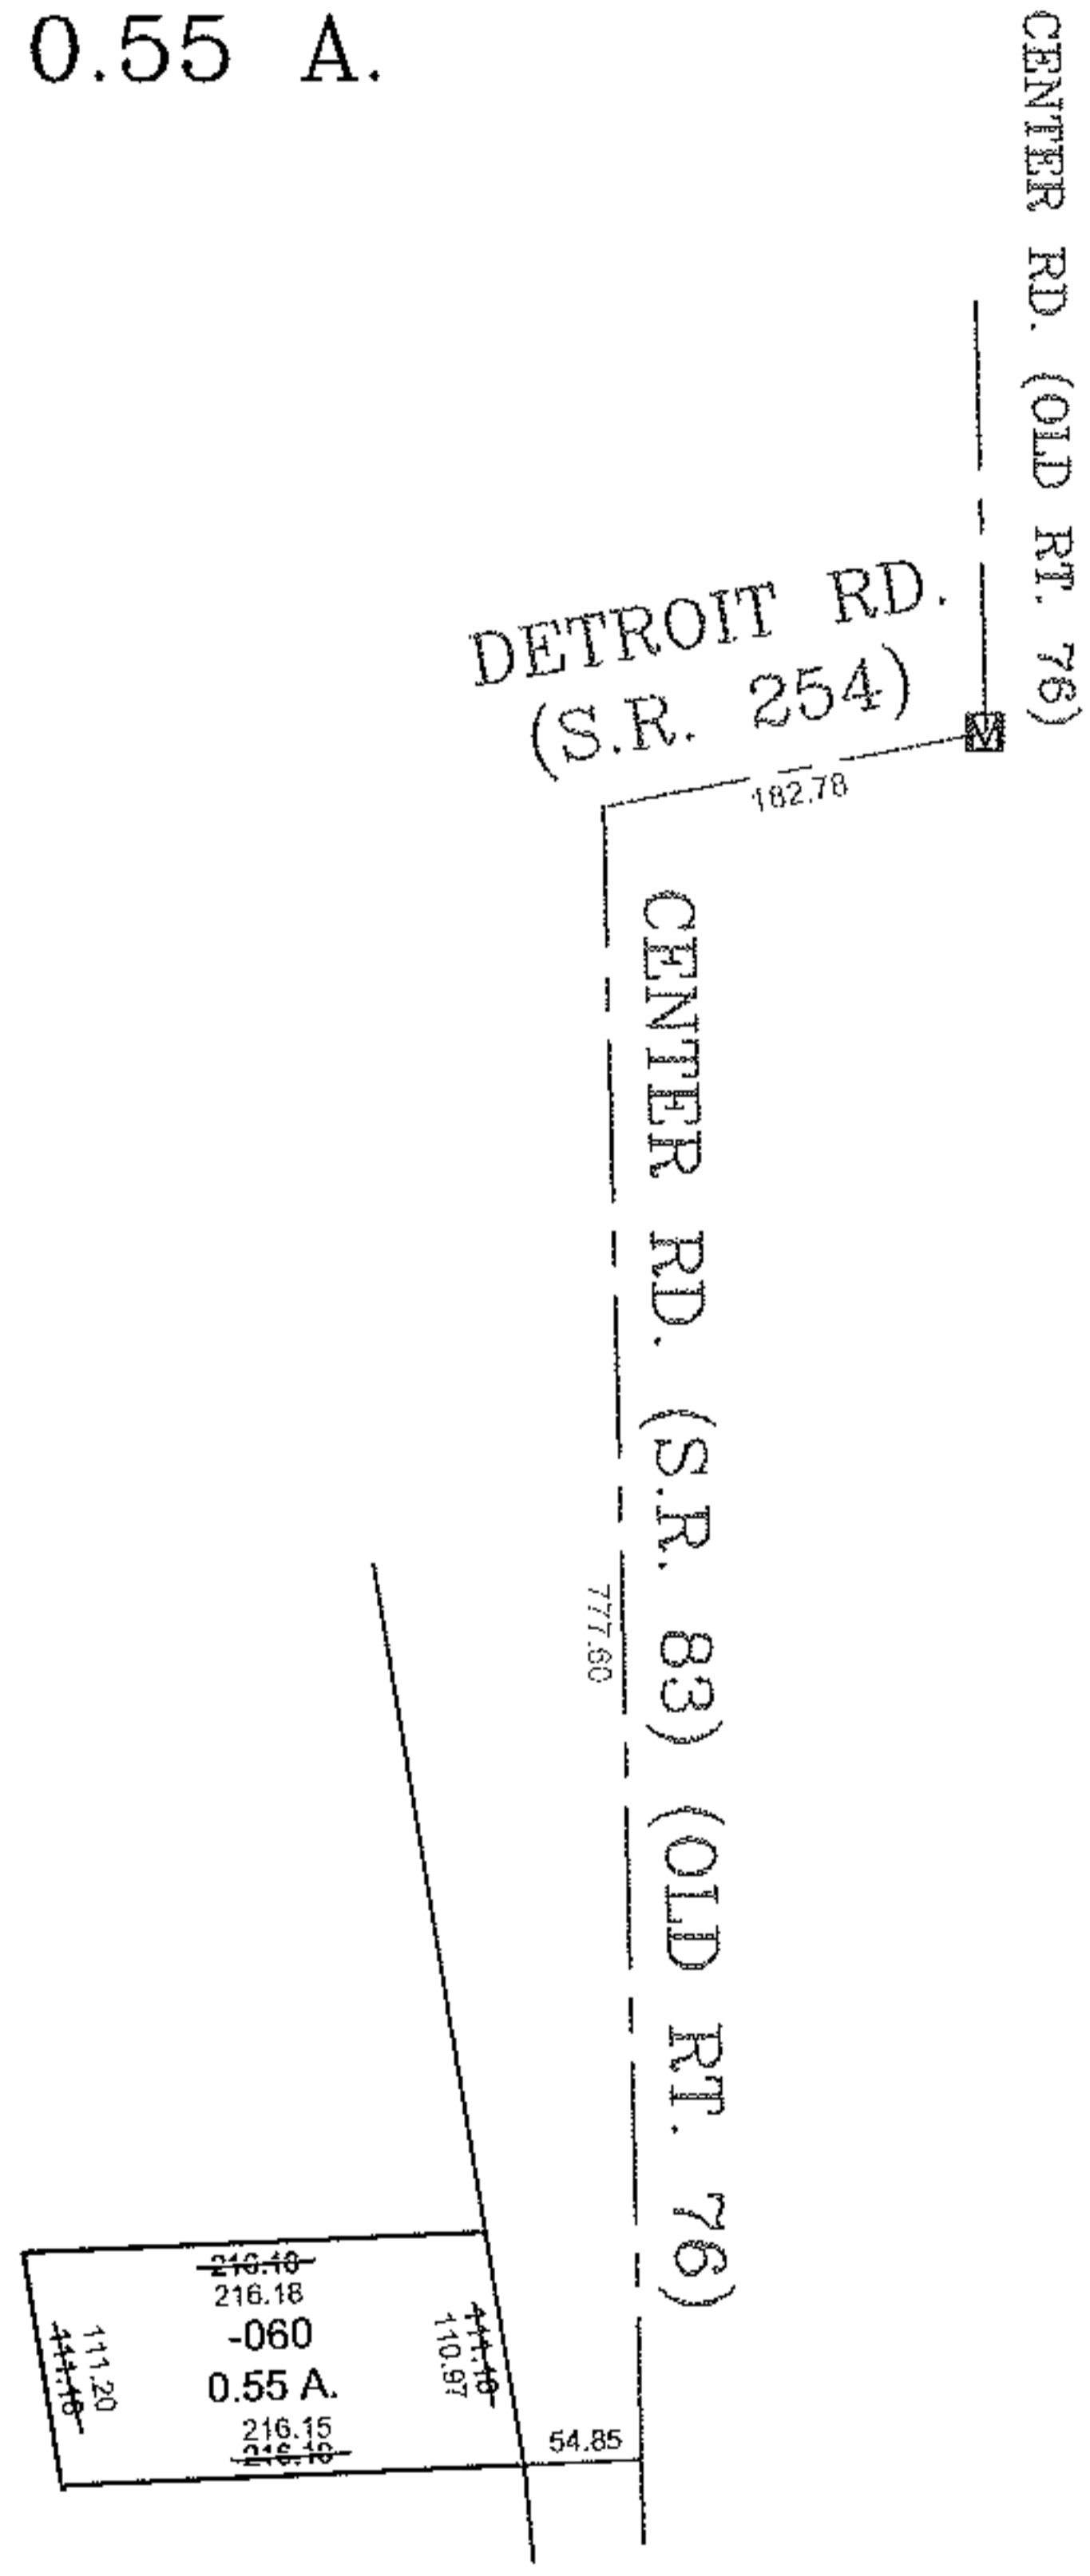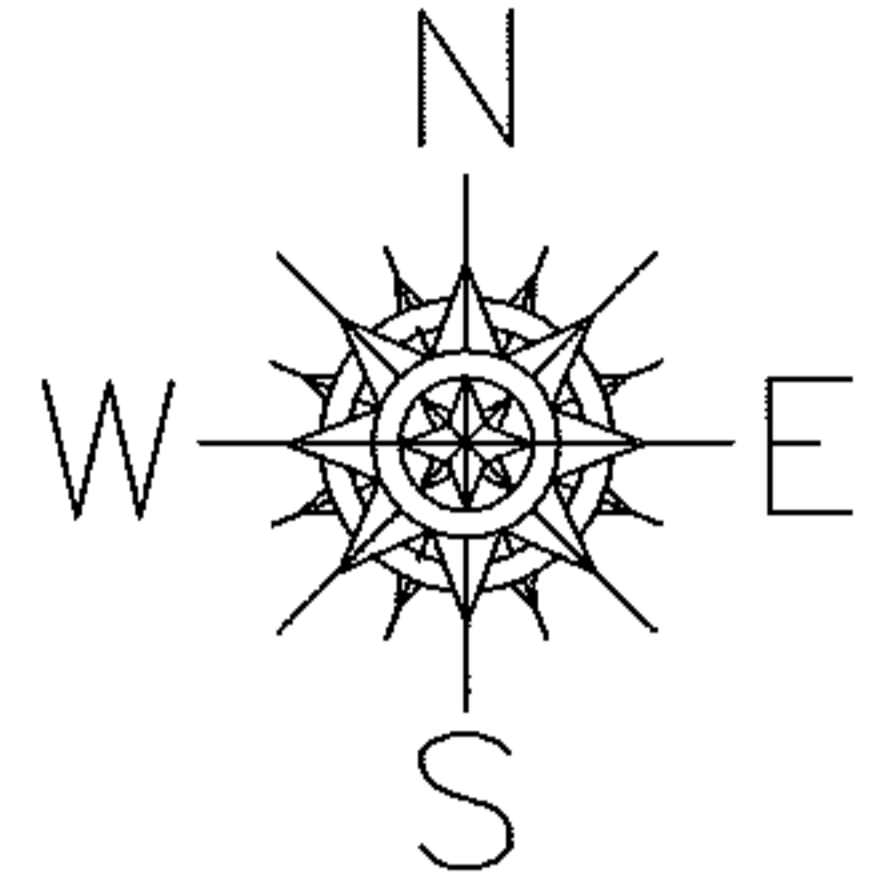

SPLITS/DEEDS PROCESSED

LORAIN COUNTY TAX MAP DEPARTMENT  
226 MIDDLE AVE. ELYRIA, OHIO

SURVEYED BY: JAME T. SAYLER  
CLOSURE: 0.01 : 10,000  
MAP PAGE(S): 4-00-015-B  
APPROVED BY: TJS DATE: 9/7/10  
SCALE: 1"= 200 PRIOR INST.: 20080250127