




RASTER

PARENT PARCEL: 11-00-080-000-011

CHILD PARCEL: 11-00-080-000-079, -080

STARTING POINT: CENTERLINE OF DURKEE RD & O.L. 80

06-02086

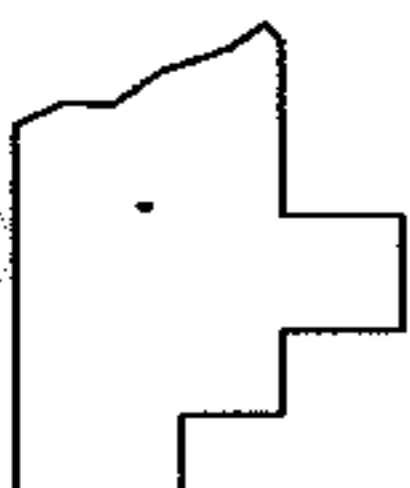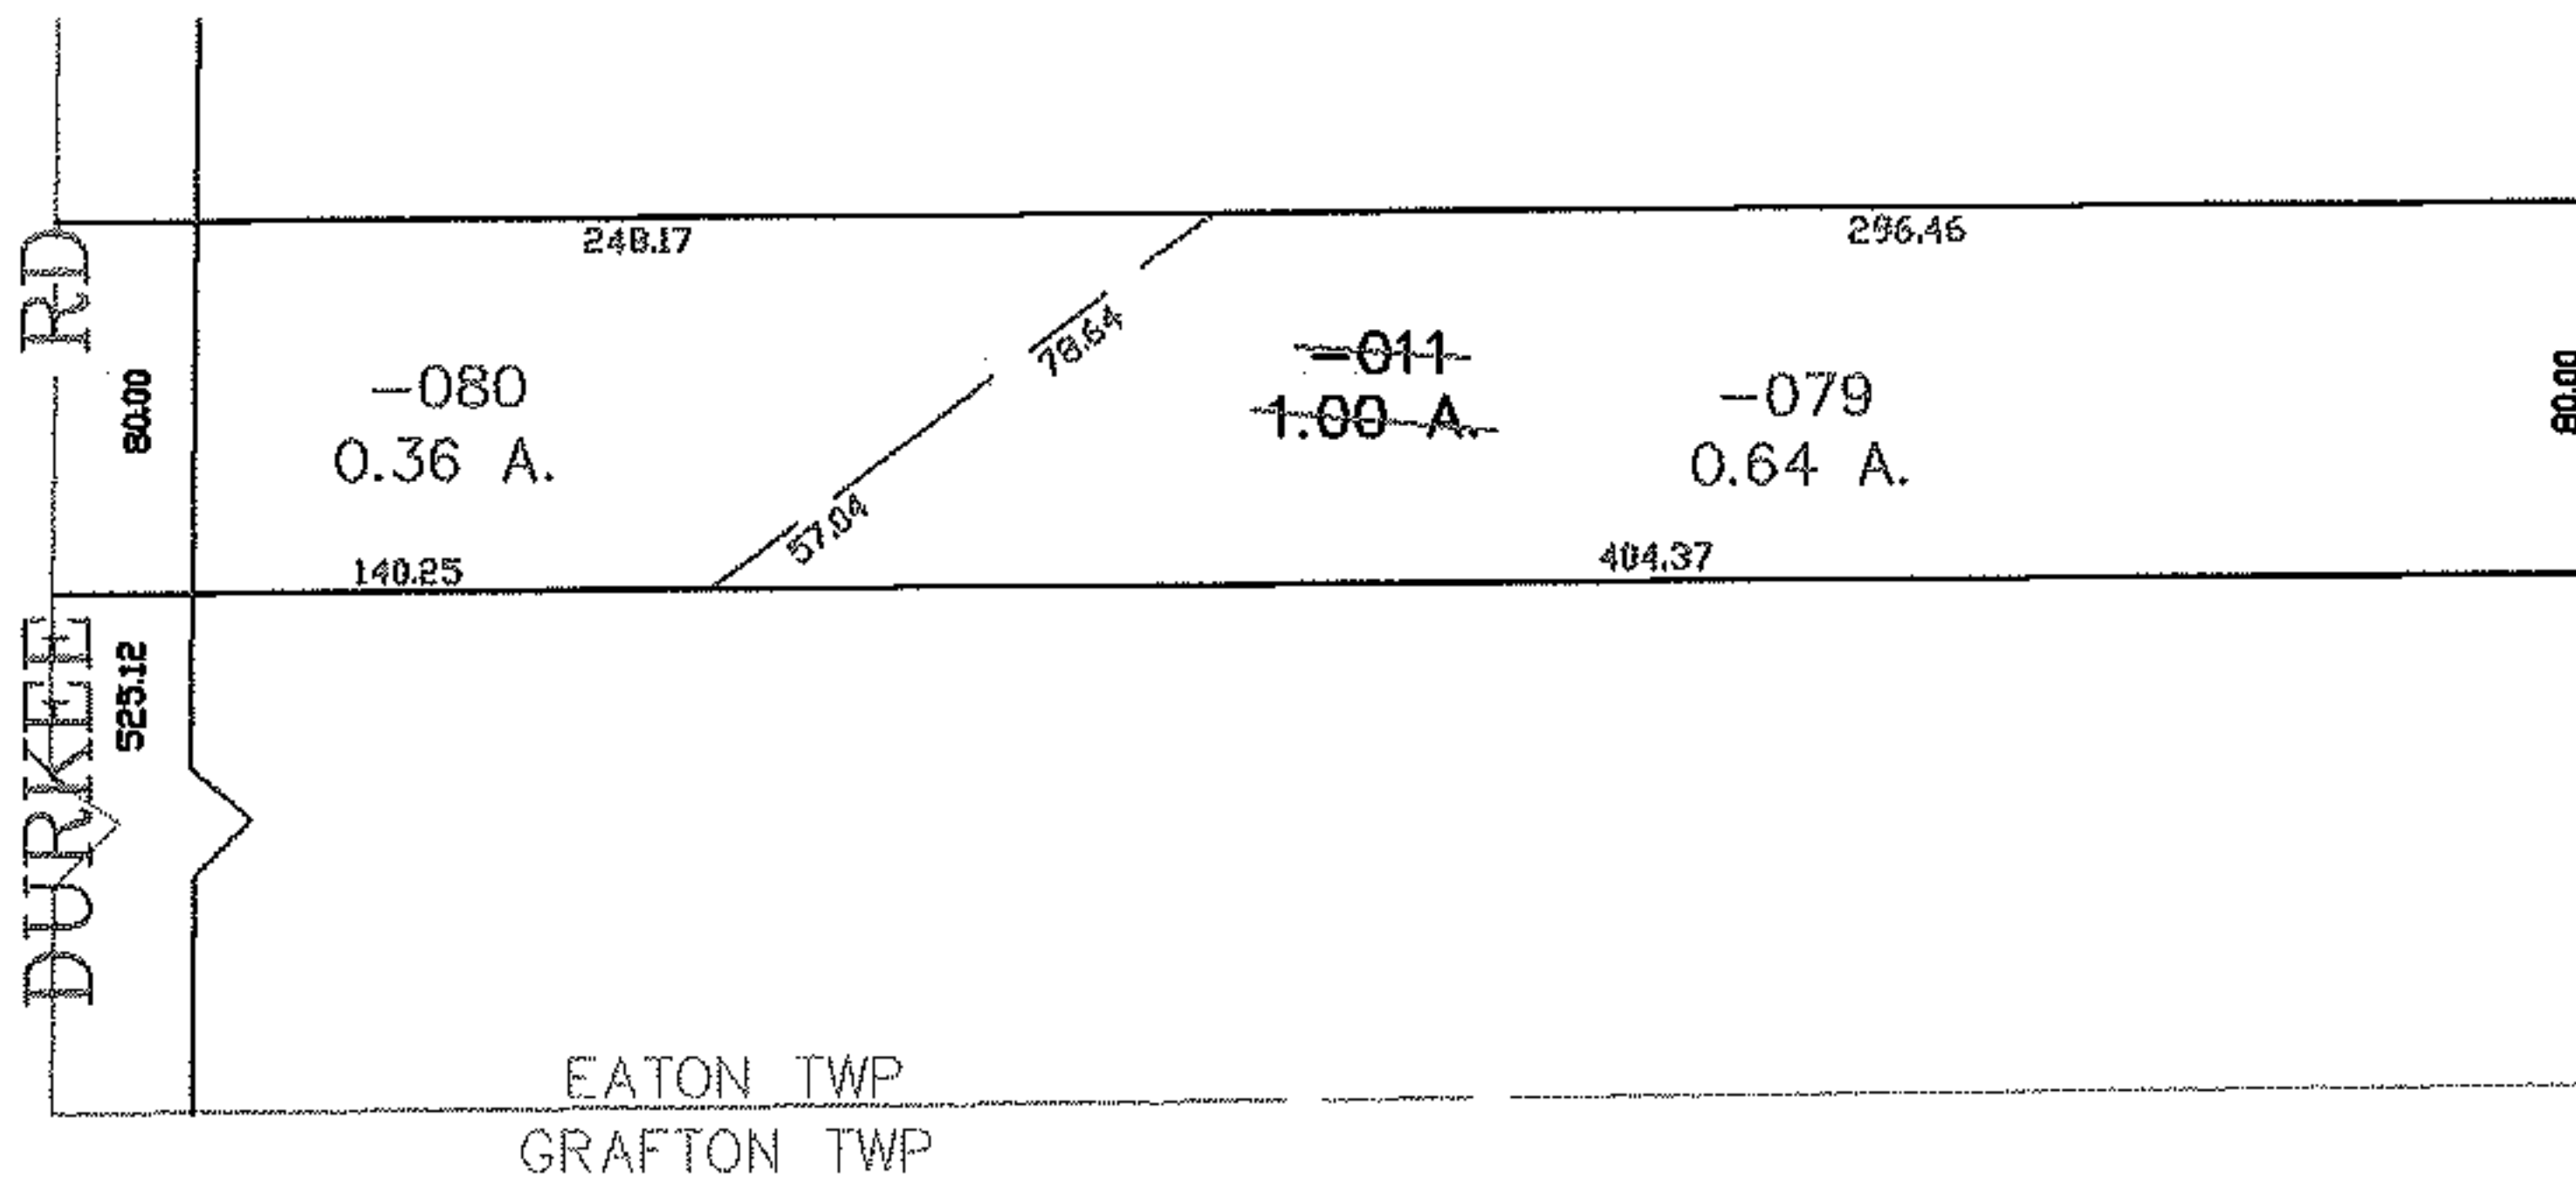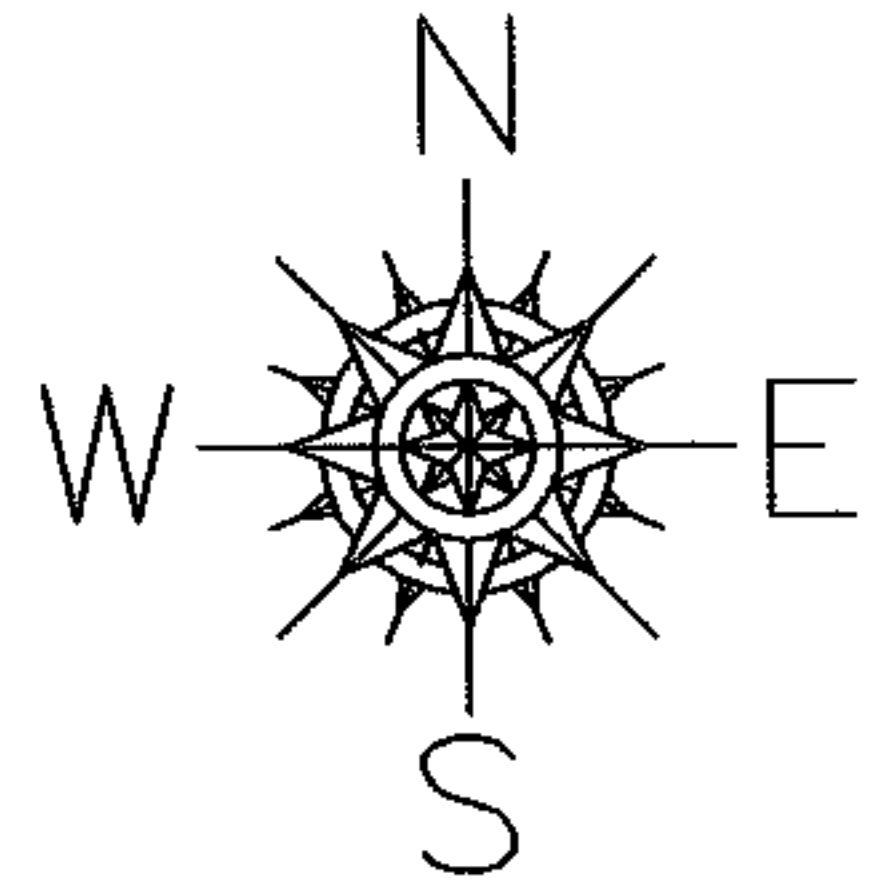

**SPLITS/DEEDS PROCESSED**

LORAIN COUNTY TAX MAP DEPARTMENT  
226 MIDDLE AVE. ELYRIA, OHIO

SURVEYED BY: OHIO DEP OF TRANS  
 CLOSURE: 0.00 : 10.000  
 MAP PAGE(S): 11-00-080-A  
 APPROVED BY: JAH DATE: 1-25-06  
 SCALE: 1" = 100 PRIOR INSTRUMENT: 20050078719