
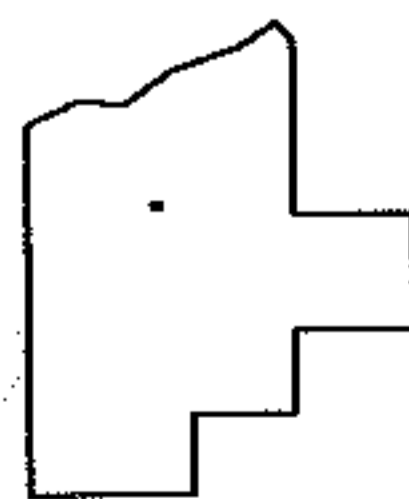
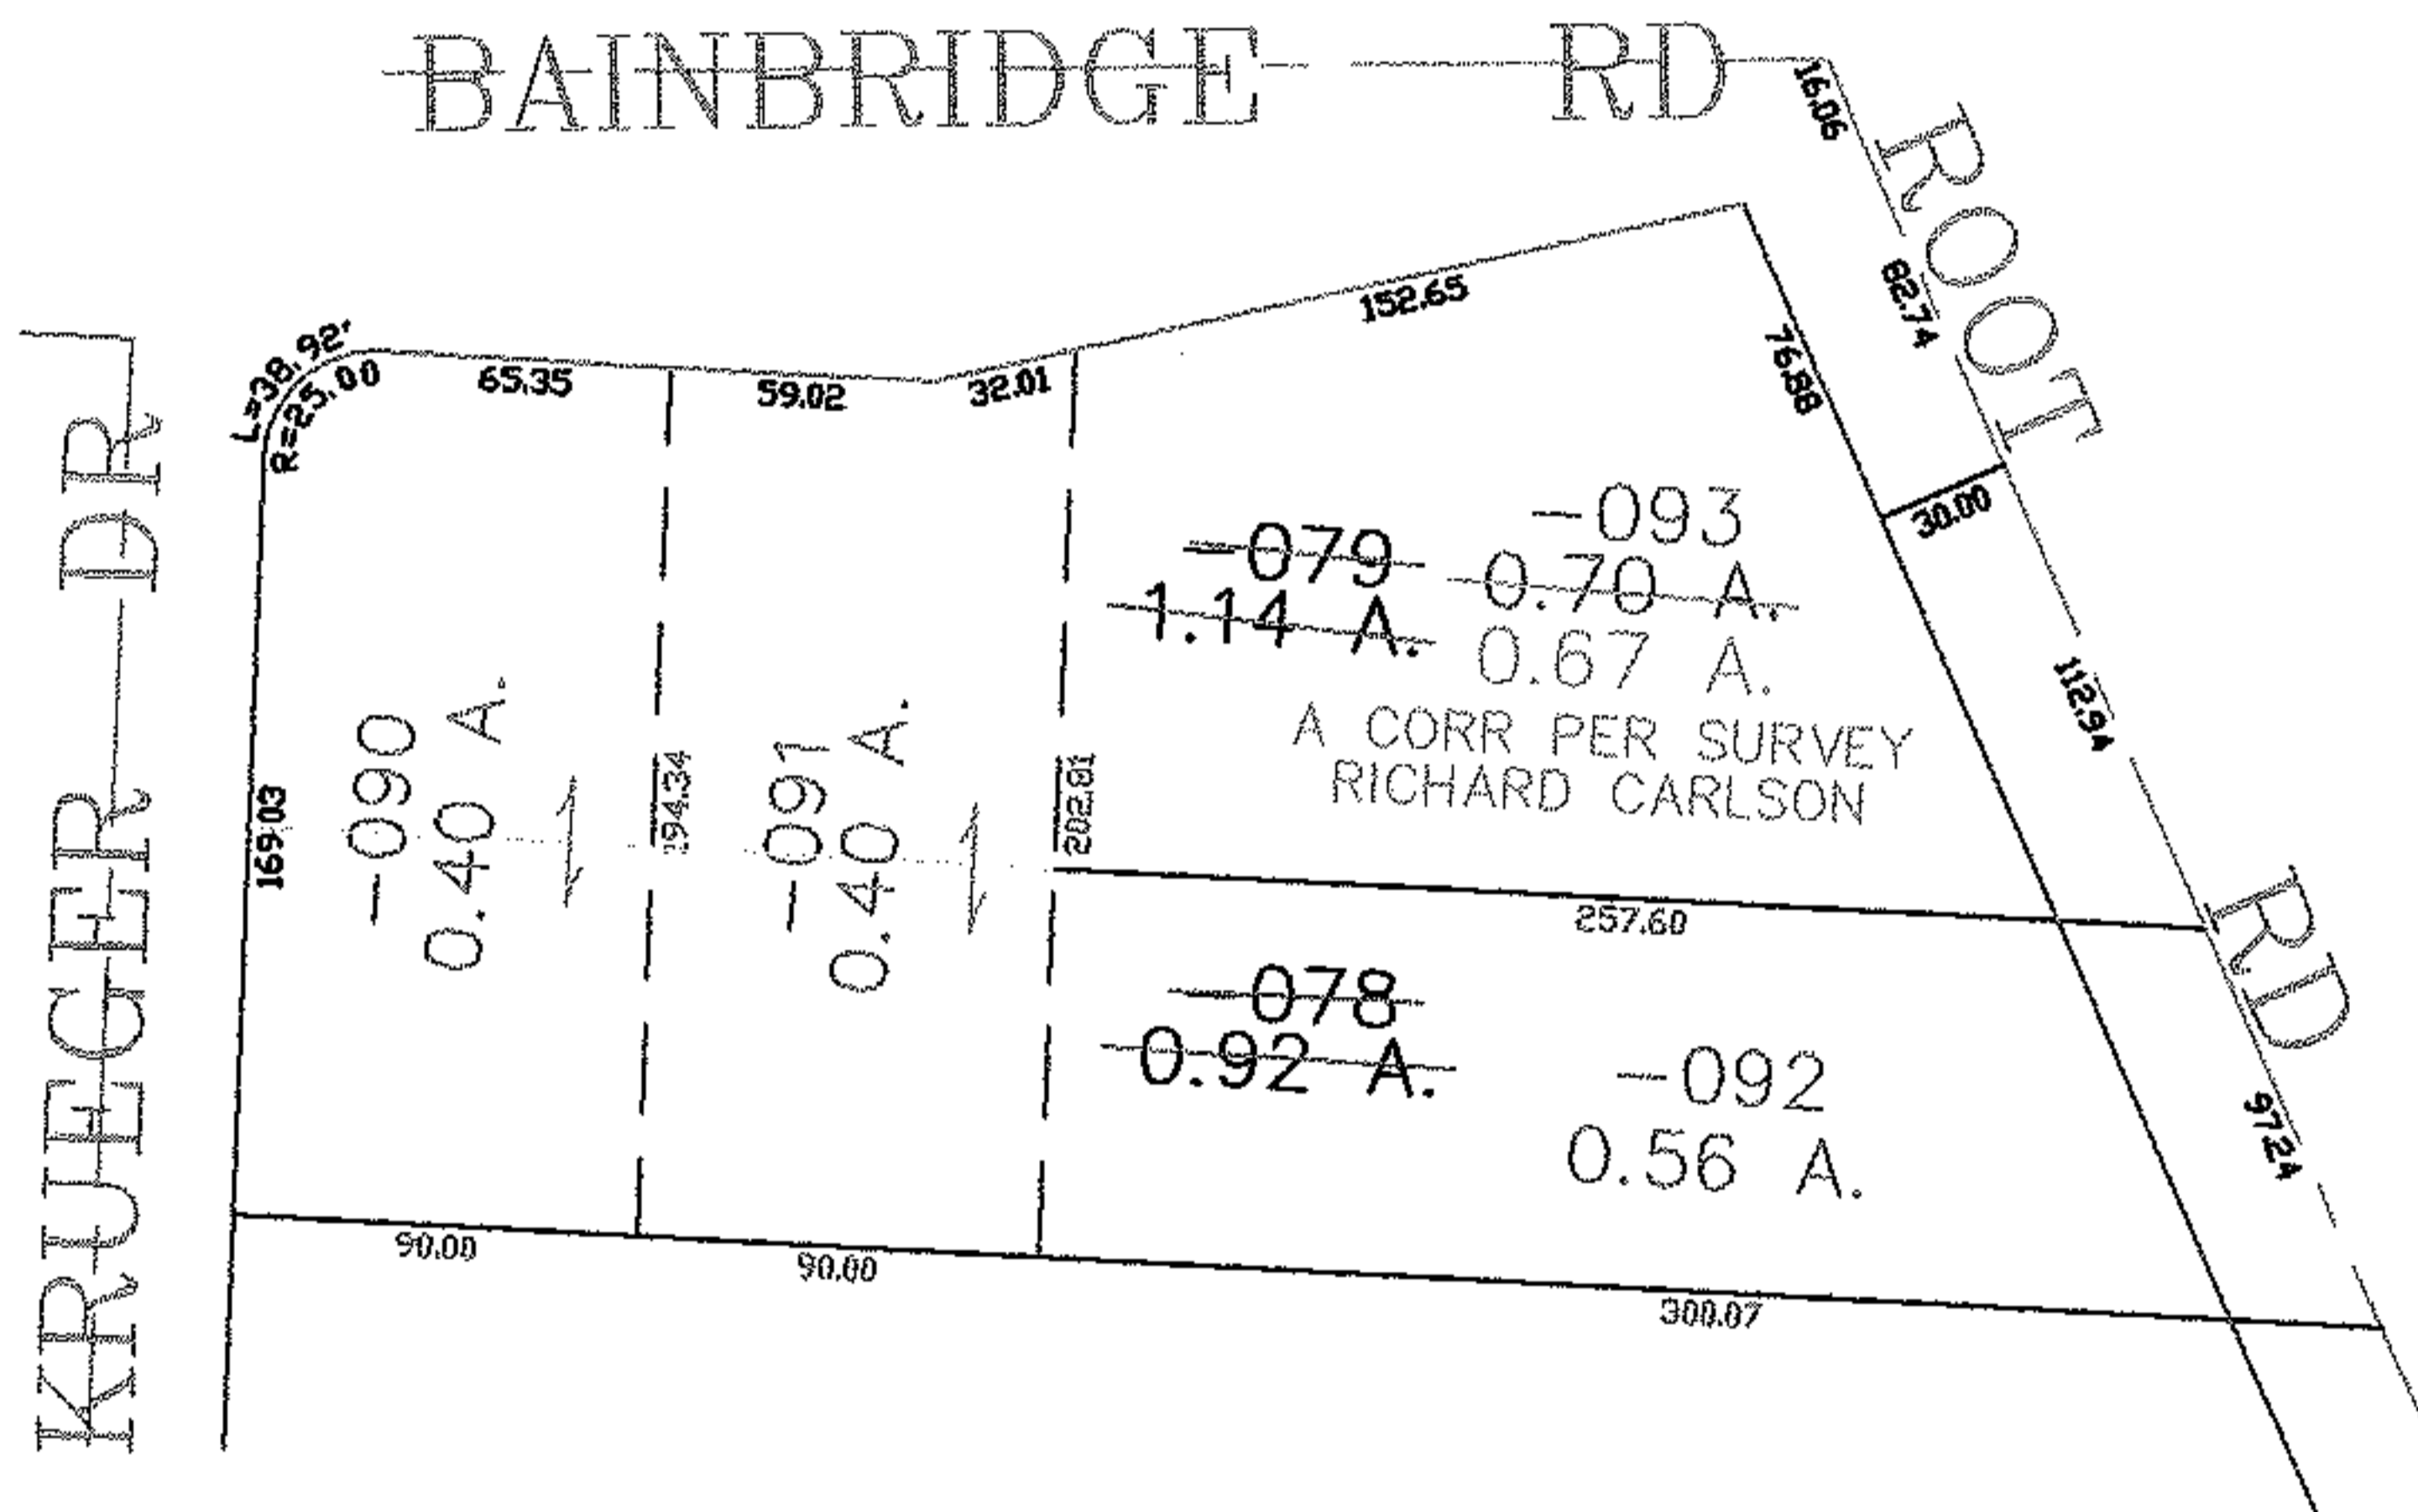


PARENT PARCEL: 07-00-022-101-078, -079

CHILD PARCEL: 07-00-022-101-090 THRU -093

STARTING POINT: CENTERLINE OF ROOT RD & BAINBRIDGE RD

06-02088

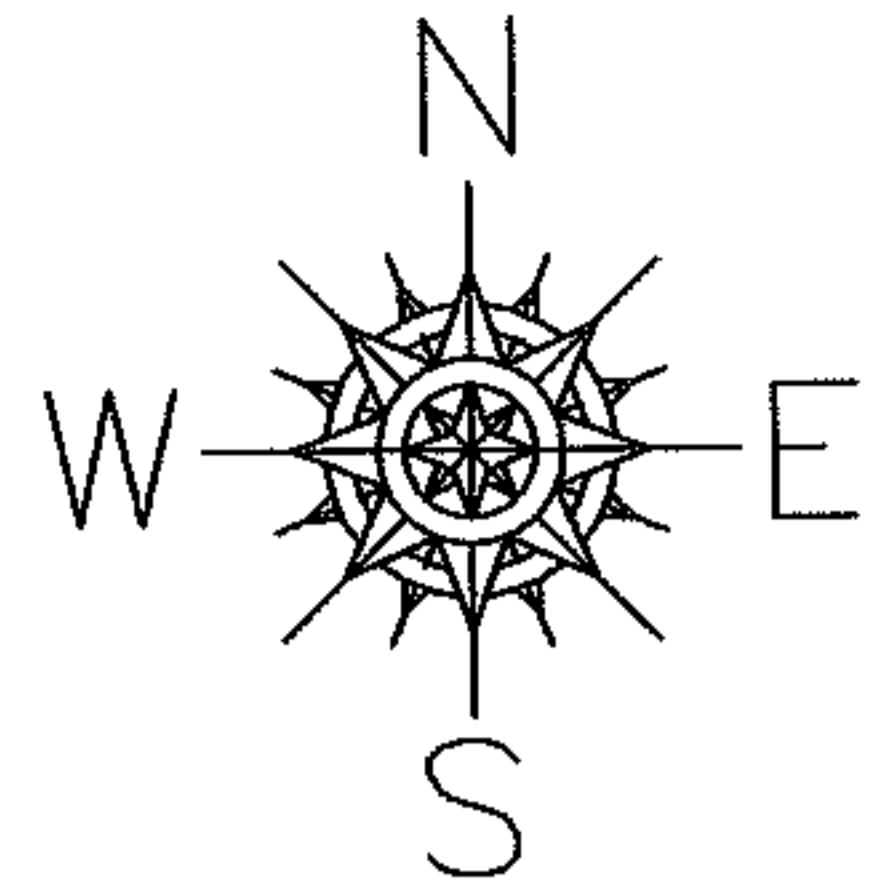

SPLITS/DEEDS PROCESSED

LORAIN COUNTY TAX MAP DEPARTMENT
226 MIDDLE AVE. ELYRIA, OHIO

SURVEYED BY: RICHARD CARLSON
 CLOSURE: 0.00 : 10.000
 MAP PAGE(S): 07-00-022-B
 APPROVED BY: JAH DATE: 1-26-06
 SCALE: 1" = 100 PRIOR INSTRUMENT: 20000668303