


PAGE 1

PARENT PARCEL: 06-26-008-102-004


10-02089-C

CHILD PARCEL: _____

STARTING POINT: PART OF S/L 11 IN FISHER, HURST AND CARTER'S ADD.(VOL.2 PG.19)

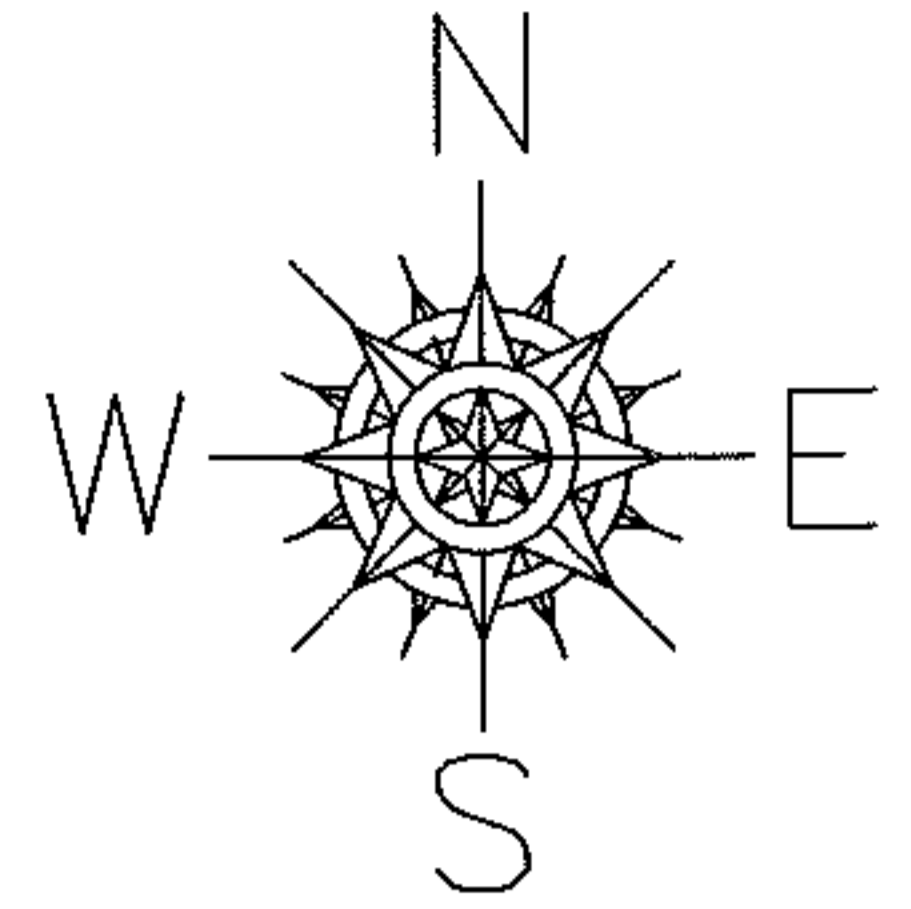

12TH ST.

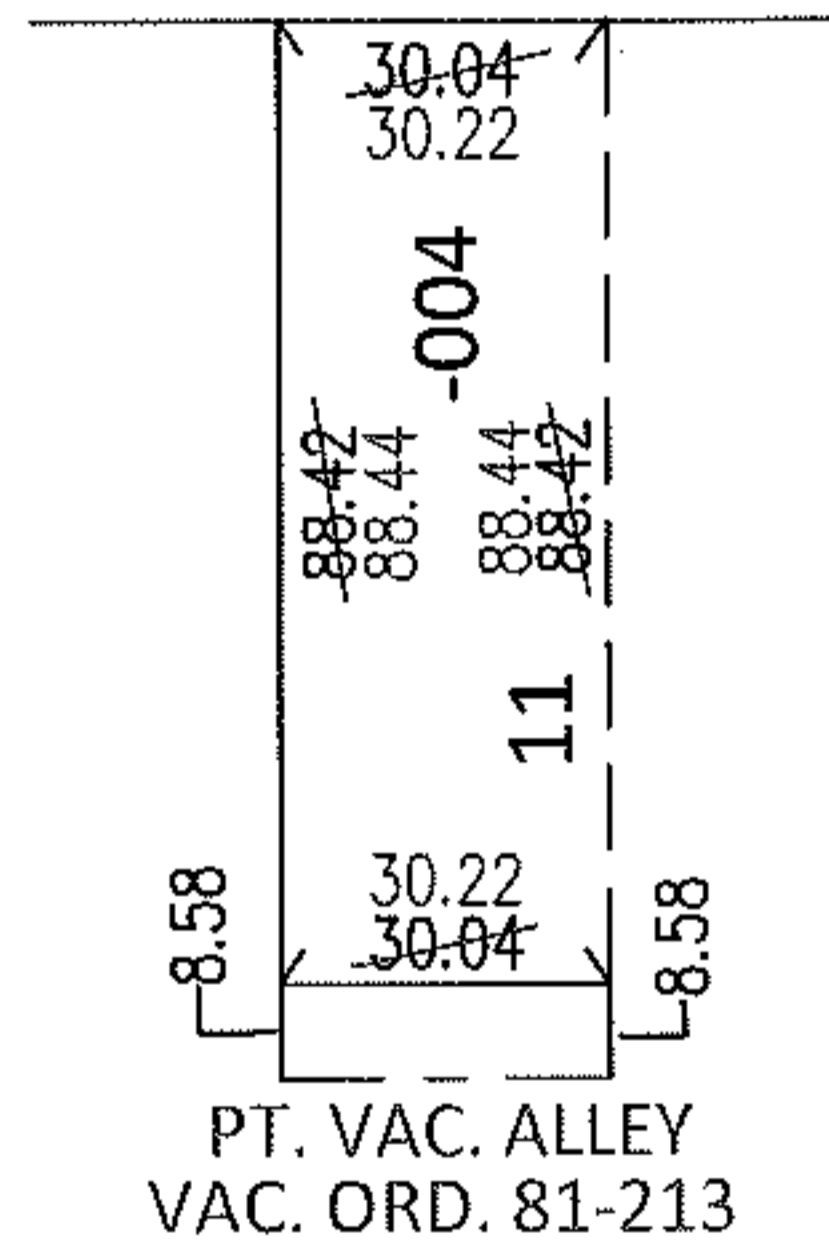

FRONTAGE AND DEPTH CORRECTION

06-26-008-102-004

30.22 X 97.02

~~30.04 X 96.57~~


PER COURT CASE NO. 10TX006231
AND PRIOR DEEDS

980574517

990616019

20020859373

20020864681

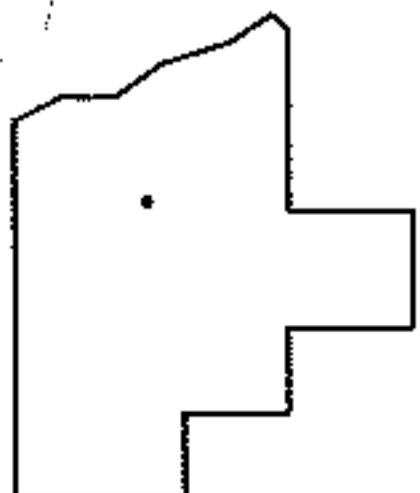

SPLITS/DEEDS PROCESSED

LORAIN COUNTY TAX MAP DEPARTMENT
226 MIDDLE AVE. ELYRIA, OHIO

SURVEYED BY: N/A

CLOSURE: N/A

MAP PAGE(S): 6-137

APPROVED BY: RRM DATE: 9-8-10

SCALE: 1" = 50' PRIOR INST.: SEE ABOVE