




RASTER

PARENT PARCEL: 07-00-041-000-048, -049, -055

CHILD PARCEL: CENTERLINE OF OTTEN RD & BARRES RD

STARTING POINT: 07-00-00-041-000-062

06-02090

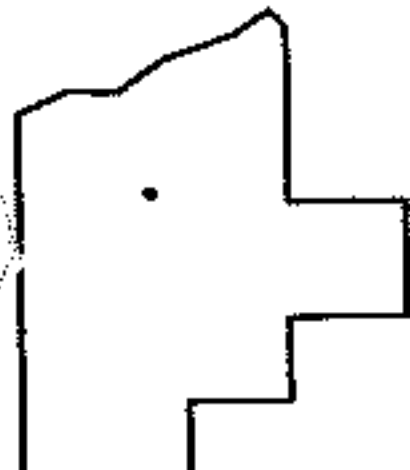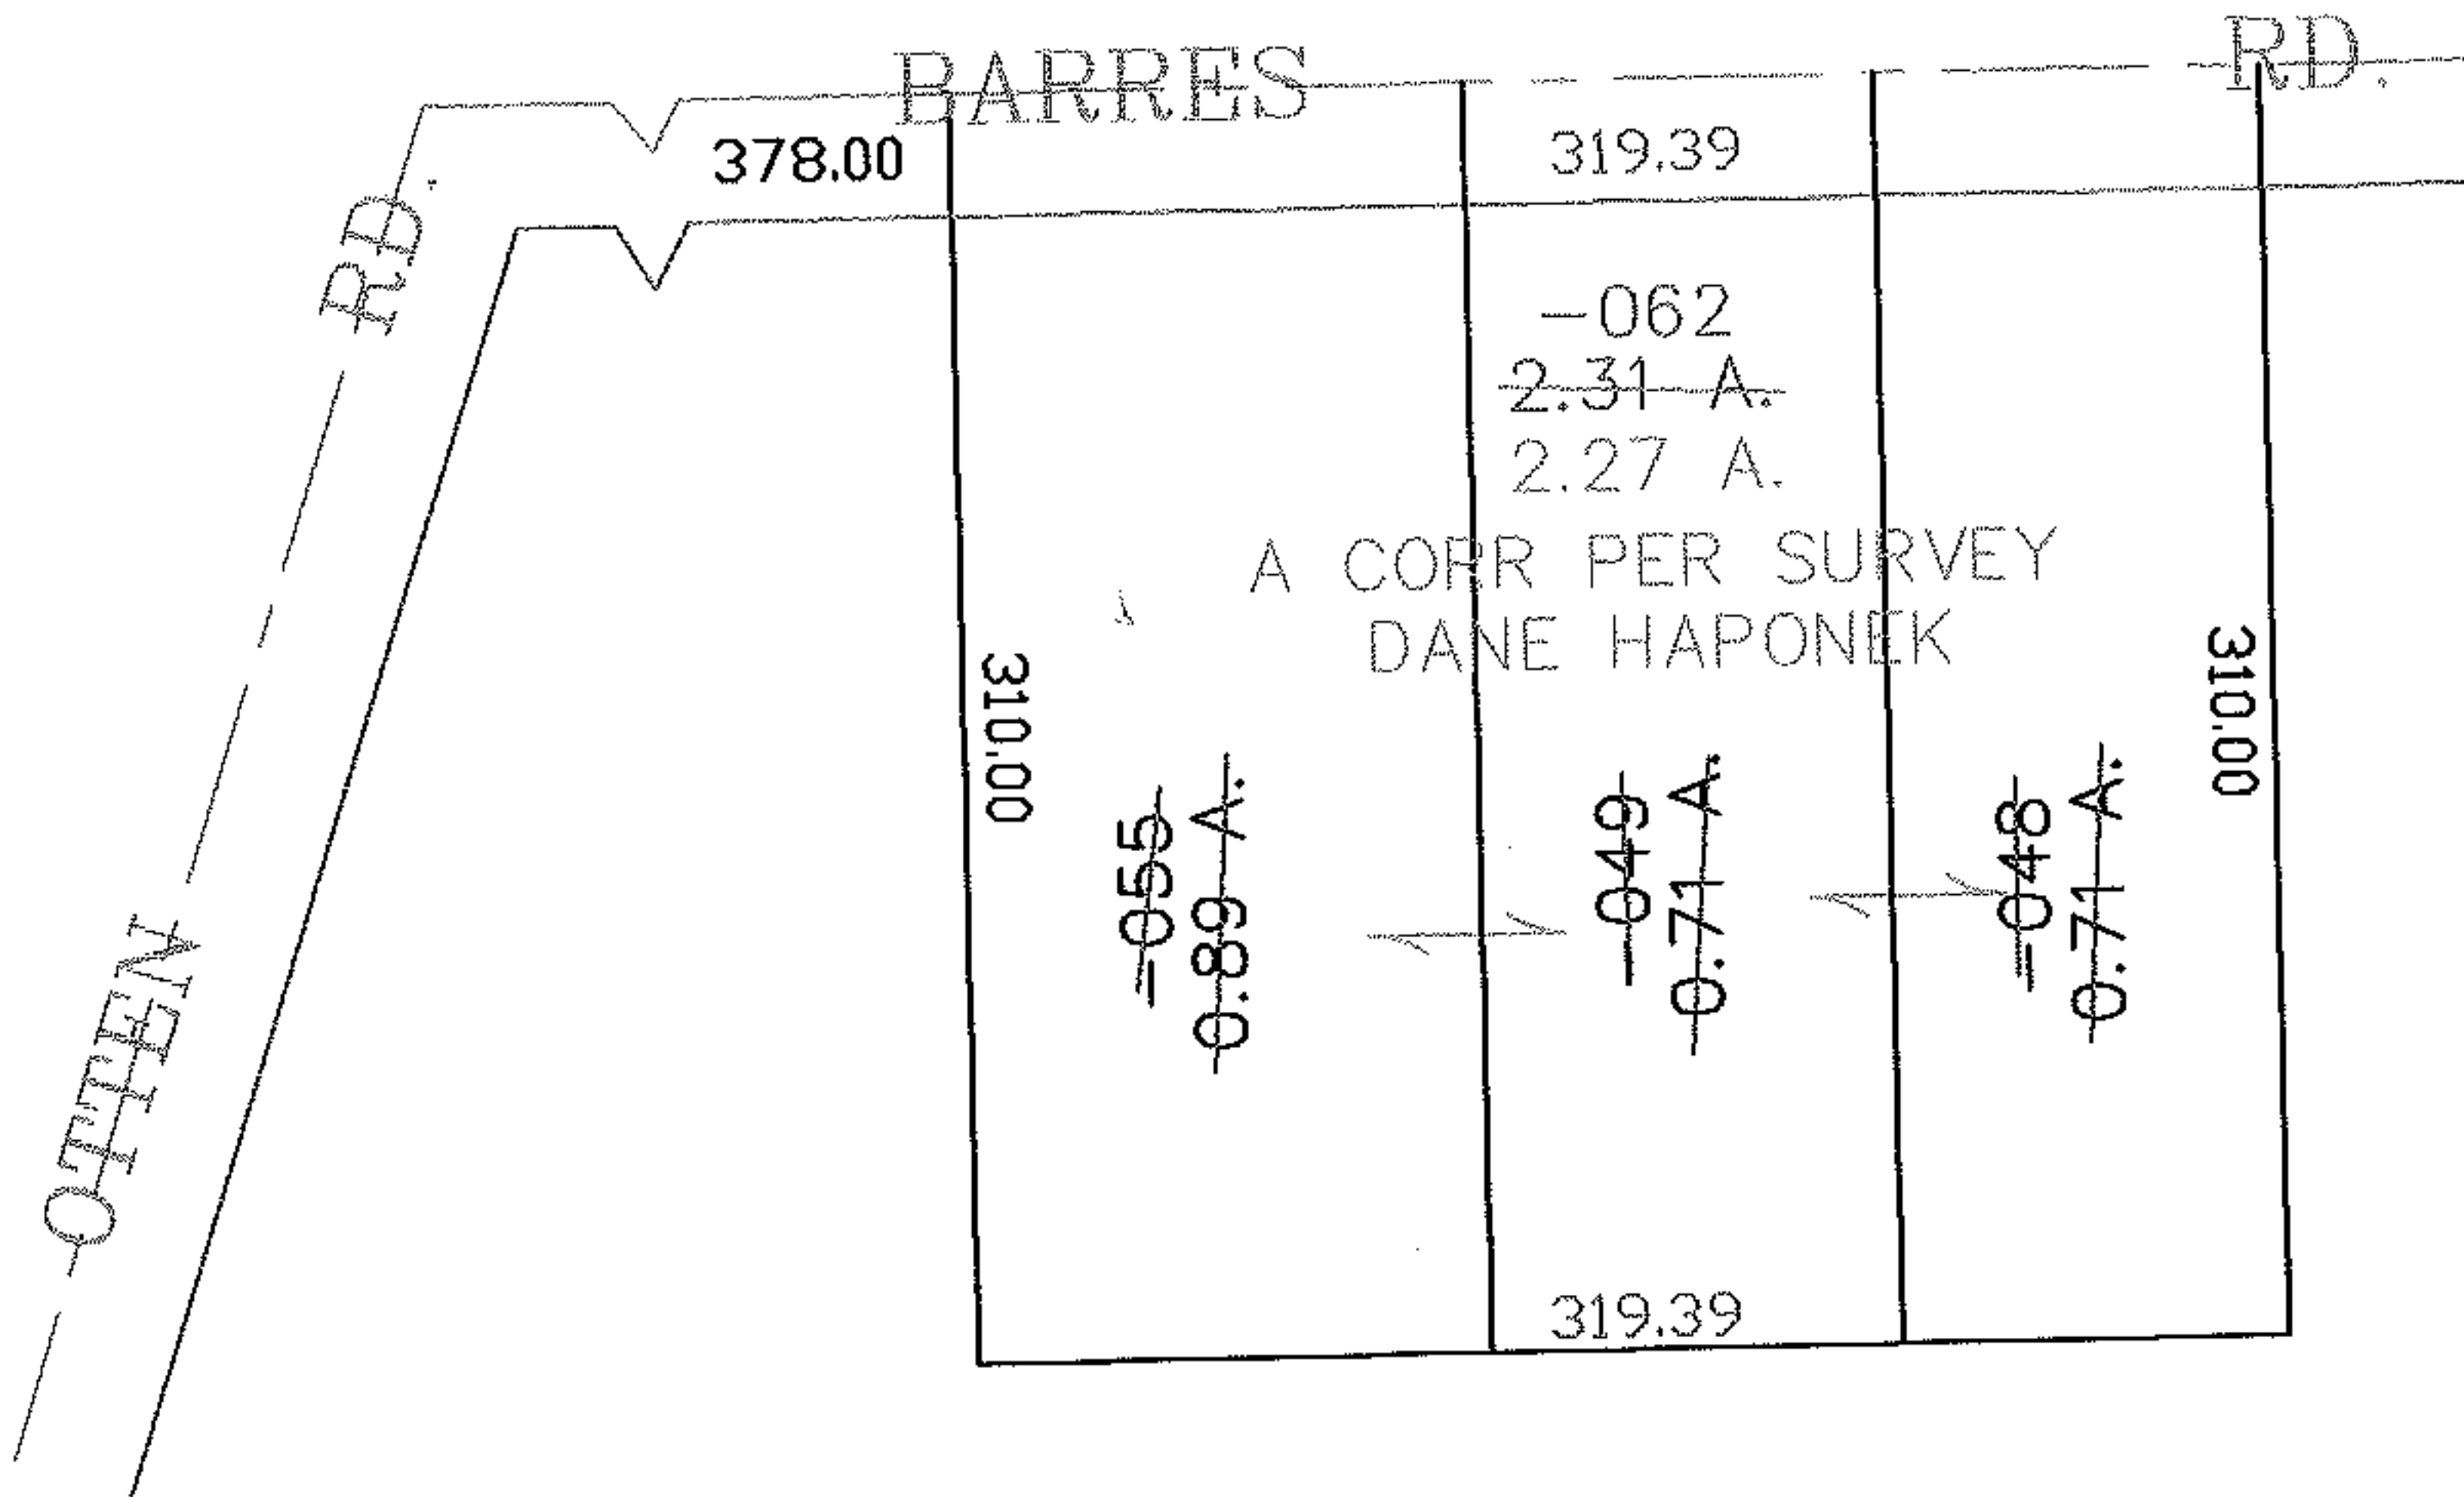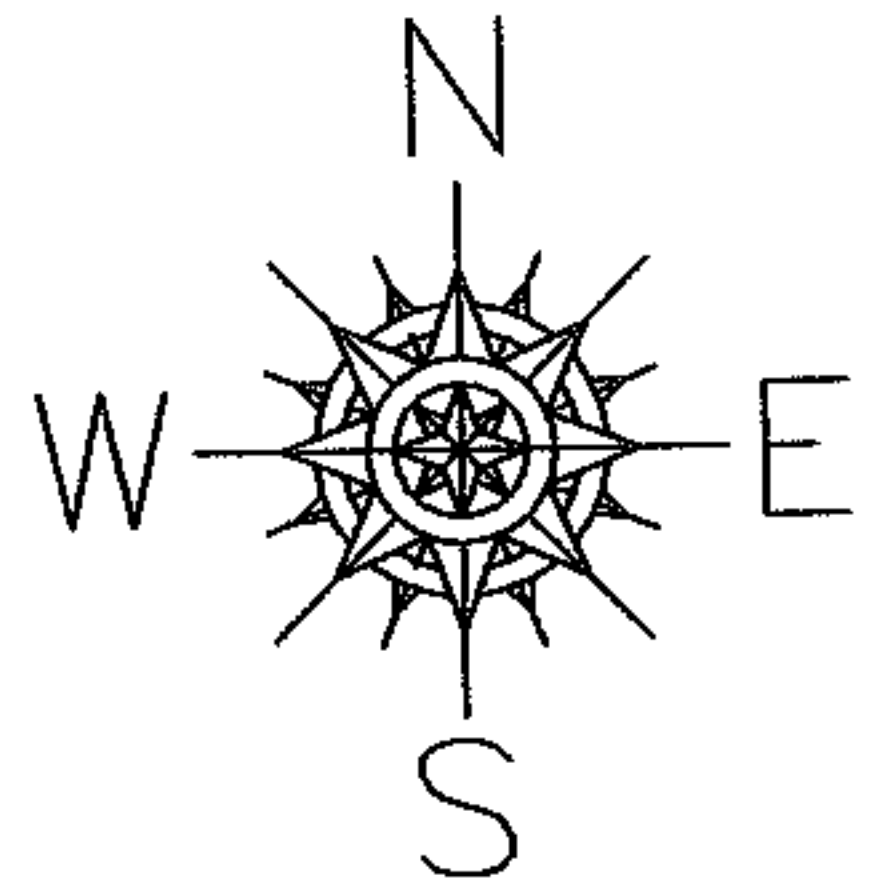

SPLITS/DEEDS PROCESSED

LORAIN COUNTY TAX MAP DEPARTMENT  
226 MIDDLE AVE. ELYRIA, OHIO

SURVEYED BY: DANE HAPONEK

CLOSURE: 0.00 : 10,000

MAP PAGE(S): 7-A

APPROVED BY: JAH DATE: 1-30-06

SCALE: 1" = 100 PRIOR INSTRUMENT: 20010793592